


PROFILE - AMANDE COURT
SCALE: VERT. 1"=2'
HORIZ. 1"=50'

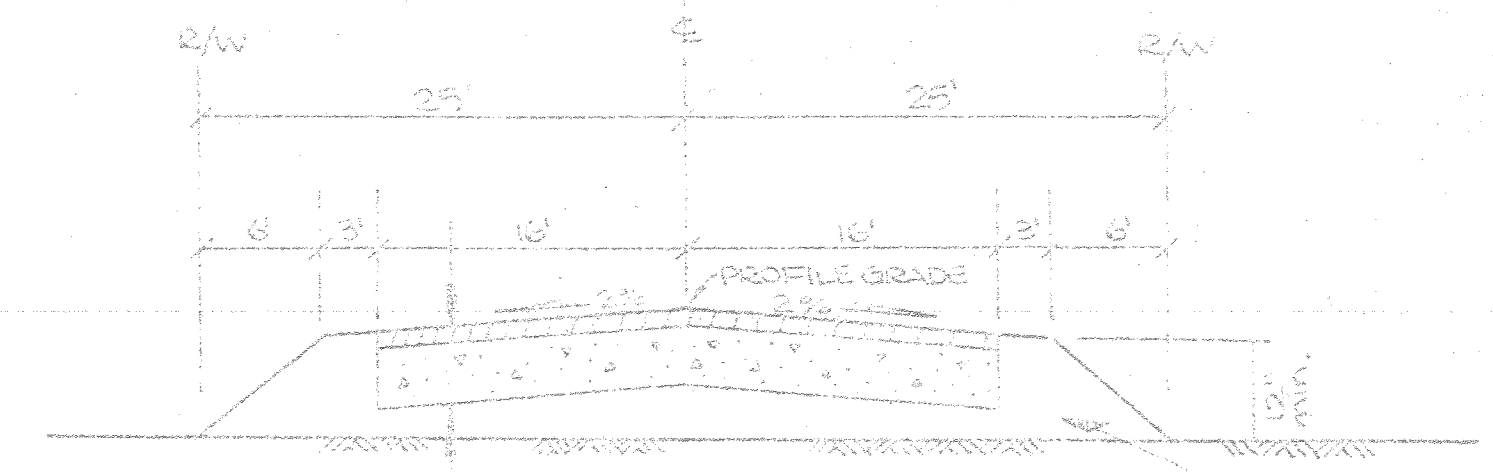

CROSS SECTION
1"=10' HORIZ. 1"=2' VERT.

- AC TO BE 1/2" MAX. MED.
- OIL TO BE AR 4000
- PRIME OIL TO BE SC 250
- AB TO BE CLASS 2

QUANTITIES (NORTH OF LINE A-A)
(FOR S.J. COUNTY)

1. STREET GRADING (1/4" R/W) 5570 SF
2. STREET (1/4" R/W) 4275 SF
3. PRIME COAT (SC 250) 0.5 TONS
4. CENTER LINE MONUMENTS 1 EA.
5. STORM DRAINAGE BASIN (1' DEEP) 10000 SF
6. LOT CORNERS 6 EA.
(By Consultant Engineer)

QUANTITIES (SOUTH OF LINE A-A)
(FOR S.J. COUNTY)

1. STREET GRADING (3/4" R/W) 64000 SF
2. STREET (2" AC + 3/4" AB) 40000 SF
3. PRIME COAT (SC 250) 47 TONS
4. SIGNS 1 ONLY
5. CENTER LINE MONUMENTS 5 EA.
6. REMOVE ALMOND TREES 60 EA.
7. STORM DRAINAGE BASINS (1' DEEP) 26000 SF
8. LOT CORNERS 13 EA.
(By Consultant Engineer)
9. BARRICADES (TYPE B) 1 EA.

NOTES:

1. ALL WORK SHALL CONFORM TO SAN JOAQUIN COUNTY REQUIREMENTS.
2. ELEVATIONS ARE BASED ON S.J. COUNTY TERRAIN DATA OF WILDEARTH ROAD, WEST OF THE G.O.T. CO. TRACK.
3. INDIVIDUAL LOT SHALL DRAIN STREET AND LOT.
4. FOR CONSTRUCTION REQUIREMENTS SEE THIS PLAN AND SPECIAL PROVISIONS FOR AMANDE ESTATES.
5. IT SHALL BE THE CONTRACTOR'S RESPONSIBILITY TO COORDINATE THE RELOCATION OF THE EXISTING ANCHOR AND POWER POLE WITH P.O. & E.
6. THE SITE IS PRESENTLY IN AN ORCHARD. THE CONTRACTOR SHALL REMOVE ALL TREES WITHIN THE R/W AS DESIGNATED BY THE OWNER. DISPOSAL OF THE STUMPS WILL BE "OFF-SITE".
7. EXCESS EXCAVATION MAY BE SPREAD ON SITE AS DIRECTED BY THE OWNER.
8. CENTERLINE MONUMENTS, DRINK NO. G-4 (P.O. & E. TO BE 3/4" IRON PIN AND SET BY ENGINEER).
9. DRIVEWAYS ARE NOT A PART OF THESE IMPROVEMENTS. AN ENCROACHMENT PERMIT MUST BE OBTAINED.

LEGEND

- ① LOT NUMBER
- PRIVATE WELL - 100' MIN. FROM LEACH FIELD
- LF DEGRADED LEACHFIELD 12,000 SQUARE FEET
- BASIN DRAINAGE STORM DRAINAGE BASIN. SIZE TO BE AS SHOWN ON PLANS. DEPTH TO BE 18 FEET.
- ① CURVE DATA
- ② CENTERLINE MONUMENT
- R/W RIGHT OF WAY
- E.D. CENTERLINE
- E.D. EDGE OF RIGHT-OF-WAY
- B.M. BENCHMARK - S.J. COUNTY, TERRAIN DATA, WILDEARTH ROAD, PUBLIC UTILITY EASEMENT, UTILITIES: ELECTRIC, GAS & TELEPHONE SHALL BE UNDERGROUND
- STREET SIGN
- POWER POLE
- 3/4" IRON SURVEY PIN. DO NOT DISTURB
- LOT CORNERS: 3/4" IRON PIN. DO NOT DISTURB
- ORIGINAL GROUND ELEVATION

CURVE DATA

- ① C= 205'
Δ= 120° 24' 50"
L= 229.25'
C= 229.25'
C= 229.25'
- ② C= 250'
Δ= 112° 11' 24"
L= 209.94'
C= 209.94'
C= 209.94'

50
1105

R.P. WELDM & ASSOCIATES INC.
CONSULTING CIVIL ENGINEER
STOCKTON, CALIFORNIA

AMANDE ESTATES
PROPOSED ROAD
PLAN, PROFILE & CROSS SECTION
DEPARTMENT OF PUBLIC WORKS
SAN JOAQUIN COUNTY, CALIFORNIA

SCALE 1"=100'	APPROVED BY: DATE	SHEET NO. 1
DESIGNED BY: R.P.W.		OF 1 SHEETS
DRAWN BY: S.R.G.		JOB NO.
TRACED BY:		120-00
CHECKED BY: R.P.W.	DIRECTOR OF PUBLIC WORKS	
	REL. 9/85	

AS BUILT PLANS

AS BUILT 5/19/78