

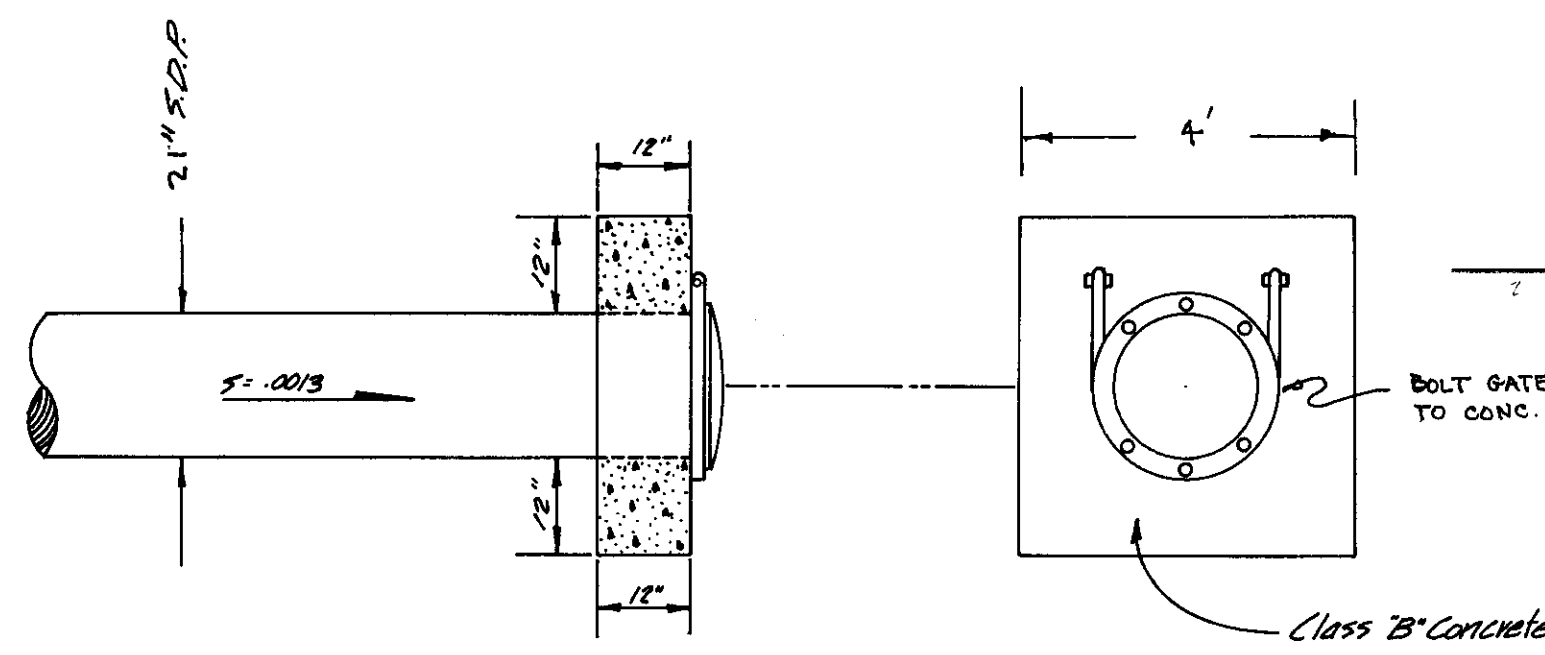


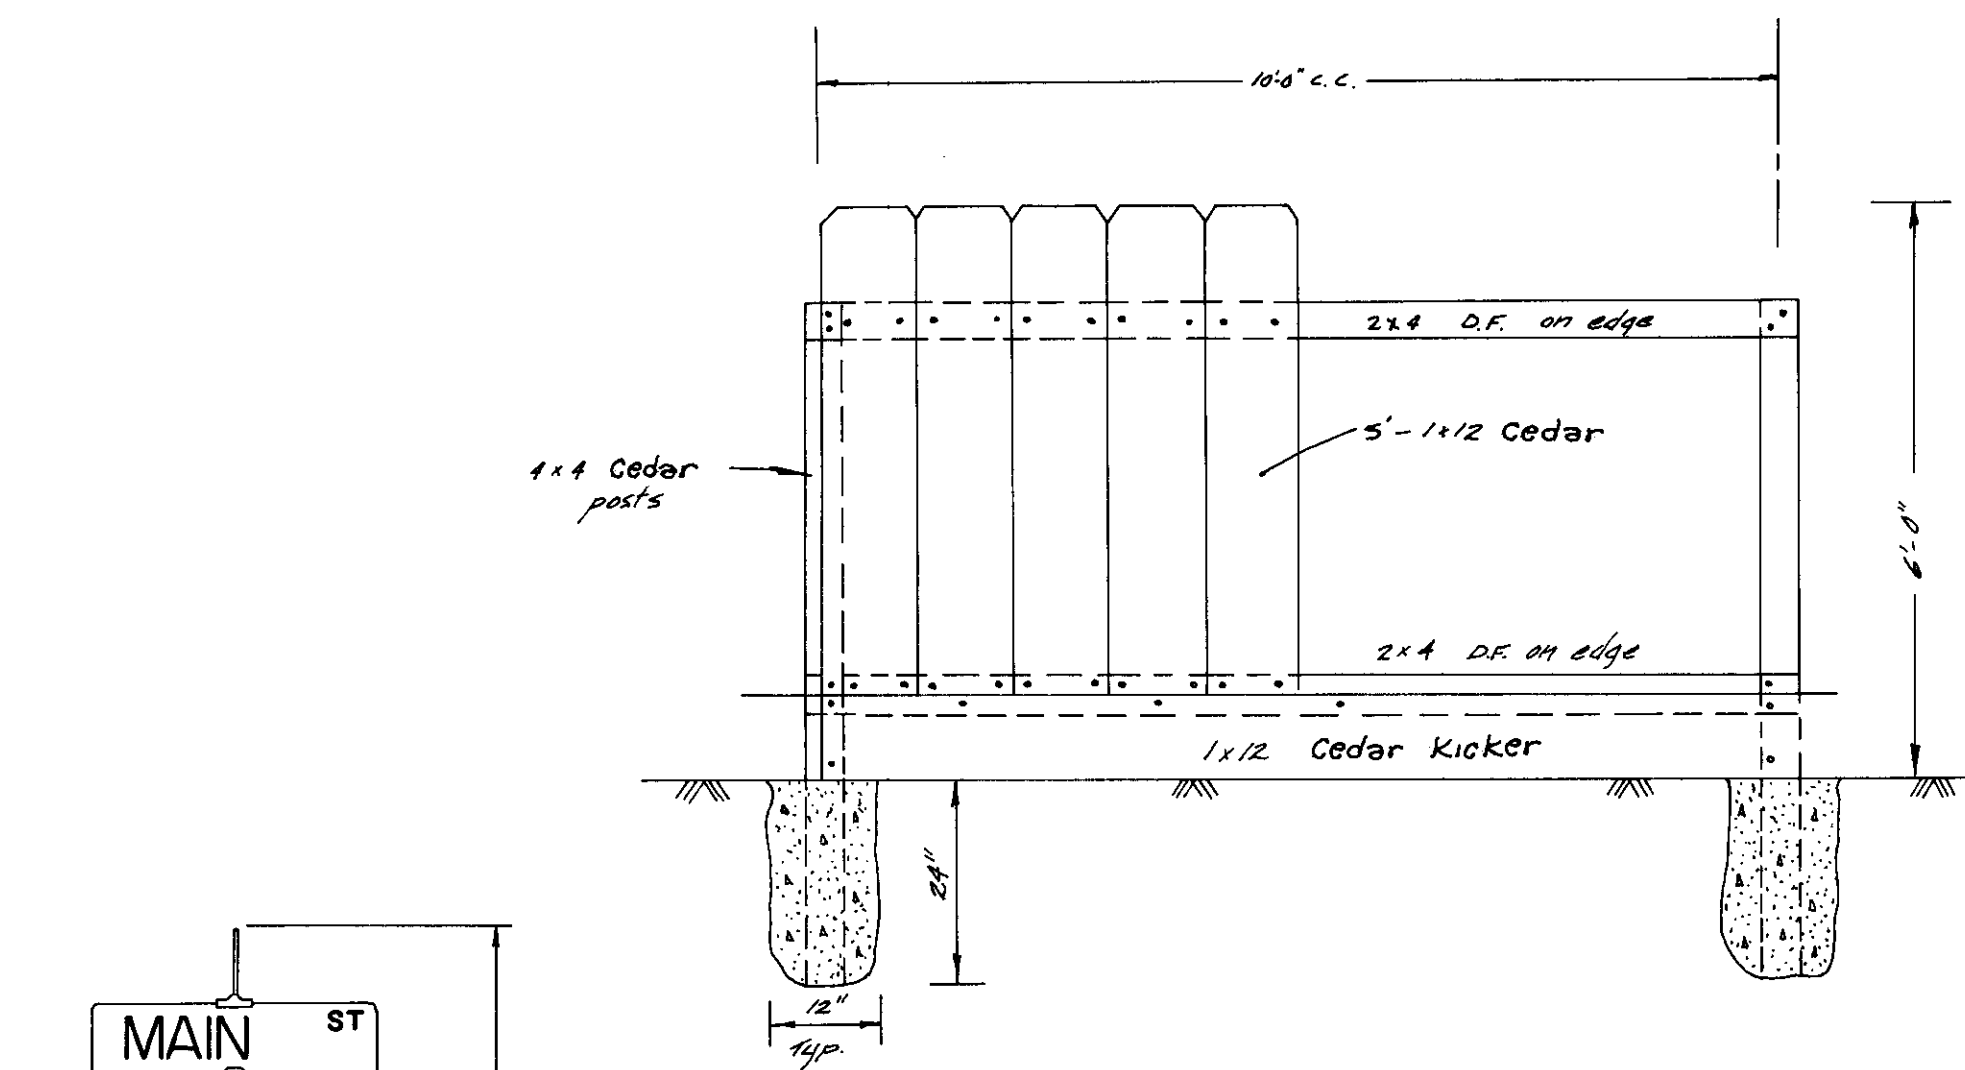


WATERMAN F-10F FLAP GATE DETAIL

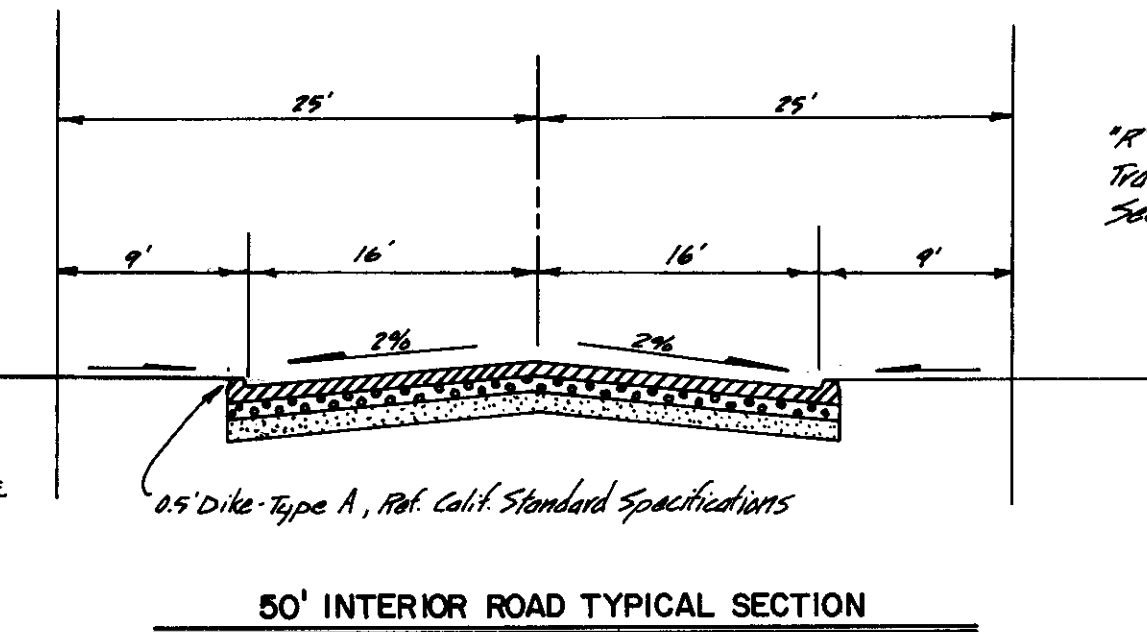


50' INTERIOR ROAD TYPICAL SECTION

*R Value .5
Traffic Index .40
Section 2A.C, 4\"/>

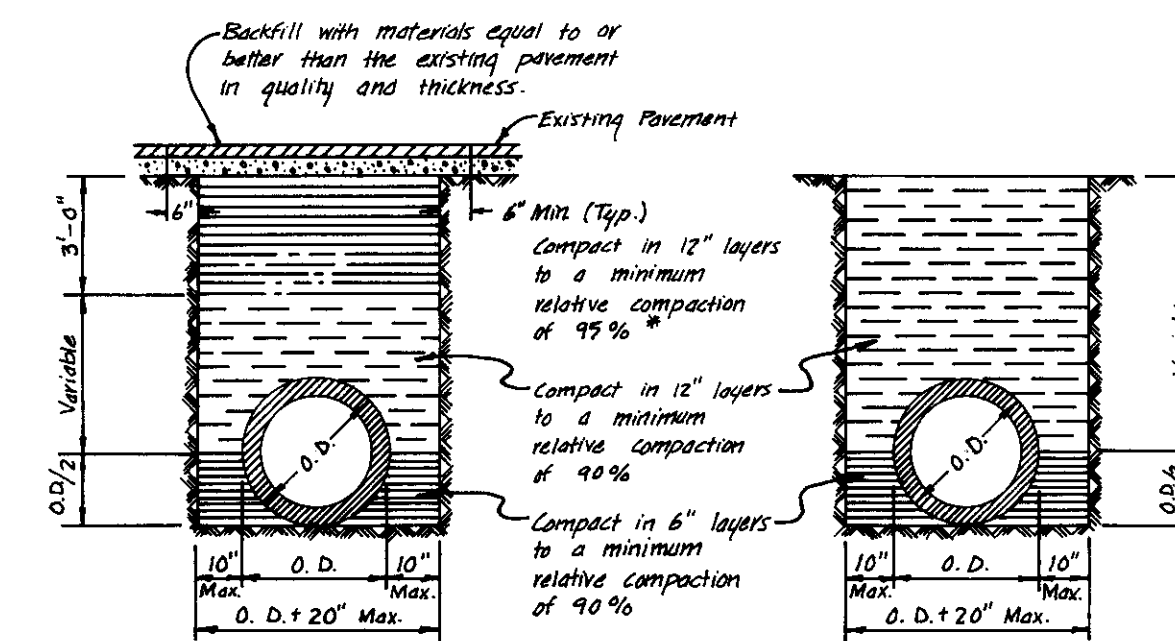


UNDER PAVEMENT AND SHOULDER

OUTSIDE SHOULDER

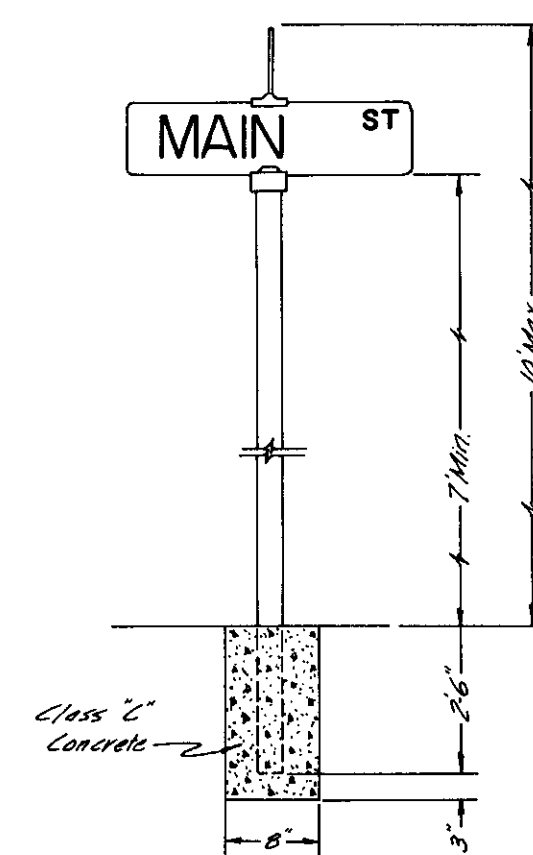

TYPICAL STREET SIGN INSTALLATION


STANDARD STREET SIGN DETAILS

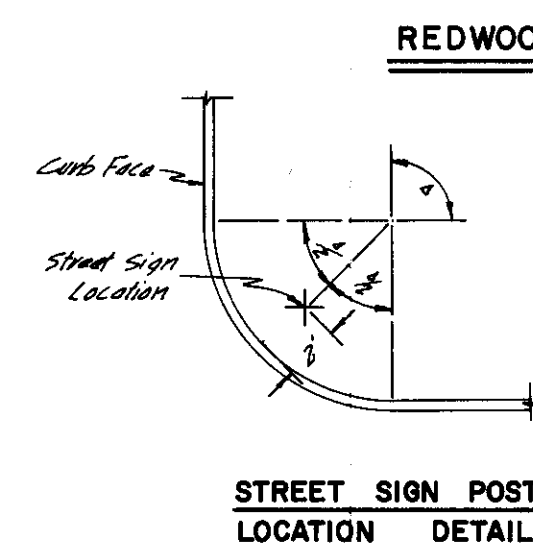


STREET SIGN POST LOCATION DETAIL

Note:
One street sign is required at each intersection.


REDWOOD FENCE DETAIL

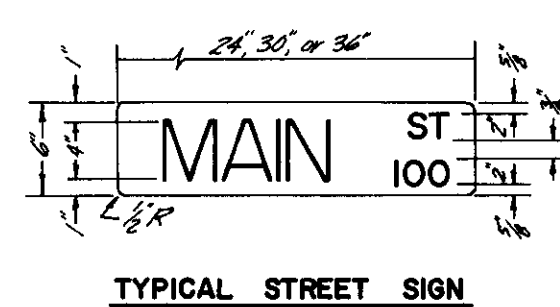

TYPICAL STREET SIGN

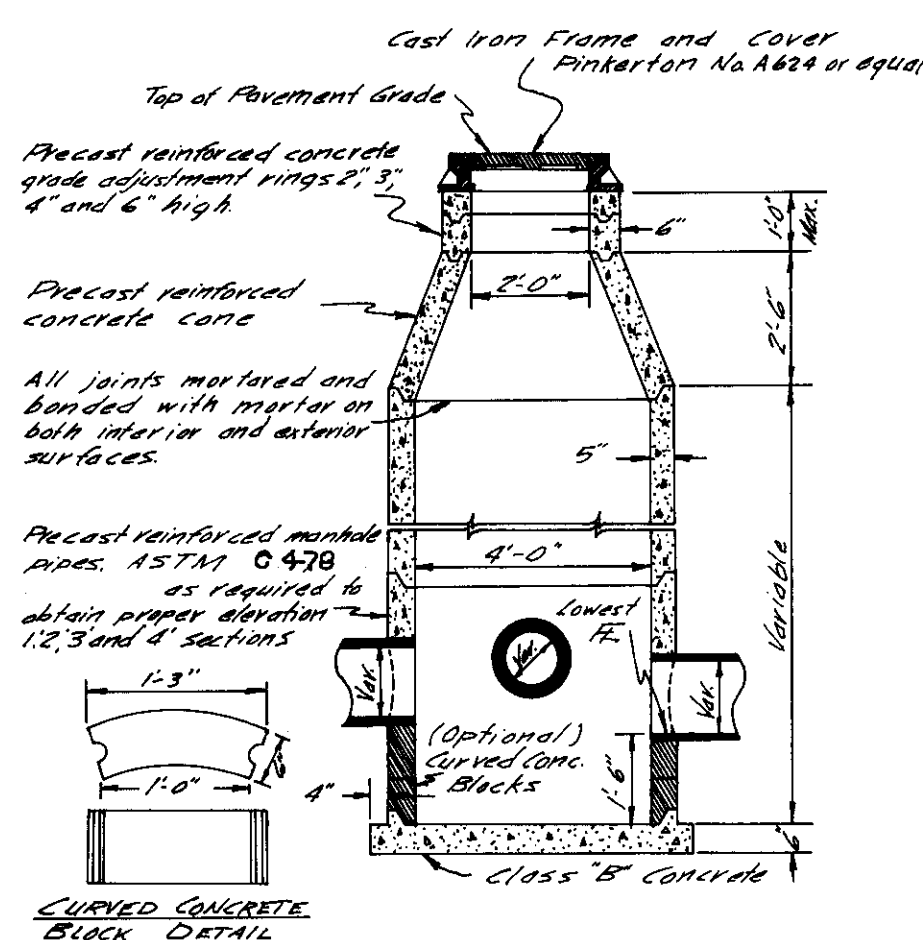


TYPICAL STORM SEWER MANHOLE

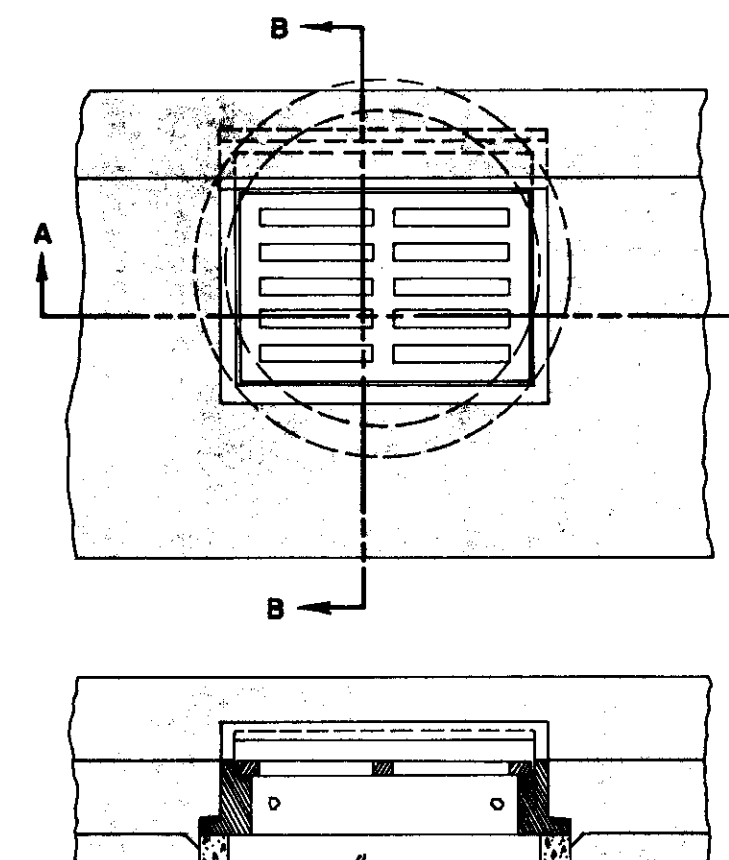


SECTION A-A

STANDARD STORM DRAIN INLET

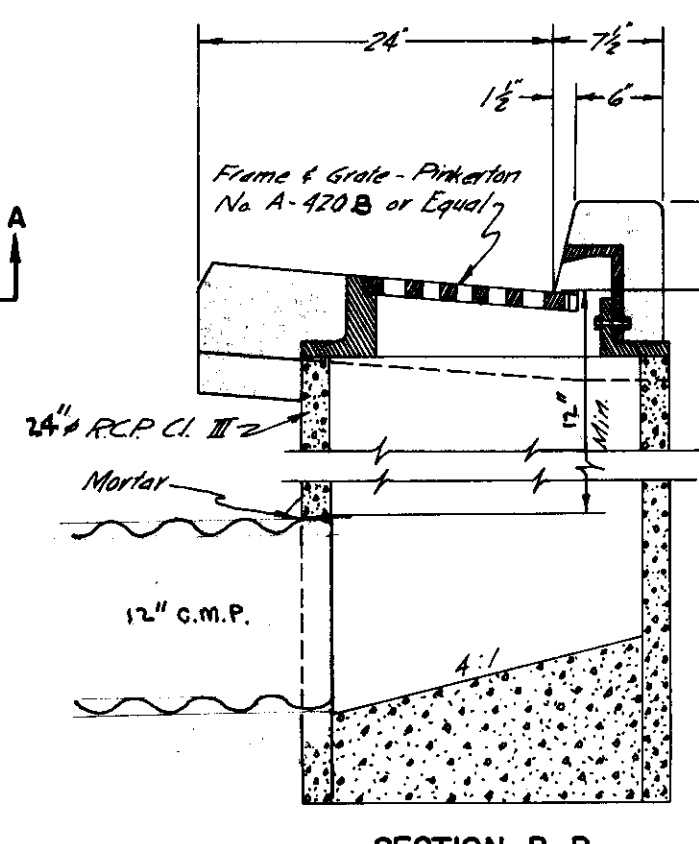


SECTION B-B

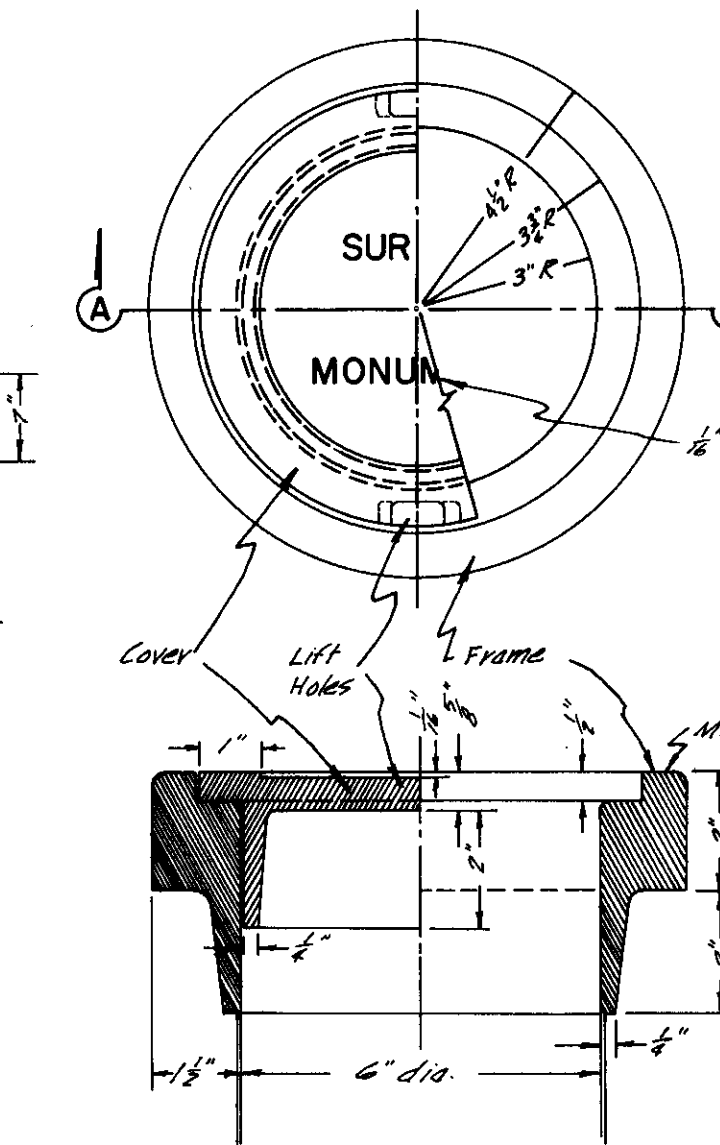


SECTION A-A

TYPICAL TRENCH BACKFILL

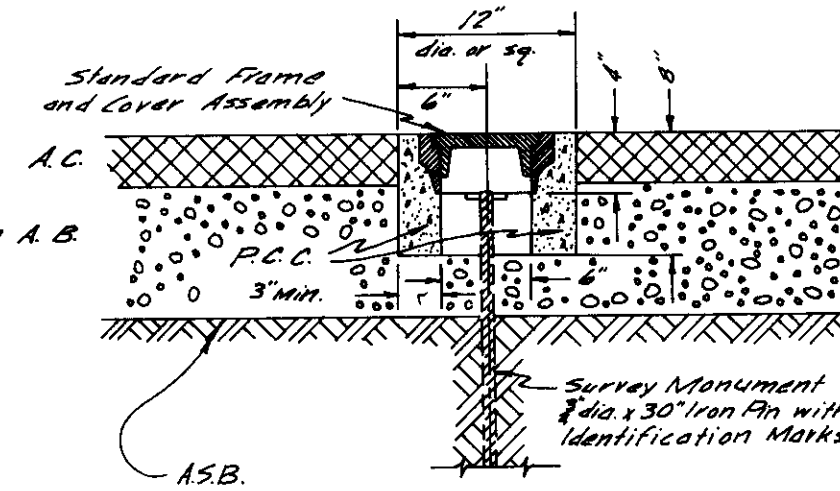

TYPICAL SECTION

SURVEY MONUMENT FRAME AND COVER ASSEMBLY

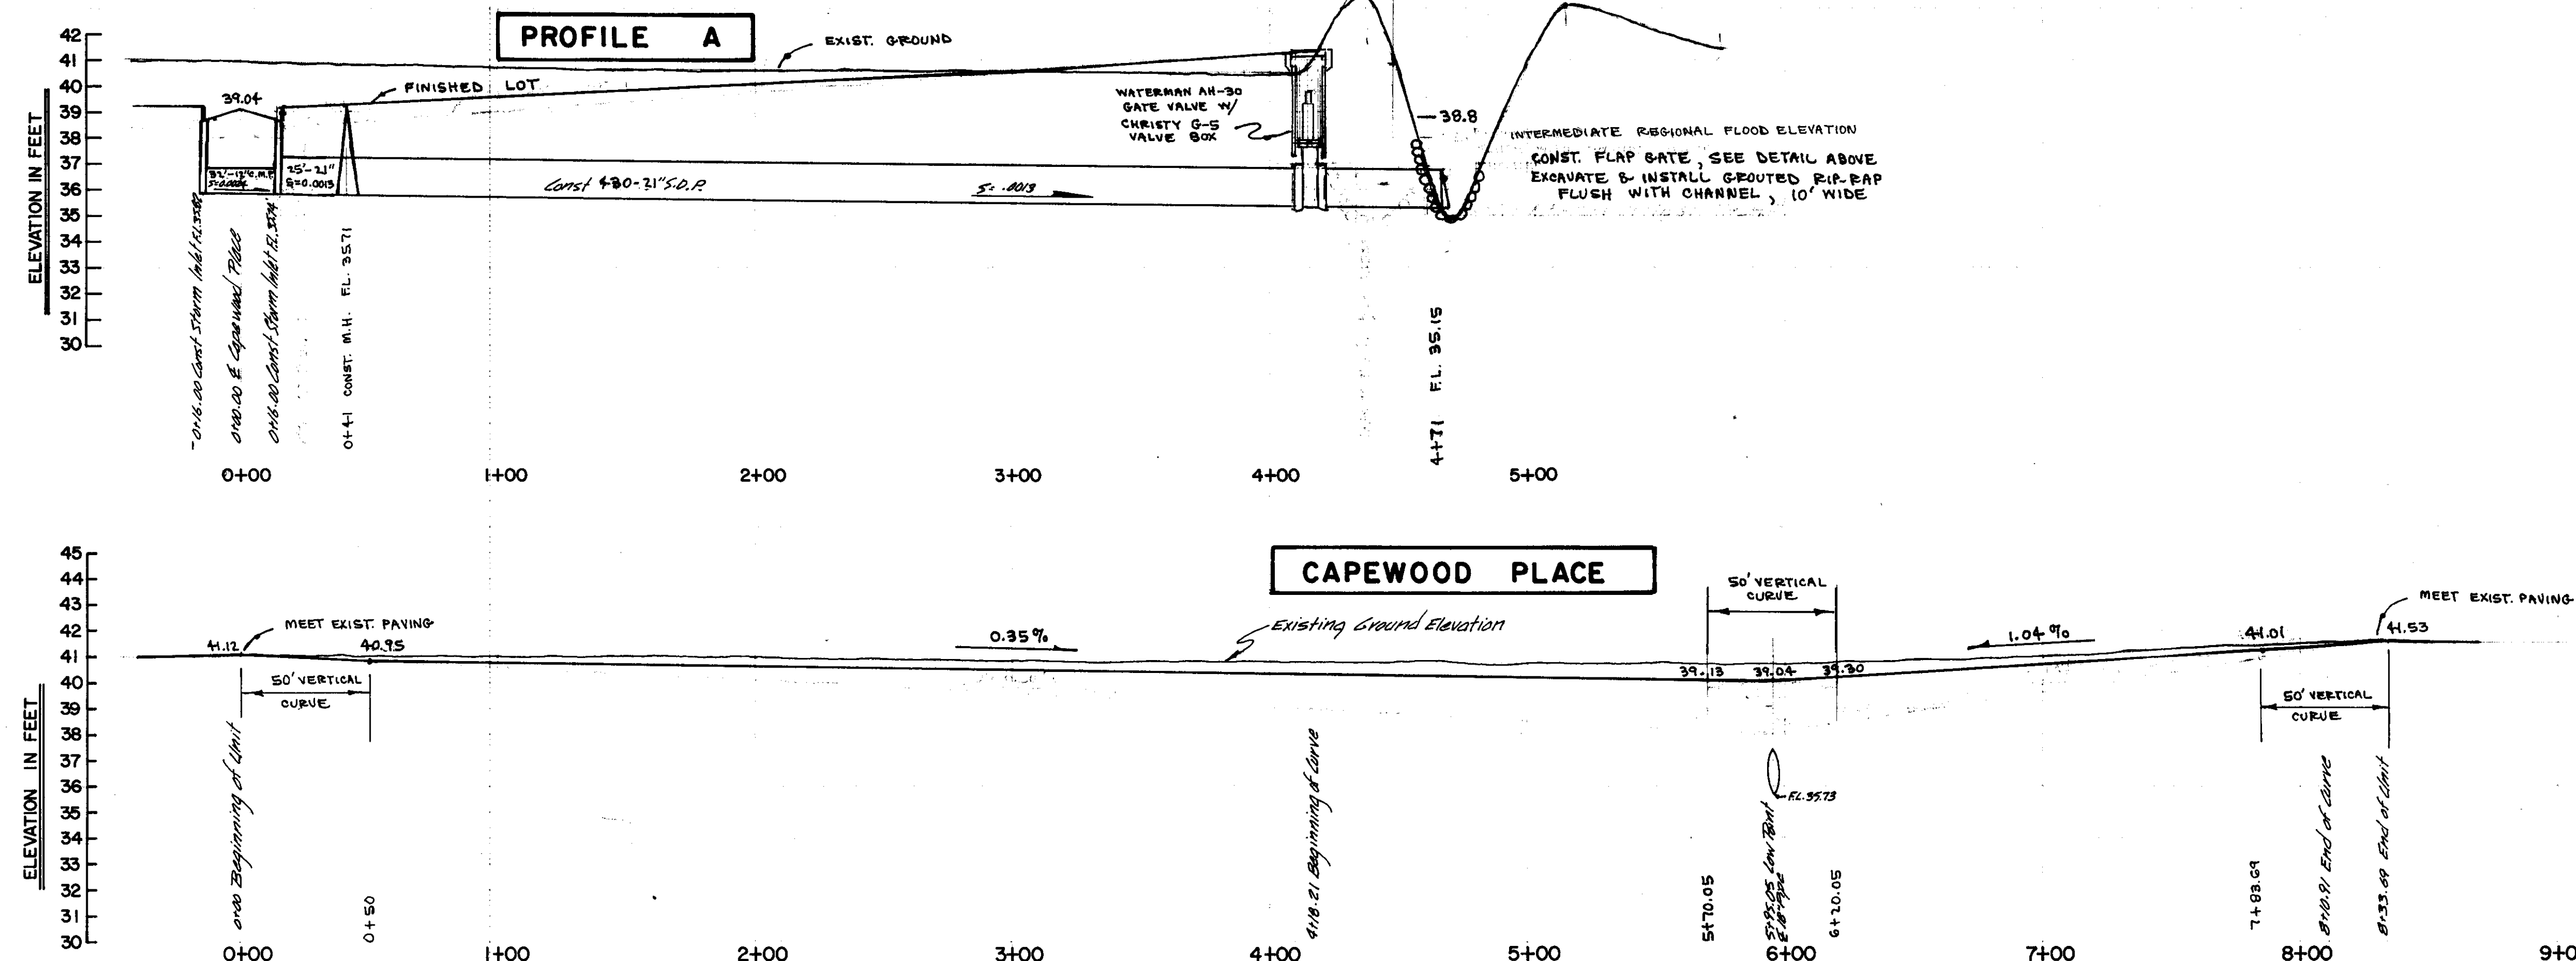

"AS BUILT PLANS"

APPROVED 19 8/30 1979
SAN JOAQUIN COUNTY DEPT. OF PUBLIC WORKS
DIRECTOR OF PUBLIC WORKS R.C.E. 9338

no.	description	date	by

WONG ENGINEERS, INC.
PLANNING - ENGINEERING - SURVEYING
STOCKTON, CALIFORNIA
R.C.E. No. 14269


job no. 1802
date APRIL 1979
f. b. no.
drawn D.R.K.
design C.C.W.
check C.C.W.

CAPEWOOD ESTATES

PROFILE AND DETAIL PLANS

SAN JOAQUIN COUNTY
CALIFORNIA

SHEET
2
OF TWO
FILE

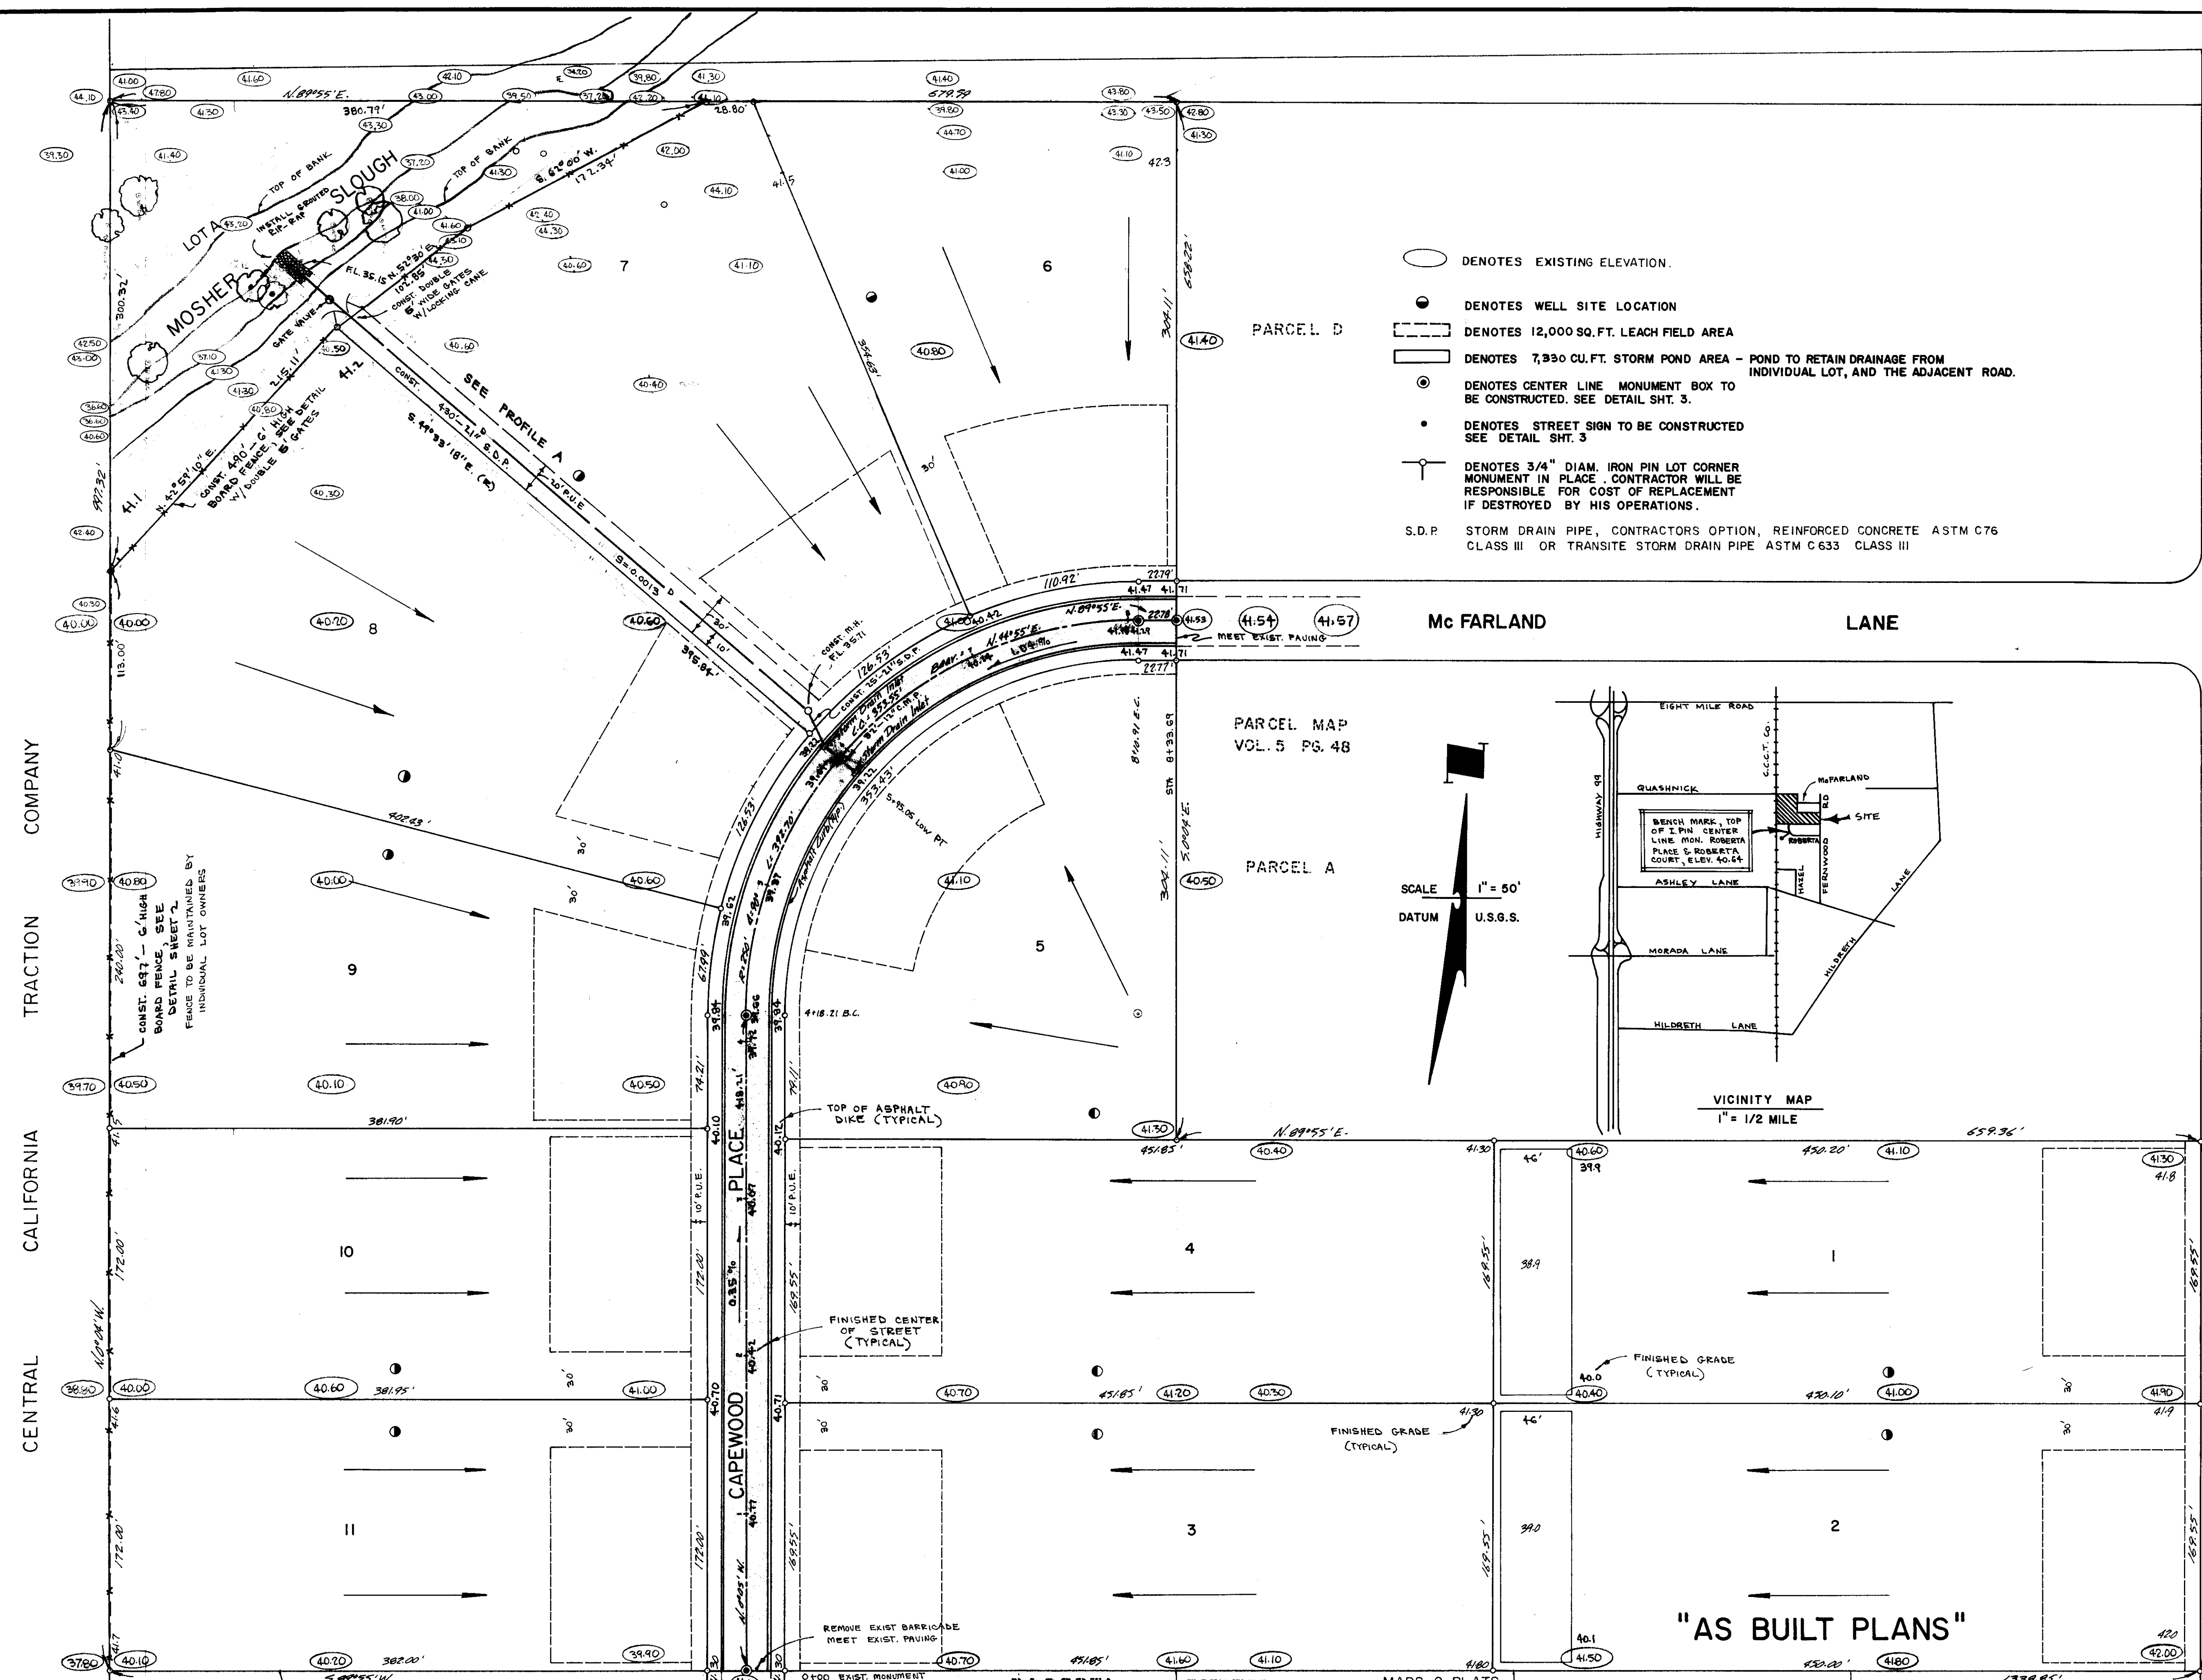

"AS BUILT PLANS"

APPROVED 1977
 SAN JOAQUIN COUNTY DEPT. OF PUBLIC WORKS
 DIRECTOR OF PUBLIC WORKS R.C.E. 933B

no.	description	date	by

WONG ENGINEERS, INC.
 PLANNING • ENGINEERING • SURVEYING
 STOCKTON, CALIFORNIA
 R.C.E. No. 14289

job no. 1802
 date MARCH 1979
 scale 1" = 50'
 drawn D.R.K.
 design C.C.W.
 check C.C.W.

CAPEWOOD ESTATES
GRADING & STREET IMPROVEMENT PLANS

SAN JOAQUIN COUNTY
 CALIFORNIA
 SHEET
 OF TWO
 FILE