



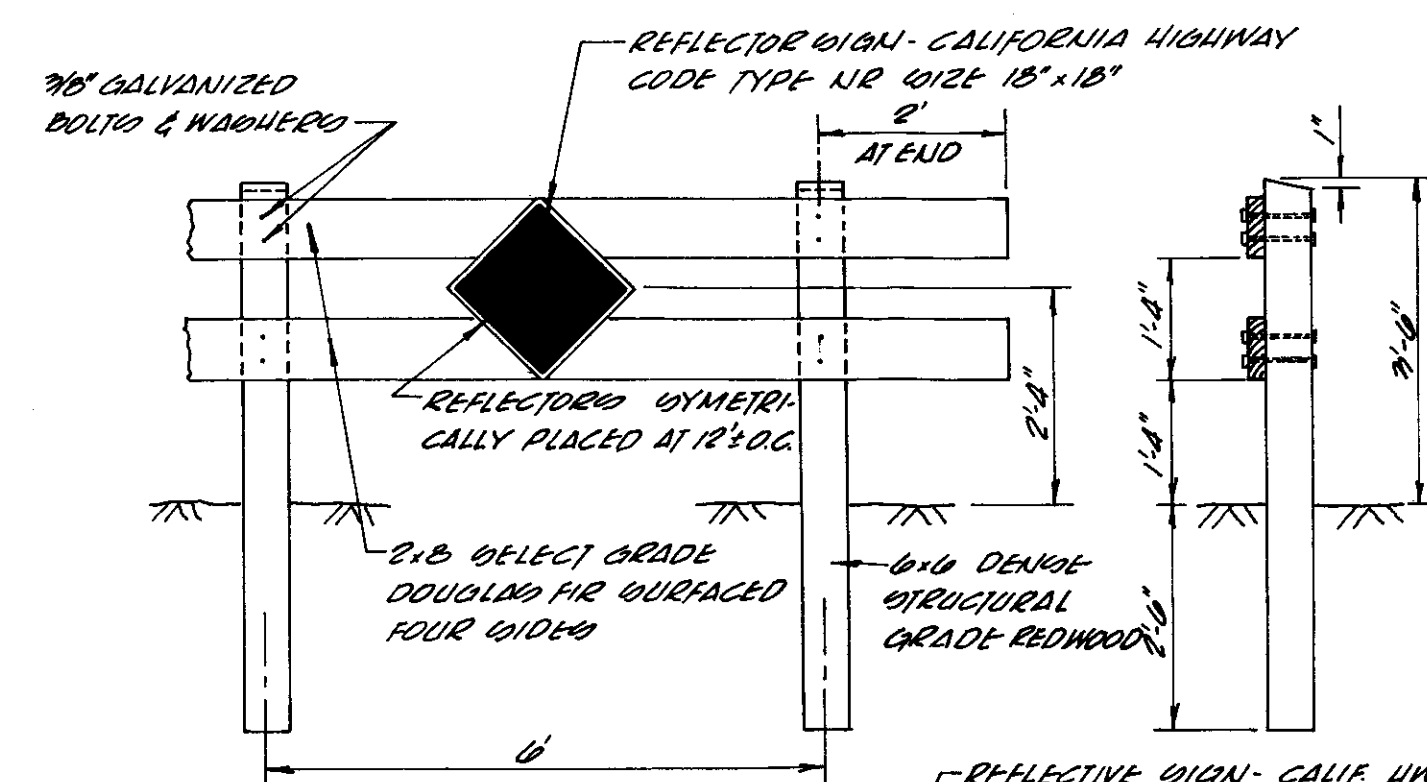


- NOTE:
1. BARRICADE TO BE 18" WIDE AS STREET R/W.
 2. BARRICADE TO BE PAINTED WHITE USING 2 COATS OF EXTERIOR ACRYLIC EMULSION ALKALY-RESISTANT ENAMEL OVER A COMPATIBLE PRIMER.

TYPE "A" BARRICADE
N.T.S.

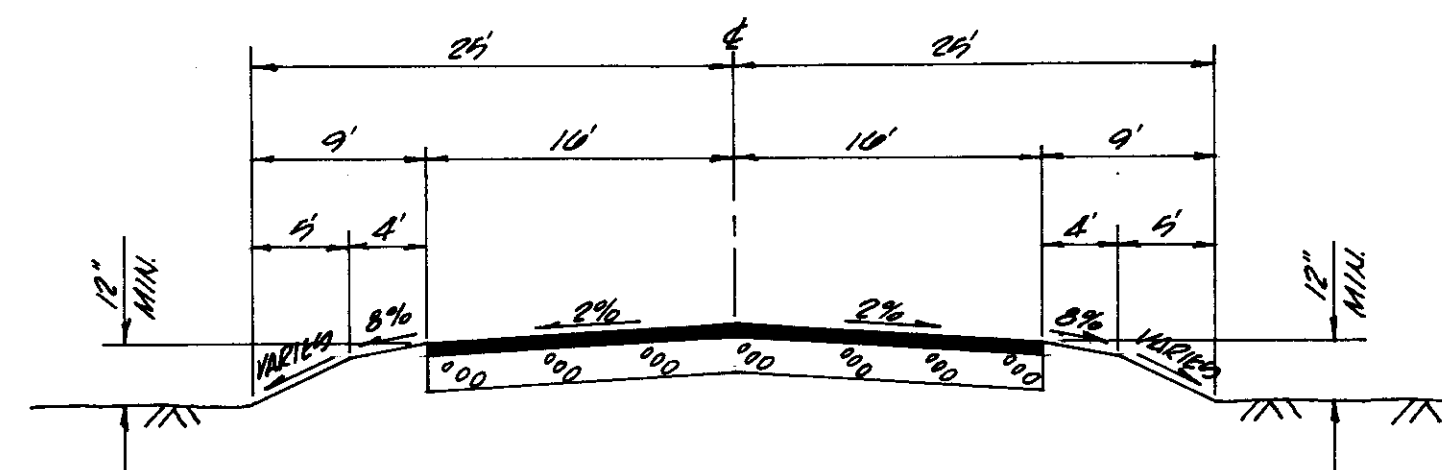


R VALUE = 5
T.I. = 7.5
SECTION = 2" AC,
PRIME COAT,
3" AB


TYPICAL SECTION
PIPER PLACE
N.T.S.

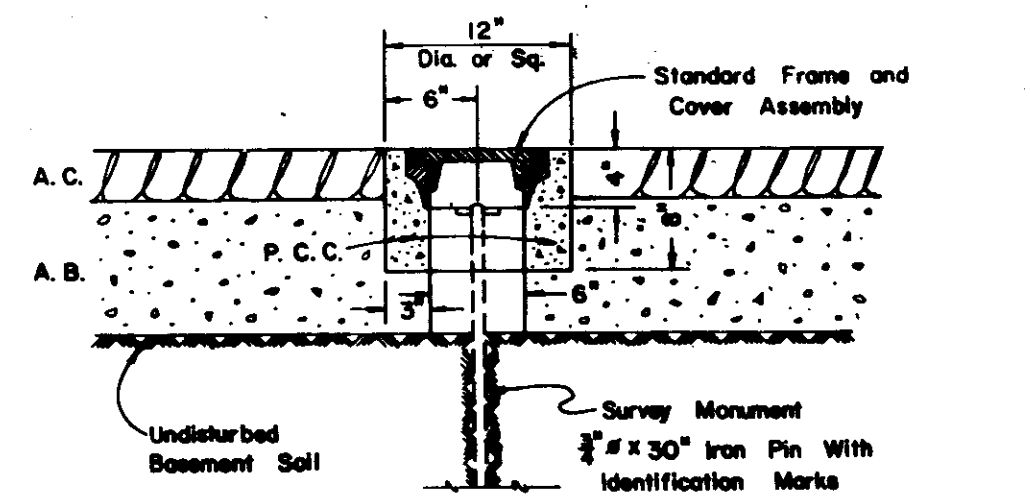

TYPICAL SECTION

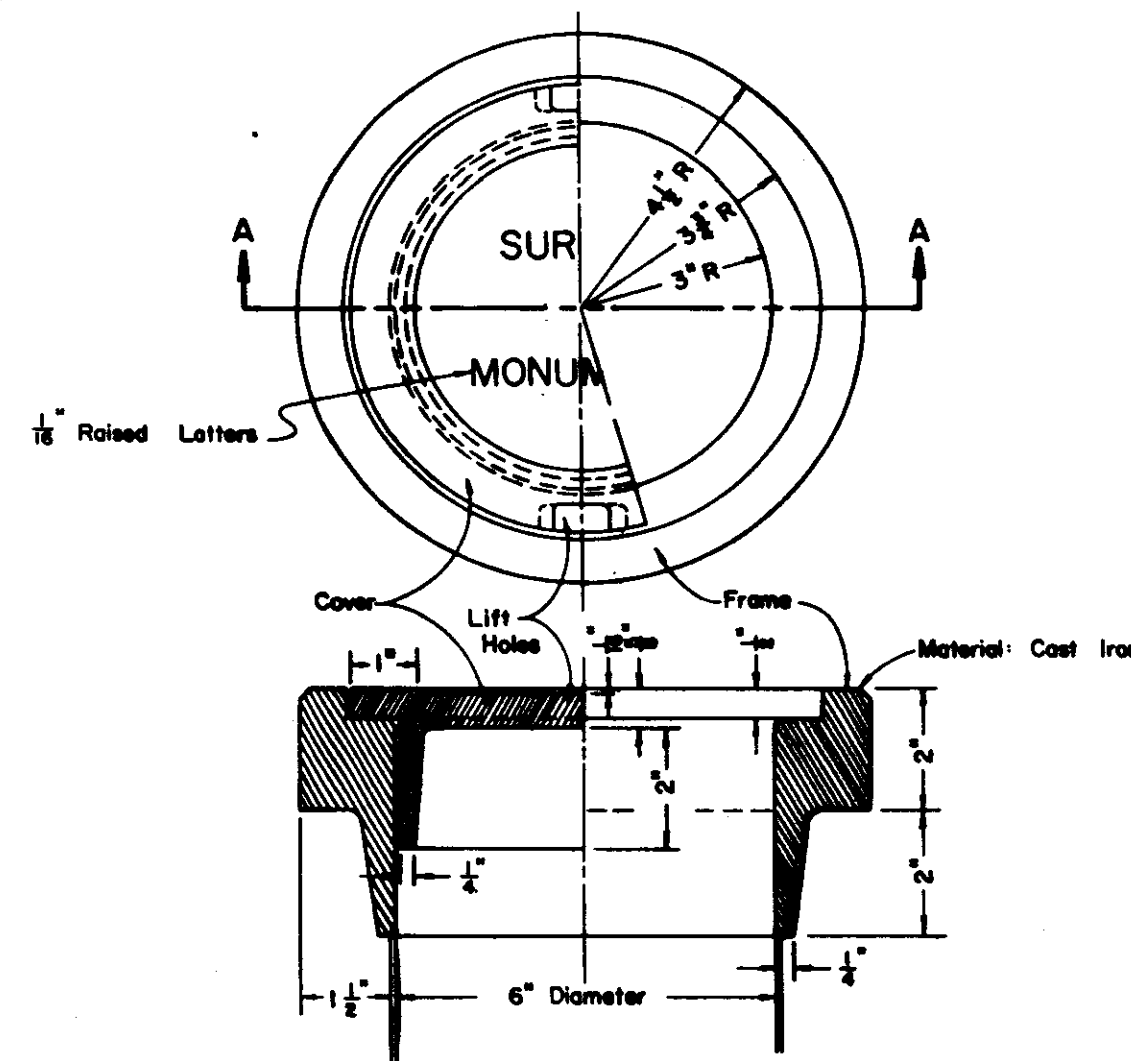


SECTION A-A
SURVEY MONUMENT
FRAME & COVER ASSEMBLY

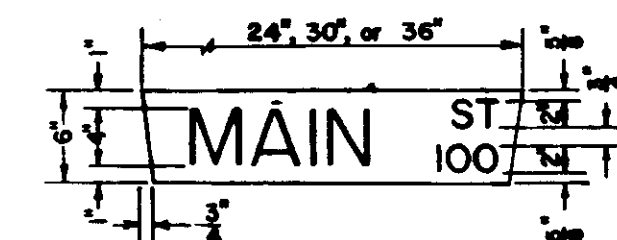


TYPICAL STREET SIGN

- NOTE:
1. One street sign is required at each intersection.
 2. Dimensions for block numbers are for location of numbers only.

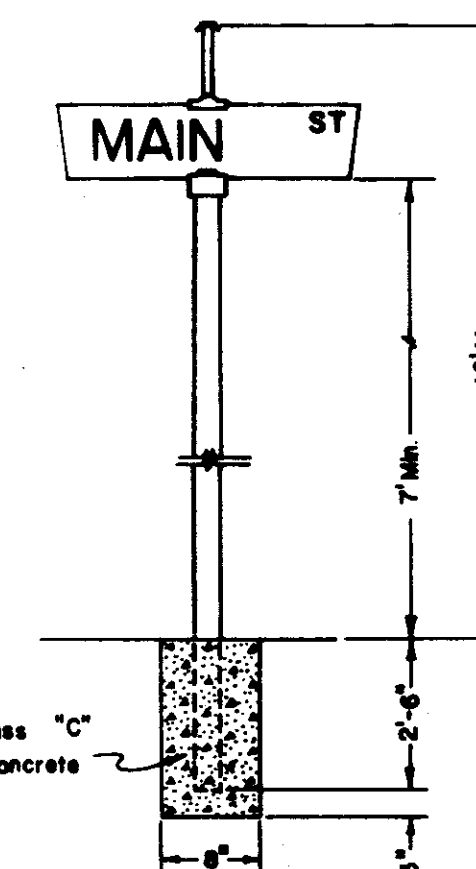


TYPICAL STREET SIGN
INSTALLATION

STANDARD STREET
SIGN DETAILS

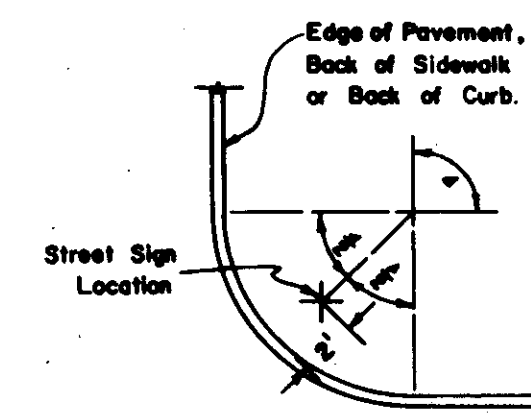


STREET SIGN POST
LOCATION DETAIL

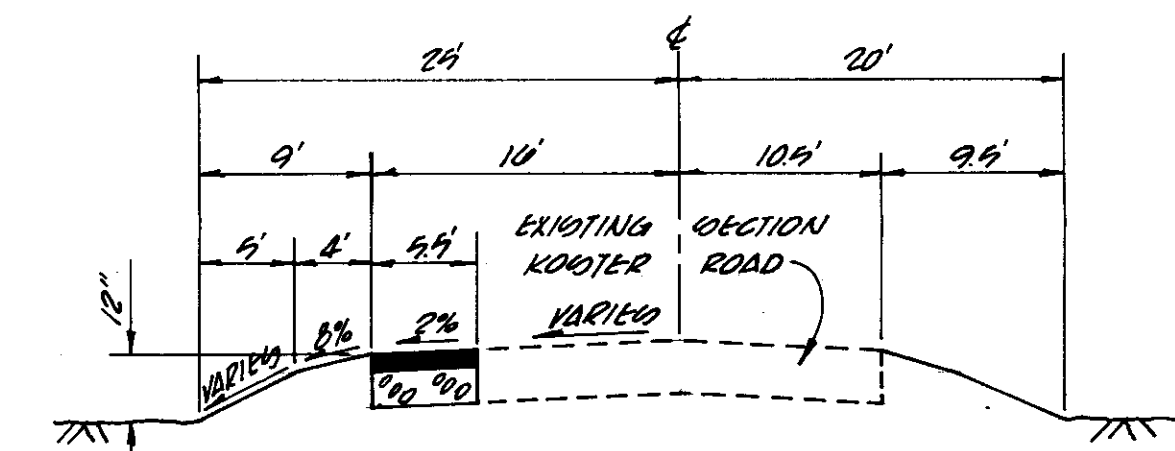


R VALUE = 4
T.I. = 4
SECTION = 2" AC,
PRIME COAT,
3" AB

TYPICAL SECTION
KOOTER ROAD
N.T.S.

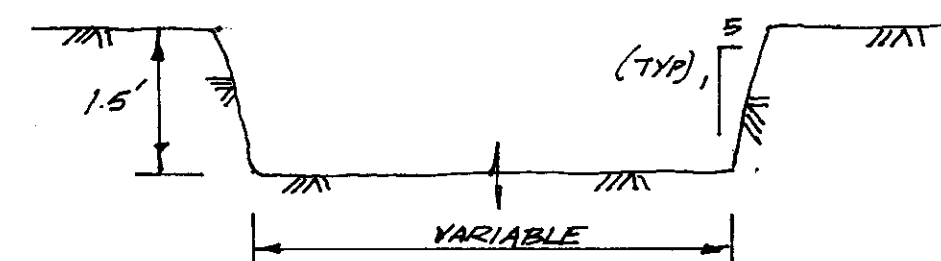

TYPICAL POND SECTION

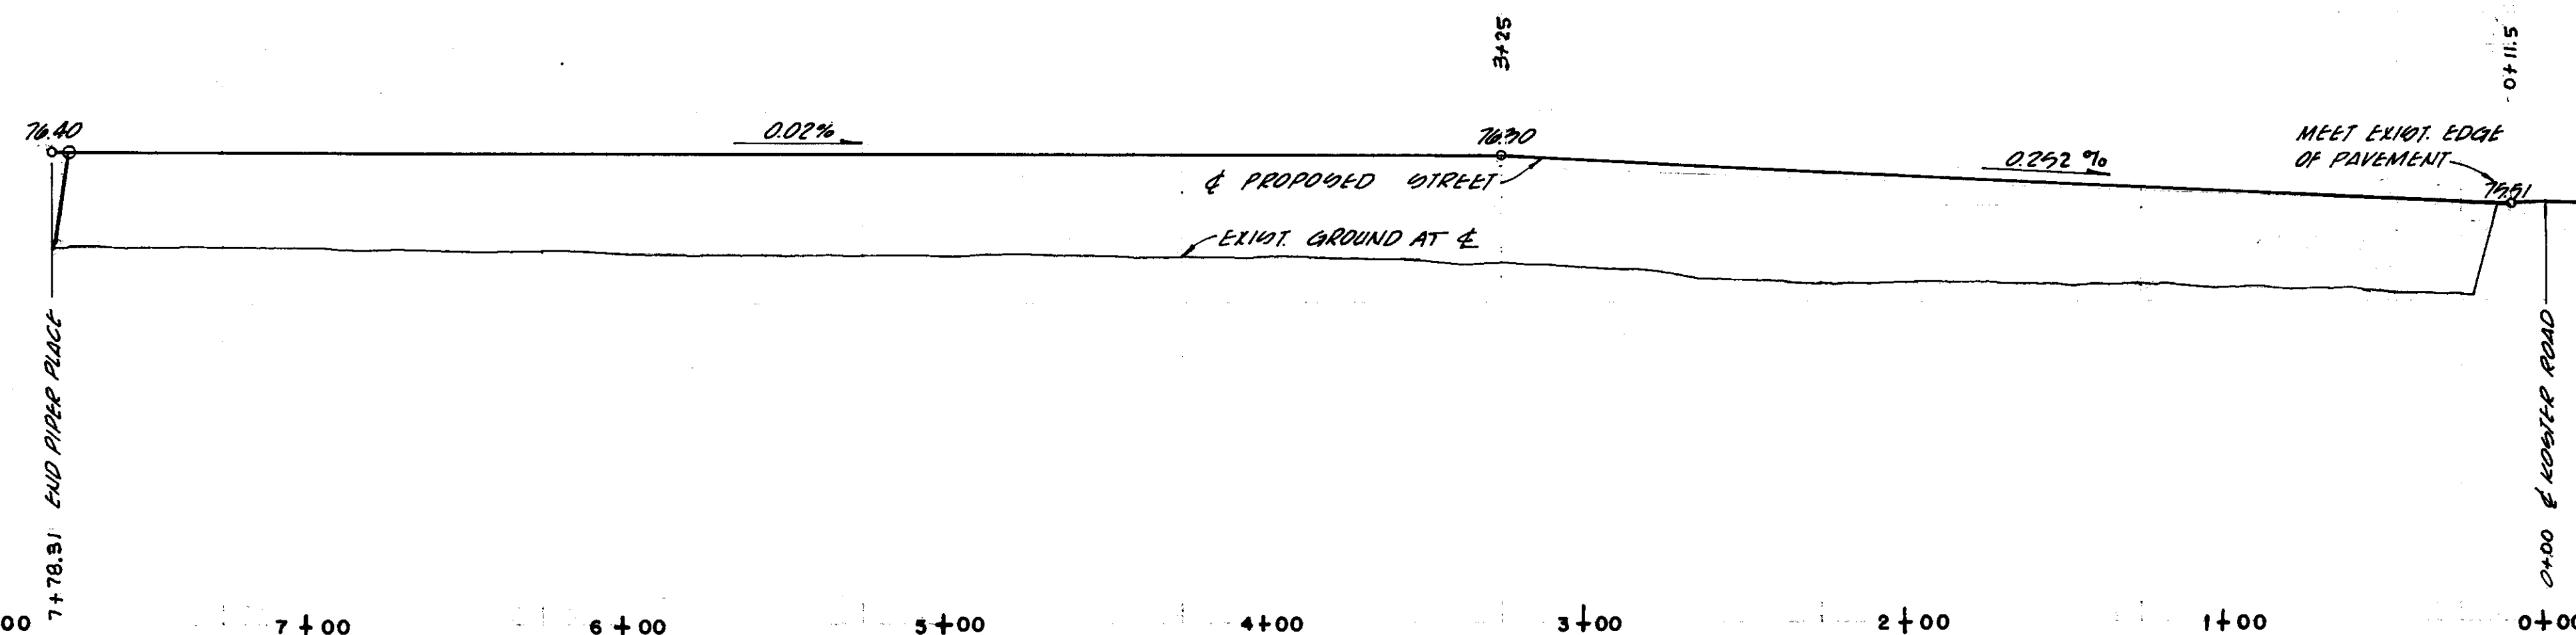

SCALE: HORIZ: 1" = 40'
VERT: 1" = 2'

AS BUILT PLANS

APPROVED _____ 19 _____

APPROVED _____ 19 _____

revisions			
no.	description	date	by



WONG ENGINEERS, INC.
PLANNING • ENGINEERING • SURVEYING
STOCKTON, CALIFORNIA

R.C.E. No. 14269

job no. 1757
date APRIL 84
f. b. no.
drawn
design WE
check

PIPER PLACE

PROFILE AND DETAIL SHEET

SHEET
2
OF TWO
FILE

