
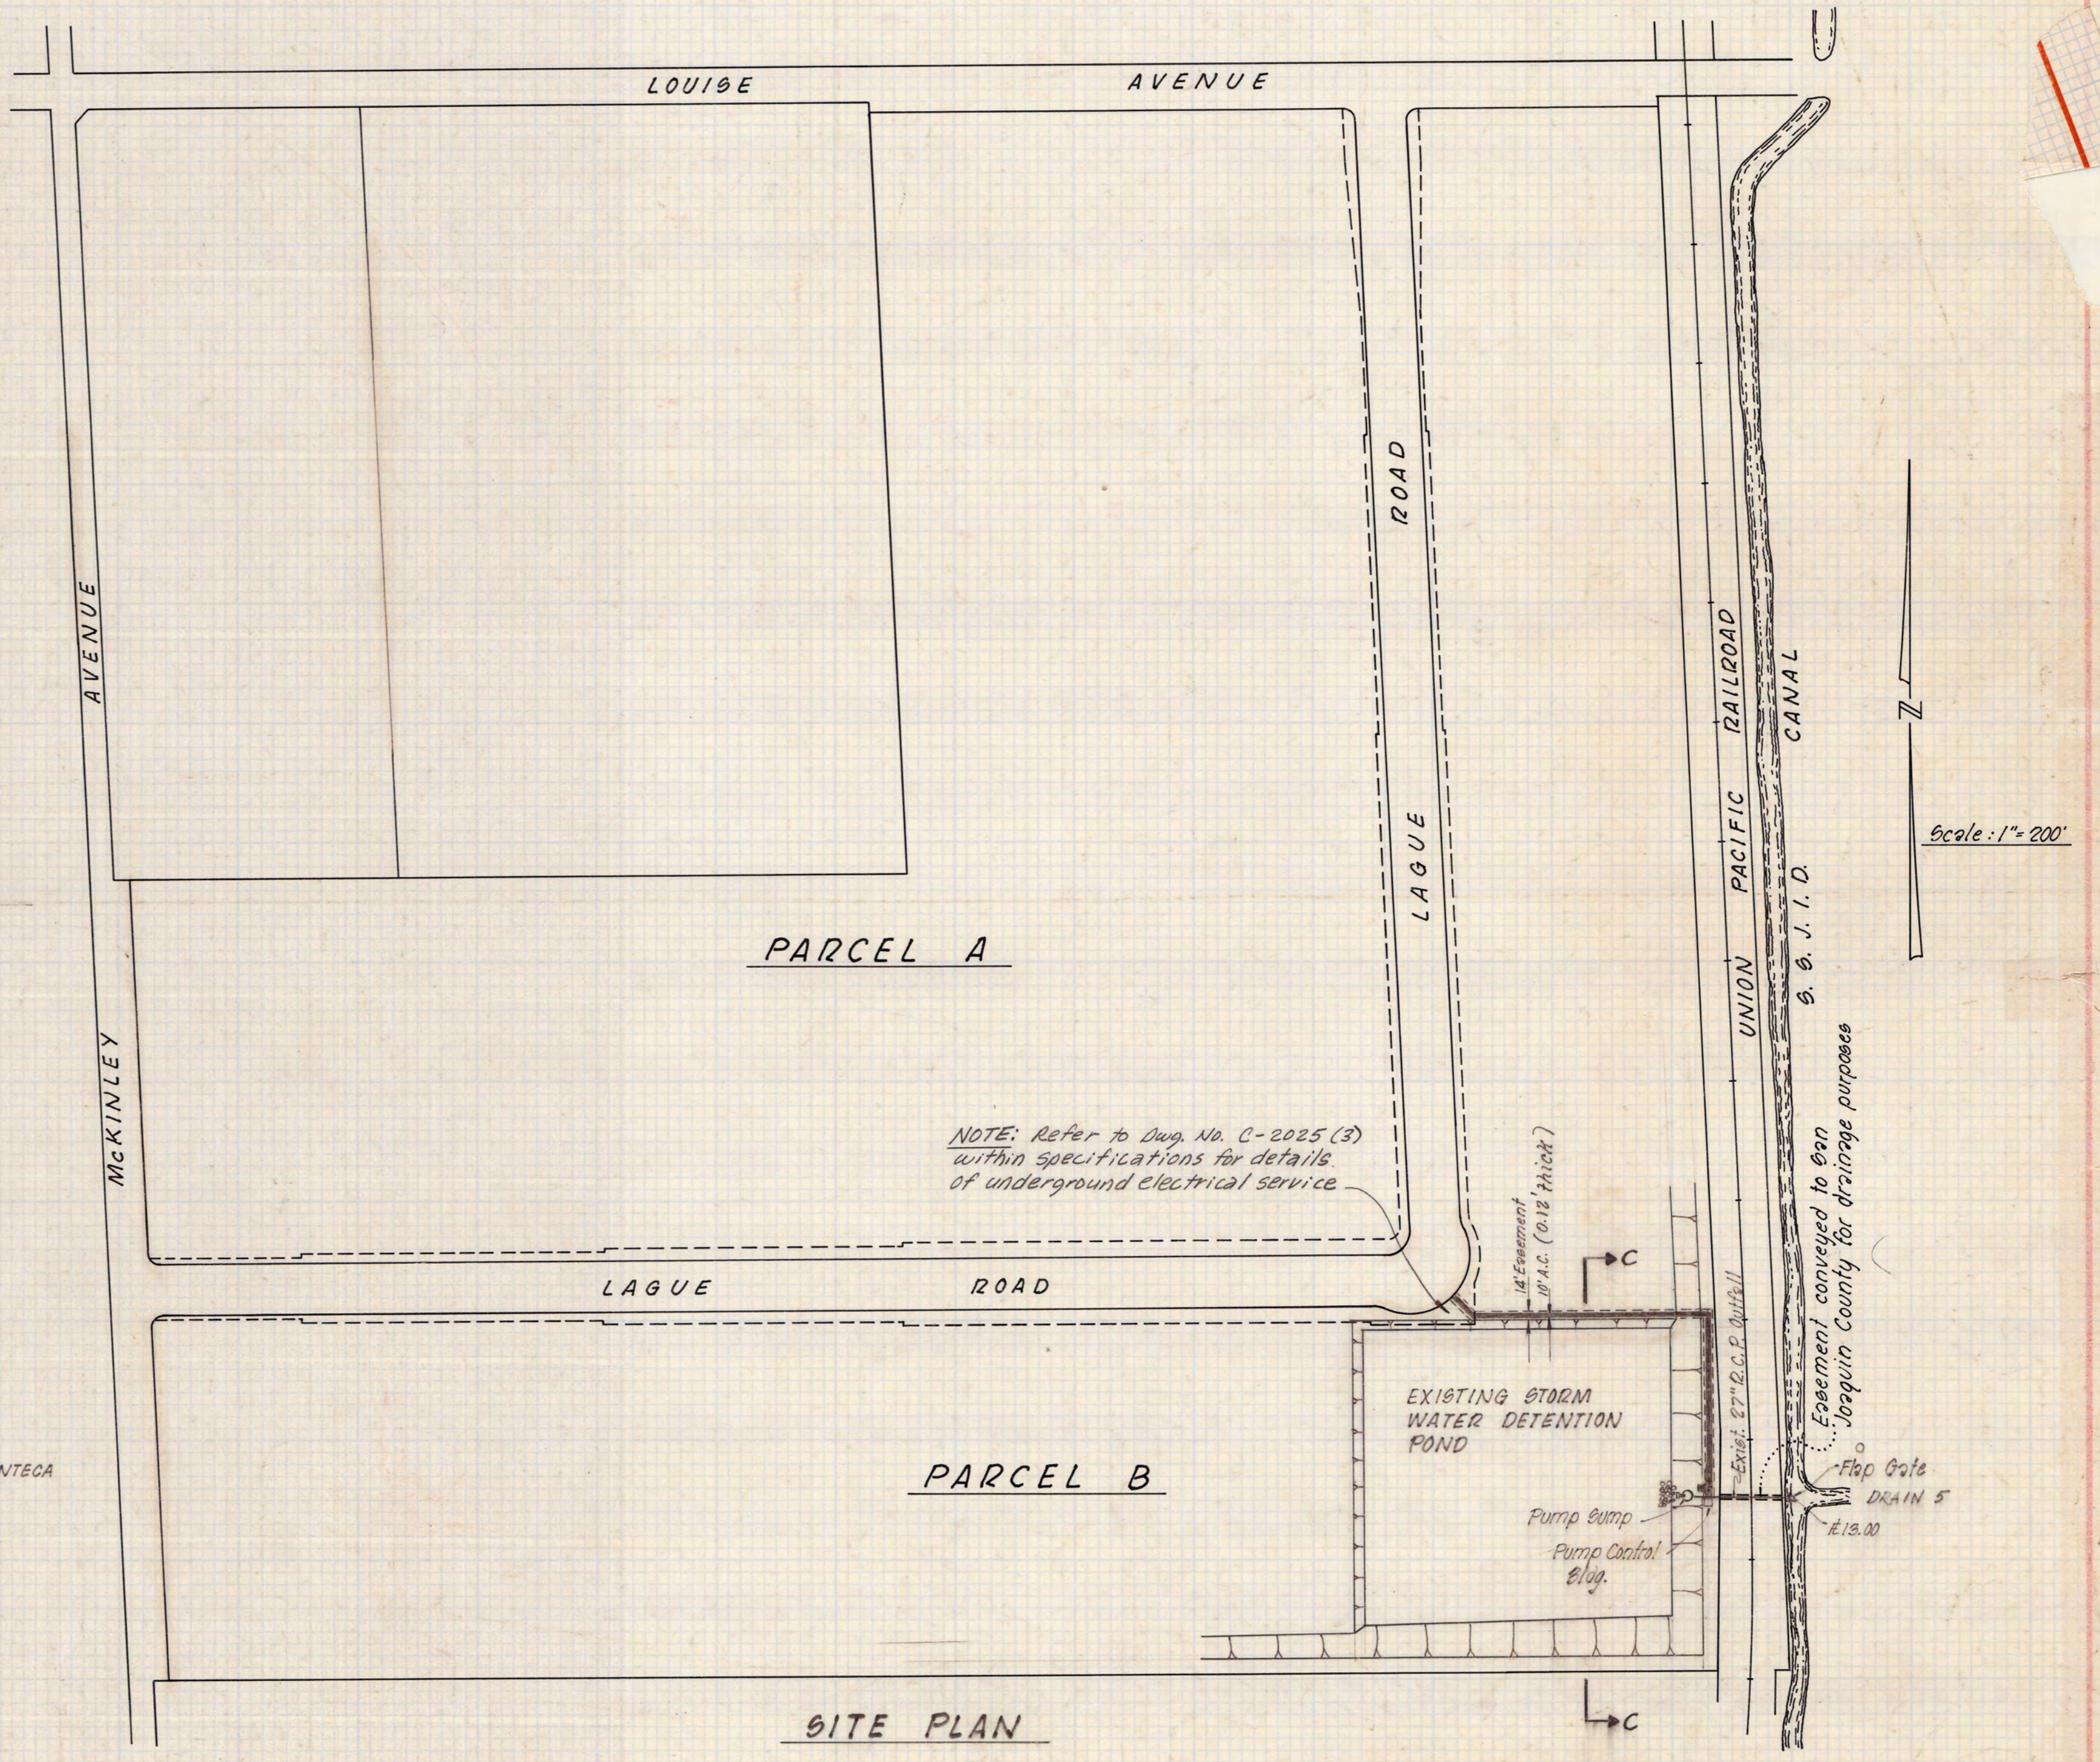


S.S.J.I.D., ITS AGENTS AND EMPLOYEES ARE NOT RESPONSIBLE FOR VERIFICATION OF THE ELEVATIONS AND DIMENSIONS INDICATED ON PLANS NOR ANY ERRORS OR OMISSIONS THAT MAY BE PRESENT. APPROVAL IS SUBJECT TO THE DATA SHOWN WHICH APPEARS TO BE IN CONFORMITY WITH S.S.J.I.D. REQUIREMENTS FOR PROTECTION OF DISTRICT FACILITIES.

APPROVED: *Nick C. DeGroot* DATE 9-12-85  
NICK C. DEGROOT  
CHAIRMAN  
S.S.J.I.D.

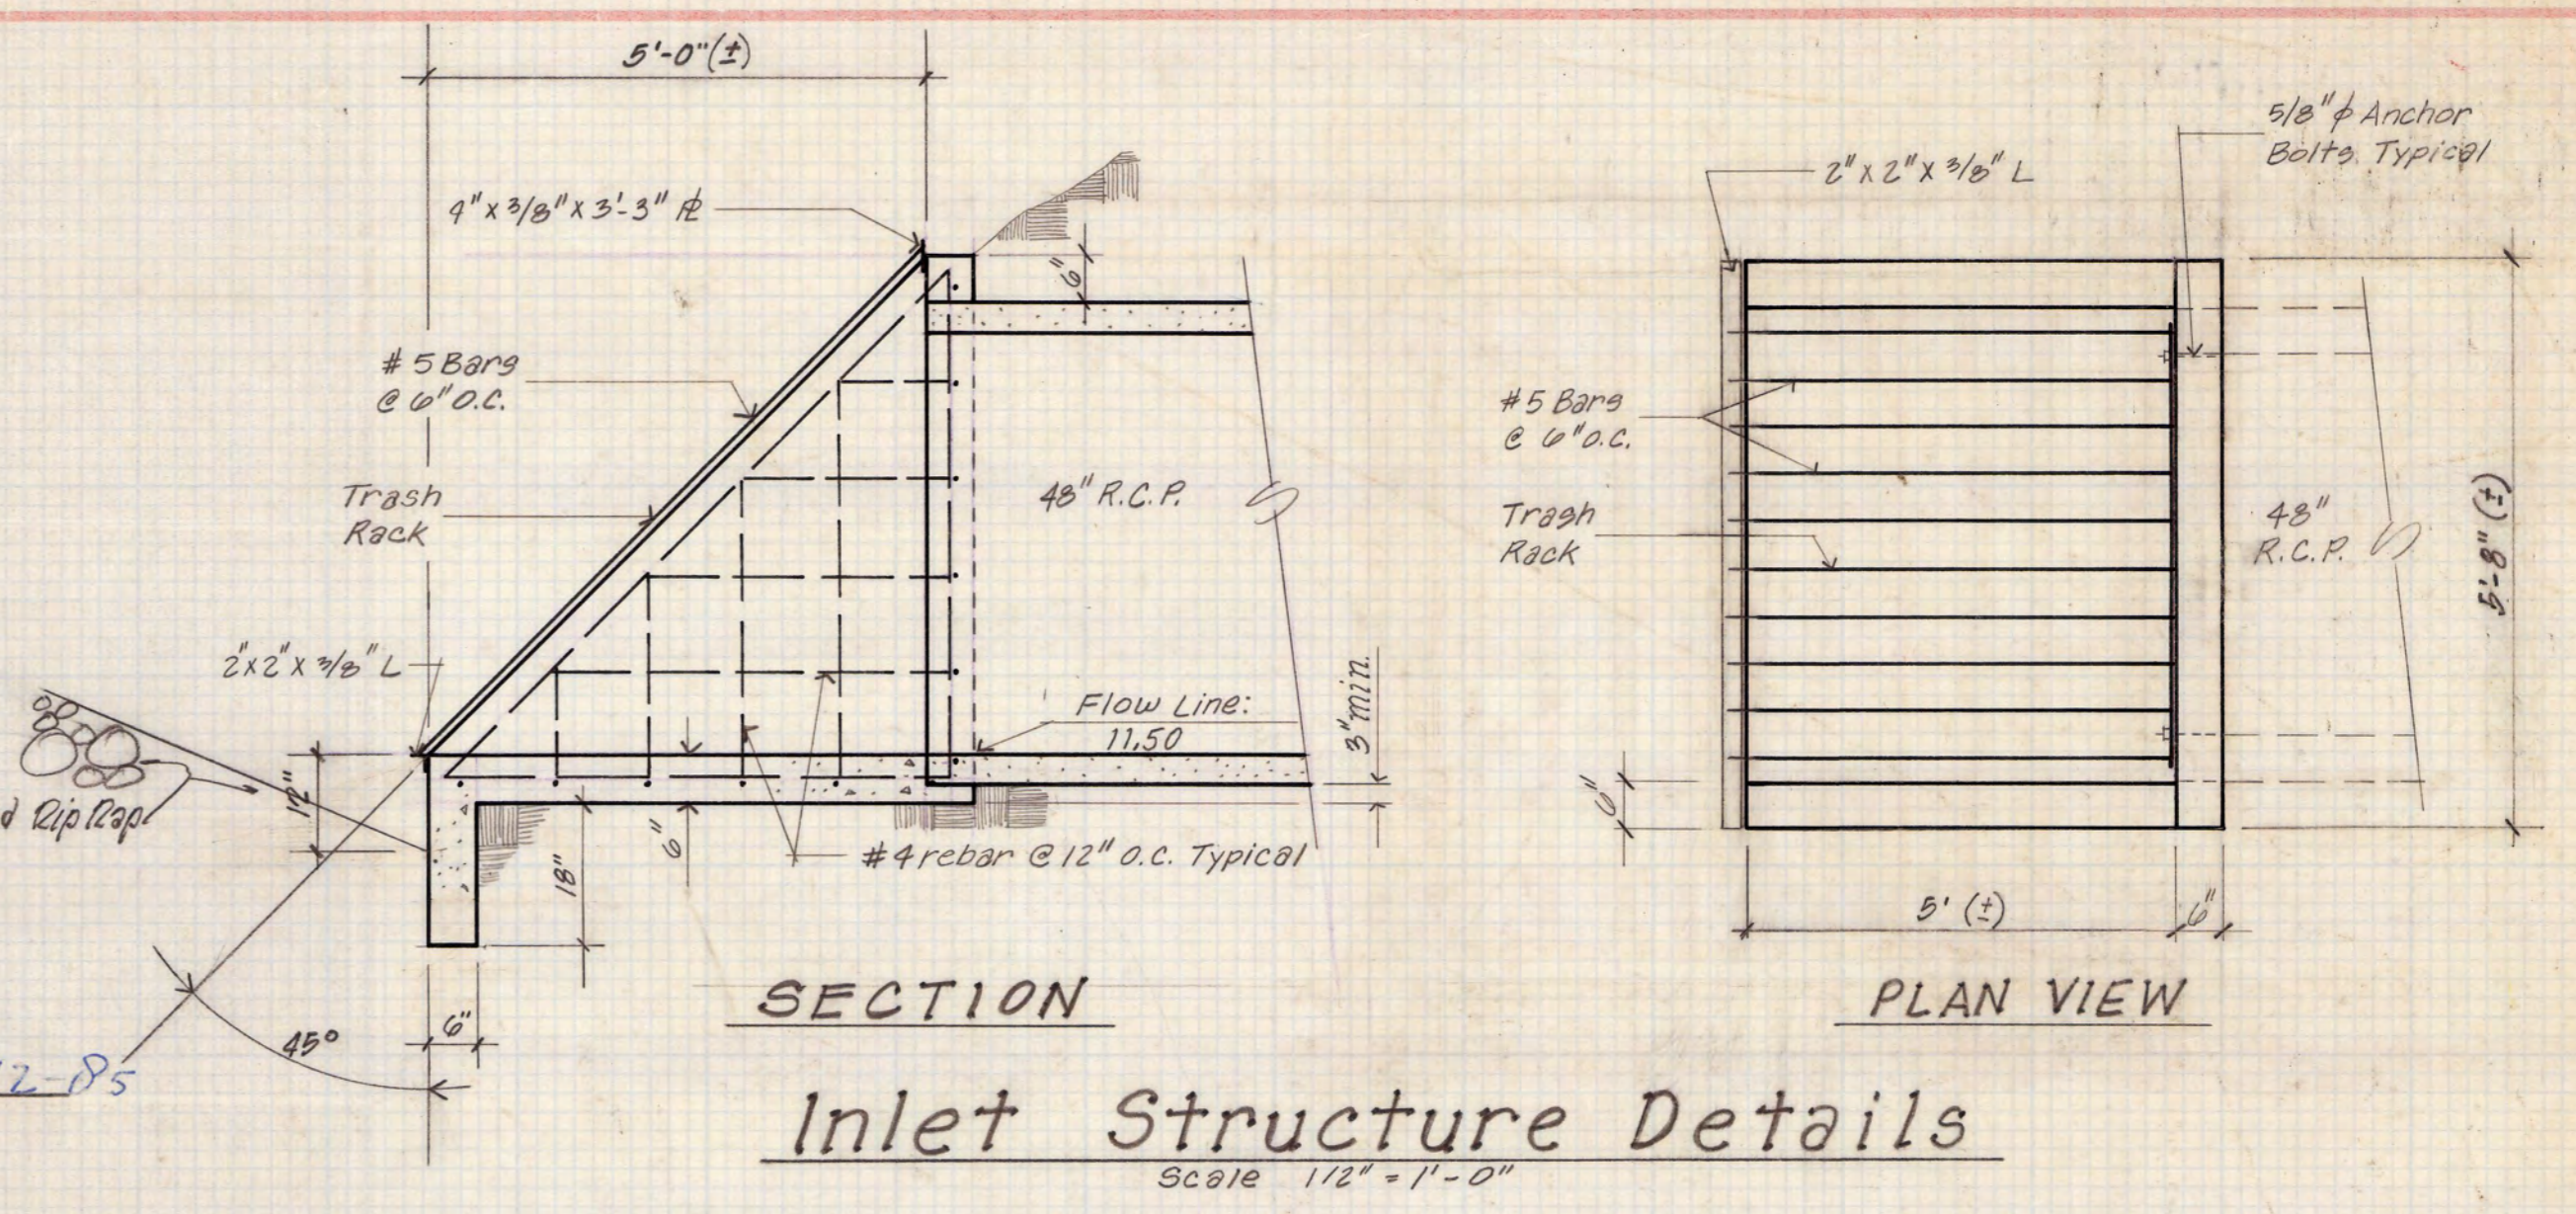

NOTES: Refer to Dwg. No. C-2025 (1-5) within specifications for Electrical & Control Details.  
2. The Electrical Service & Wiring shall be approved & inspected by S.J. County Building Dept. as part of obtaining an Electrical Permit.

SOUTH SAN JOAQUIN IRRIGATION DISTRICT		COUNTY OF SAN JOAQUIN DEPARTMENT OF PUBLIC WORKS		REVISIONS		R. W. SIEGFRIED & ASSOCIATES CONSULTING CIVIL ENGINEERS		MADONNA CONSTRUCTION CO.		SHEET 1	
* REFERENCE ABOVE		APPROVED DATE		NO. DESCRIPTION DATE BY		4045 CORONADO AVENUE, ST. ANTONIO, CALIFORNIA 95204		ROBERT LAGUE PROPERTY STORM WATER PUMPING STATION		OF ONE	
DATE		DEP. DIRECTOR OF PUBLIC WORKS R.C.E. NO. 28054		1 Record Dwg. 10x10' Conc. Sump 4/14/85 DEK		Robert A. Celum		Pump Pump Pump Control Bldg.		FILES NO. G-2957	
APPROVED REVISION						No. 17351		CHECKED RGC			

SU 1958