

AS BUILT PLANS

APPROVED _____ 19__	APPROVED _____ 19__												
<table border="1"> <thead> <tr> <th colspan="4">REVISIONS</th> </tr> <tr> <th>NO.</th> <th>DESCRIPTION</th> <th>DATE</th> <th>BY</th> </tr> </thead> <tbody> <tr> <td> </td> <td> </td> <td> </td> <td> </td> </tr> </tbody> </table>		REVISIONS				NO.	DESCRIPTION	DATE	BY				
REVISIONS													
NO.	DESCRIPTION	DATE	BY										




WONG ENGINEERS, INC.
 PLANNING • ENGINEERING • SURVEYING
 STOCKTON, CALIFORNIA
C. Change Wong
 R.C.E. NO. 14269

JOB NO.	2249
DATE	FEB. 1987
SCALE HORIZ	
SCALE VERT	
DRAWN	C.C.W.
DESIGN	
CHECK	

GARNICA COURT
DETAILS

30-1912


PRINTED ON DIBPO NO. 10000 CLEARPRINT

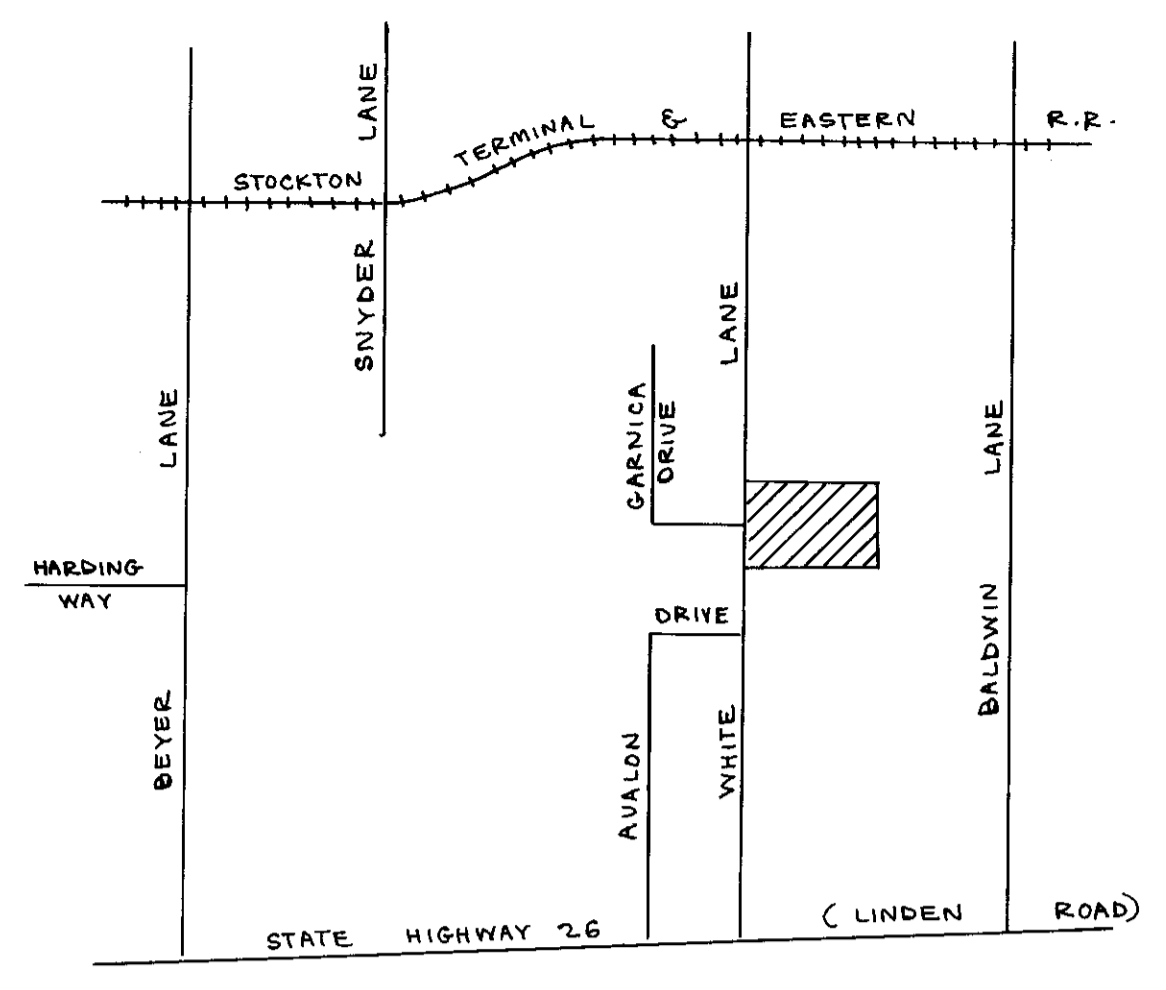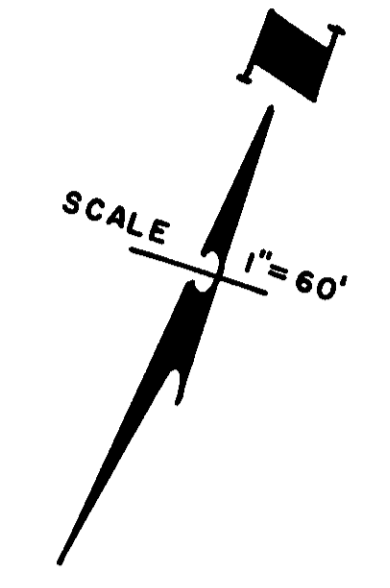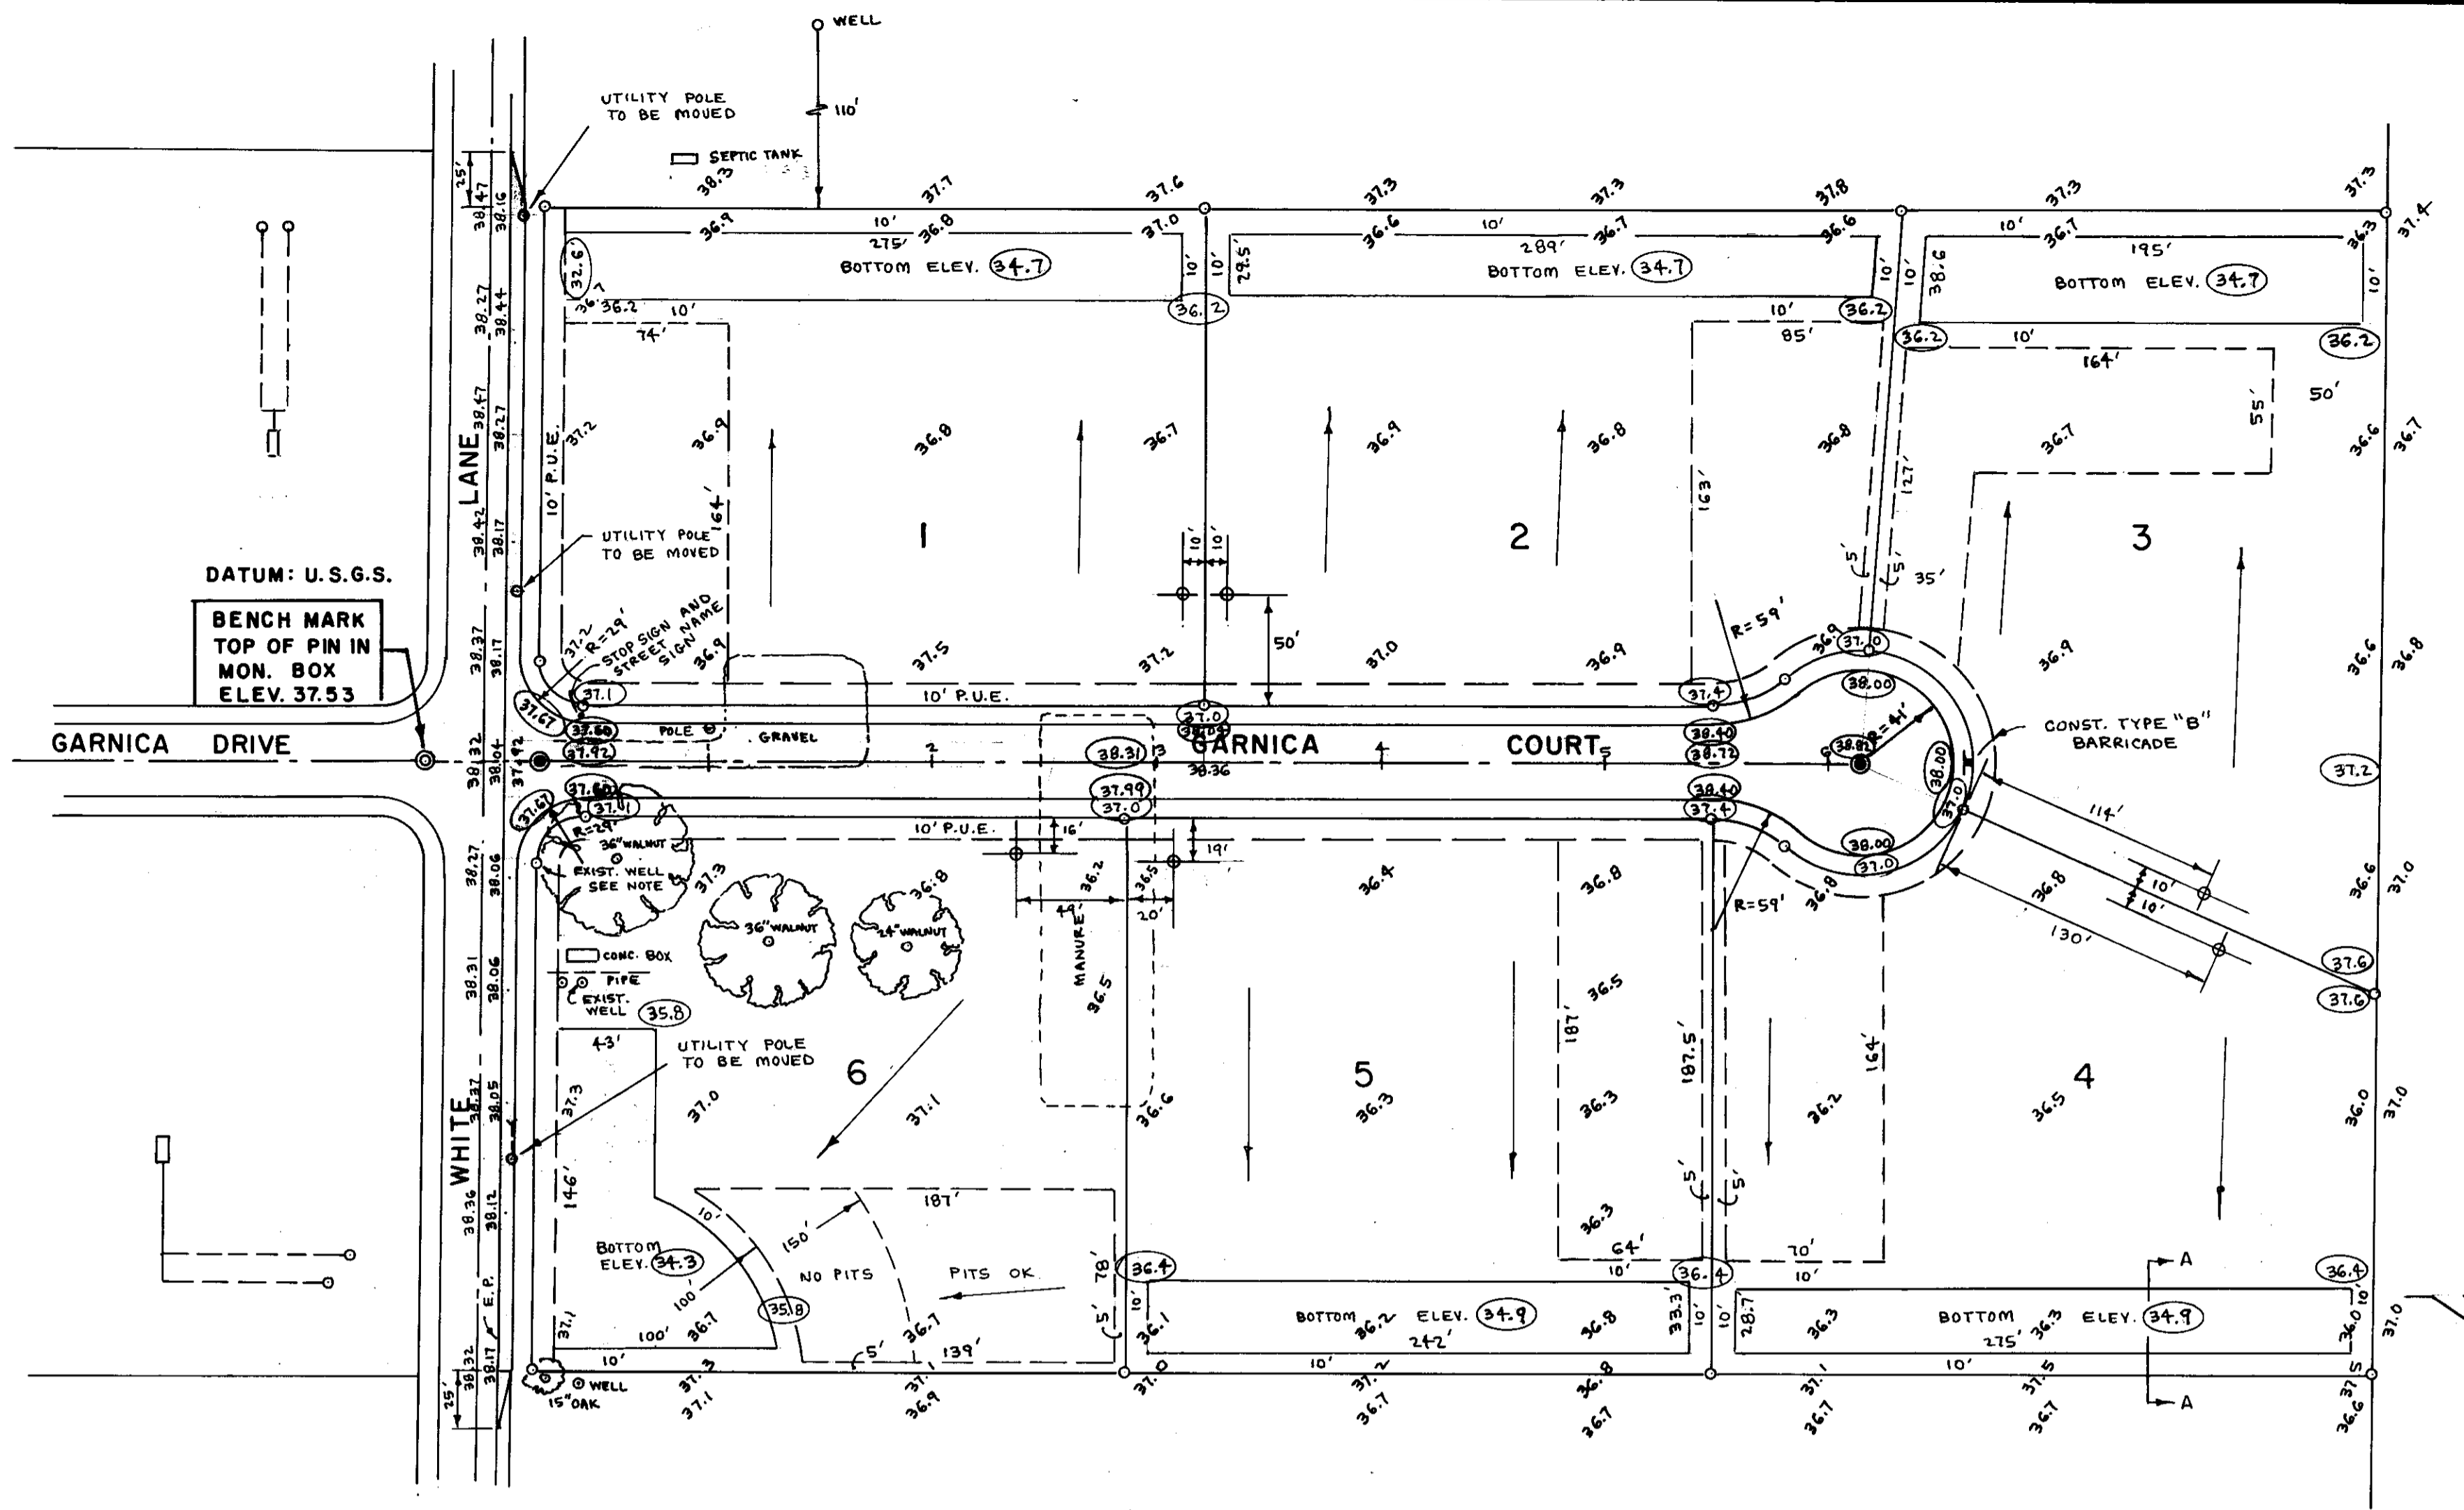

VICINITY MAP

- 36.5 FINISHED GRADE
- EXISTING ELEVATION
- ⊙ MONUMENT BOX
- ⊙ WELL SITE
- ▭ STORM DRAINAGE POND
- ▭ LEACH FIELD AREA
- ▭ 12,000 SQ. FT. PITS REQUIRED
- ▭ SEWAGE DRAINAGE
- ▭ SEPTIC TANKS
- ▭ PRIVATE WELLS
- ▭ INDIVIDUAL PONDS

NOTE: THE EXISTING WELL ON THE NEW WHITE LANE RIGHT OF WAY LINE SHALL BE DESTROYED UNDER PERMIT AND INSPECTION OF SAN JOAQUIN LOCAL HEALTH DISTRICT

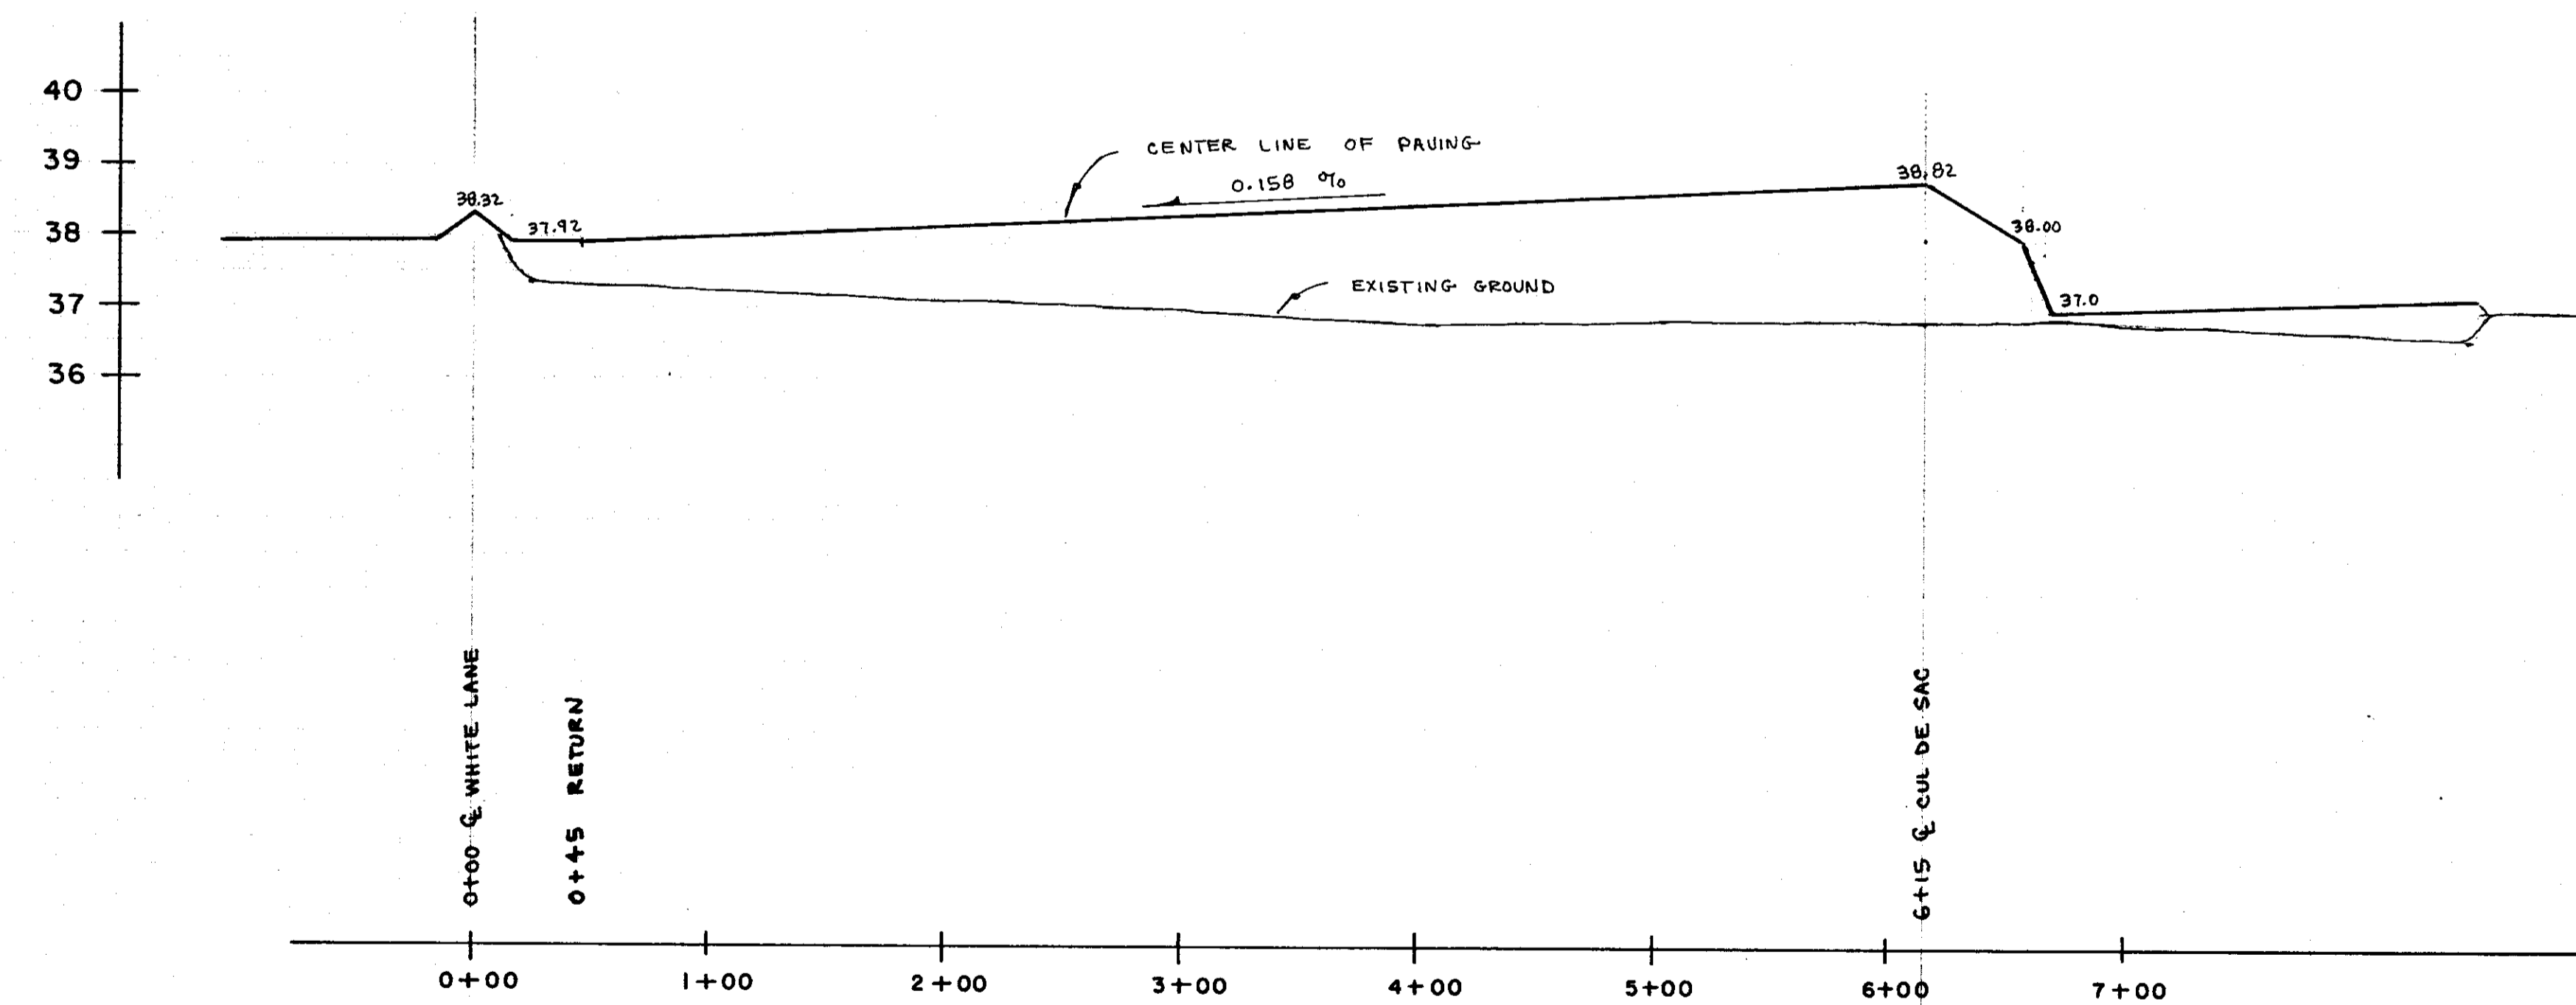

AS BUILT PLANS

SU-1913

APPROVED *April 7* 19 *87*
Henry M. Hirata
 SAN JOAQUIN LOCAL HEALTH DISTRICT

APPROVED *May 12* 19 *87*
Henry M. Hirata
 HENRY M. HIRATA, DIRECTOR OF PUBLIC WORKS
 SAN JOAQUIN COUNTY R.C.E. 21,258

REVISIONS			
NO.	DESCRIPTION	DATE	BY

WONG ENGINEERS, INC.
 PLANNING • ENGINEERING • SURVEYING
 STOCKTON, CALIFORNIA
C. Chance Wong R.C.E. NO. 14269

JOB NO. 2249
 DATE FEB. 1987
 SCALE HORIZ 1" = 60'
 SCALE VERT
 DRAWN C.C.W.
 DESIGN
 CHECK

**GARNICA COURT
 IMPROVEMENT PLAN**

SHEET
1
 OF TWO
 FILE