




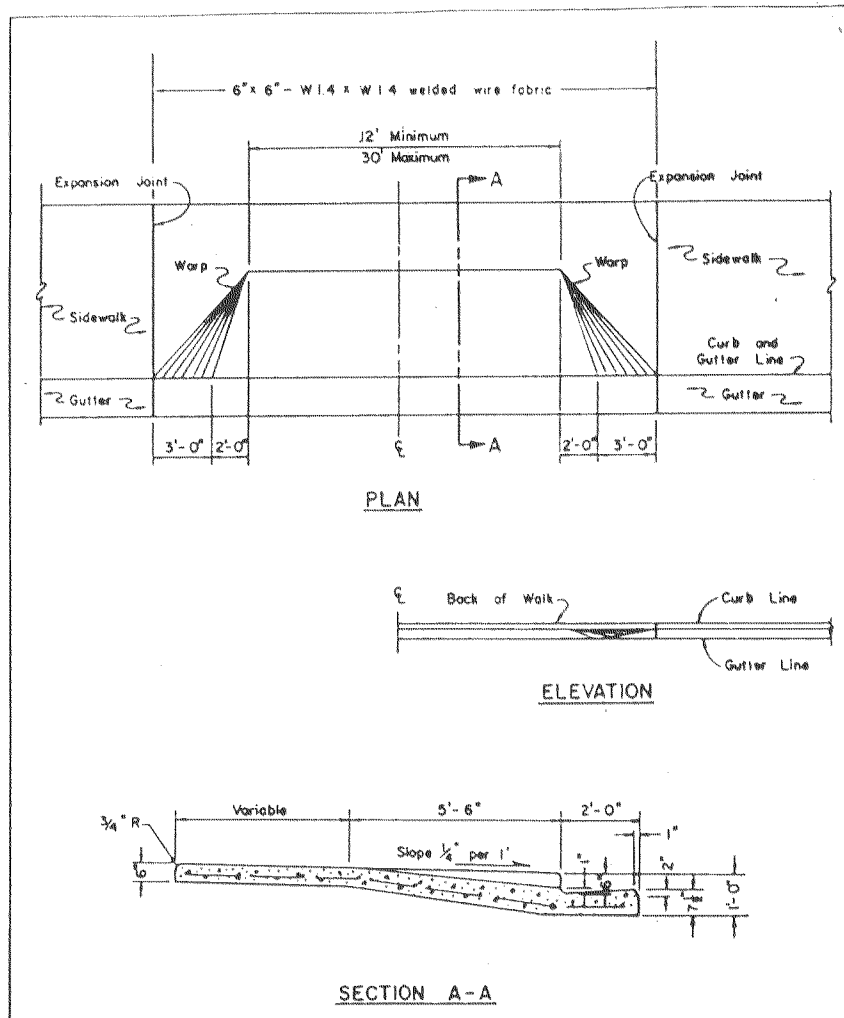


NO.	REVISED	DATE	DESCRIPTION
1			
2			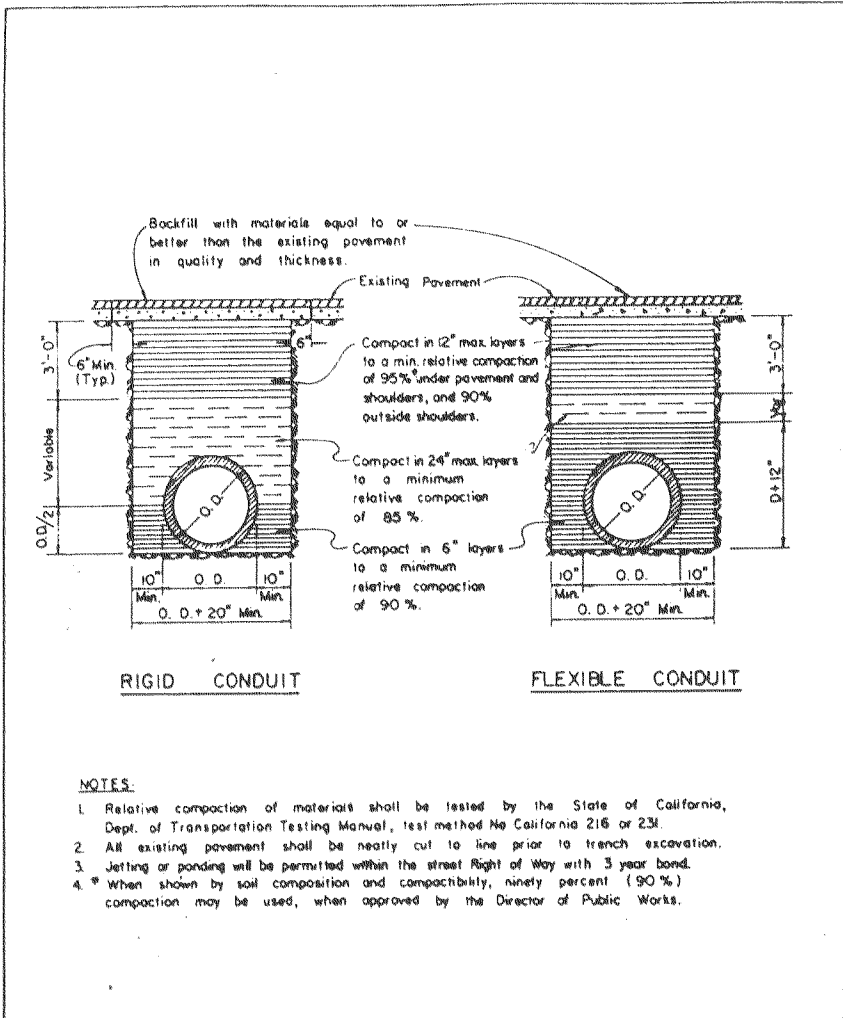
NO.	REVISED	DATE	DESCRIPTION
1			
2			
3			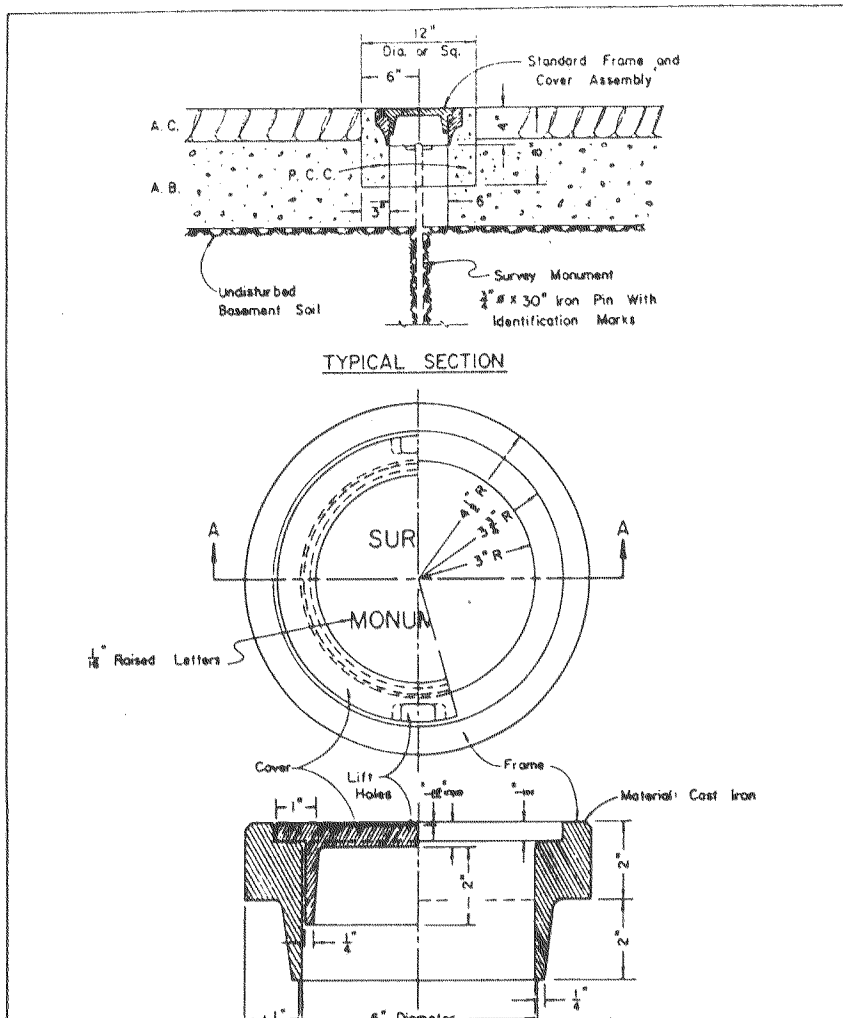
NO.	REVISED	DATE	DESCRIPTION
1			
2			
3			
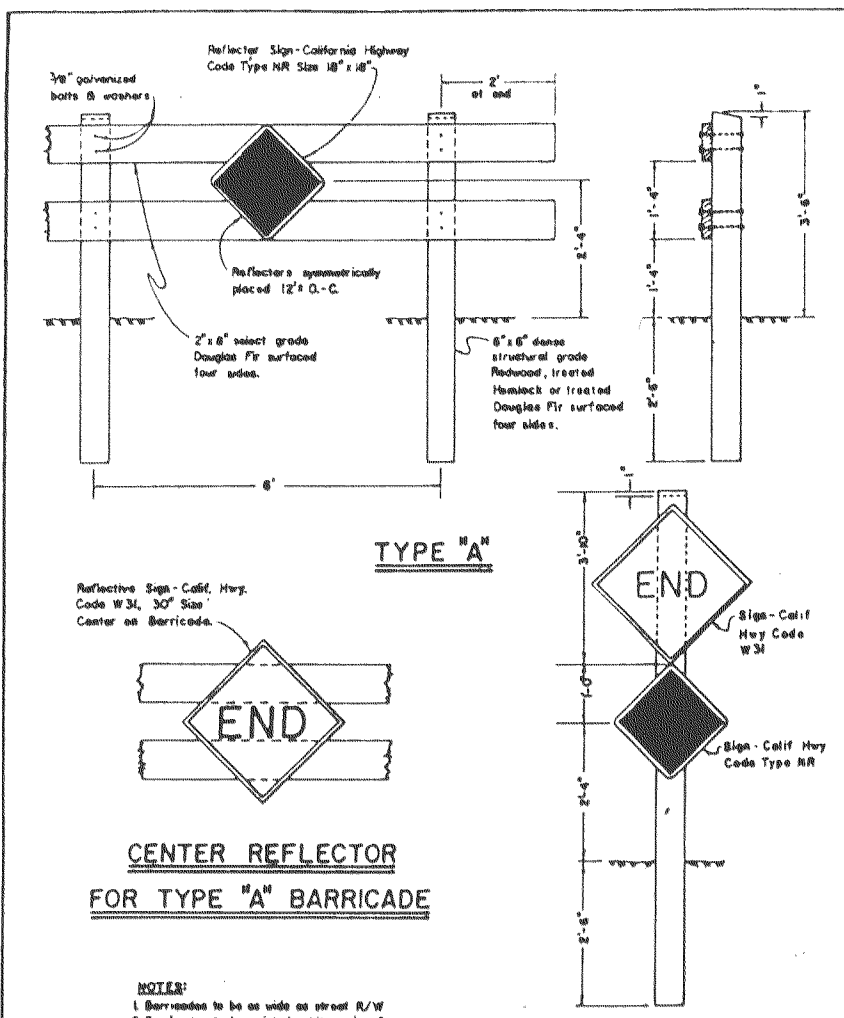

NO.	REVISED	DATE	DESCRIPTION
1			
2			
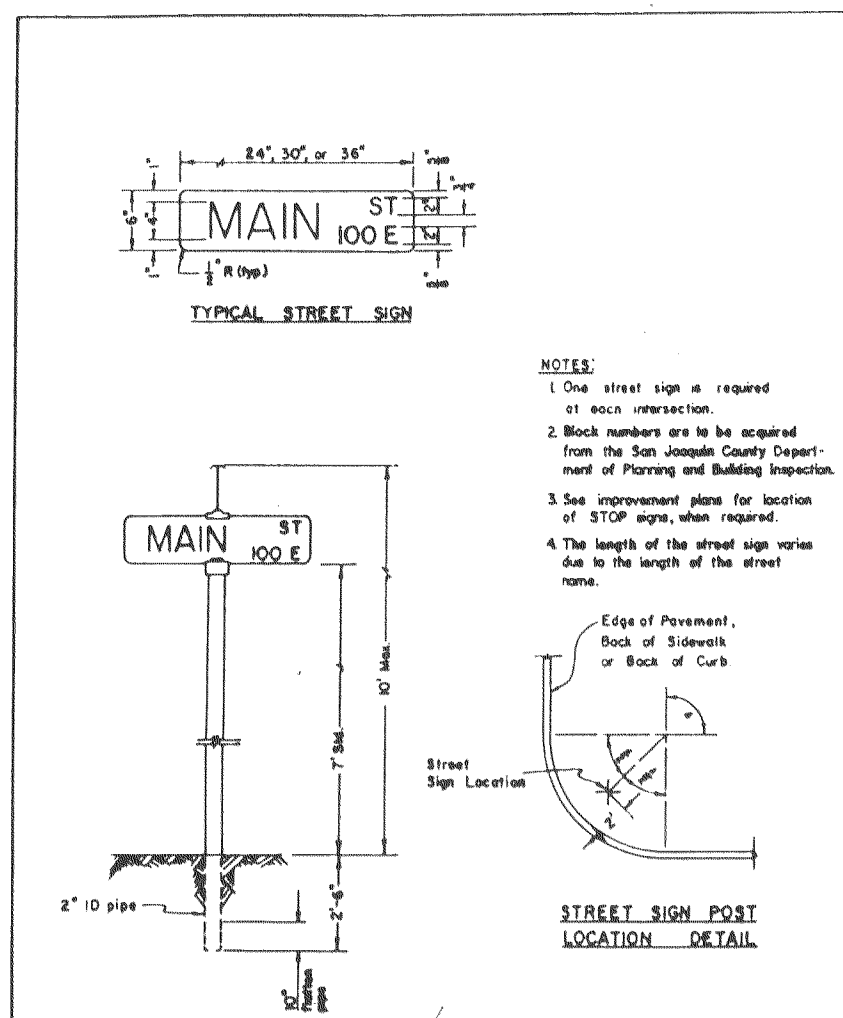

BY	REVISION	DATE
1	Issued for a full set of Standard details	1/25/68
2	Revised to show new	1/25/68
3	Revised to show new	1/25/68
STANDARD STREET

SIGN DETAILS


COUNTY OF SAN JOAQUIN
DEPARTMENT OF PUBLIC WORKS

APPROVED BY

J. W. SMITH
COUNTY ENGINEER

STANDARD NO. A-10

SU-2049

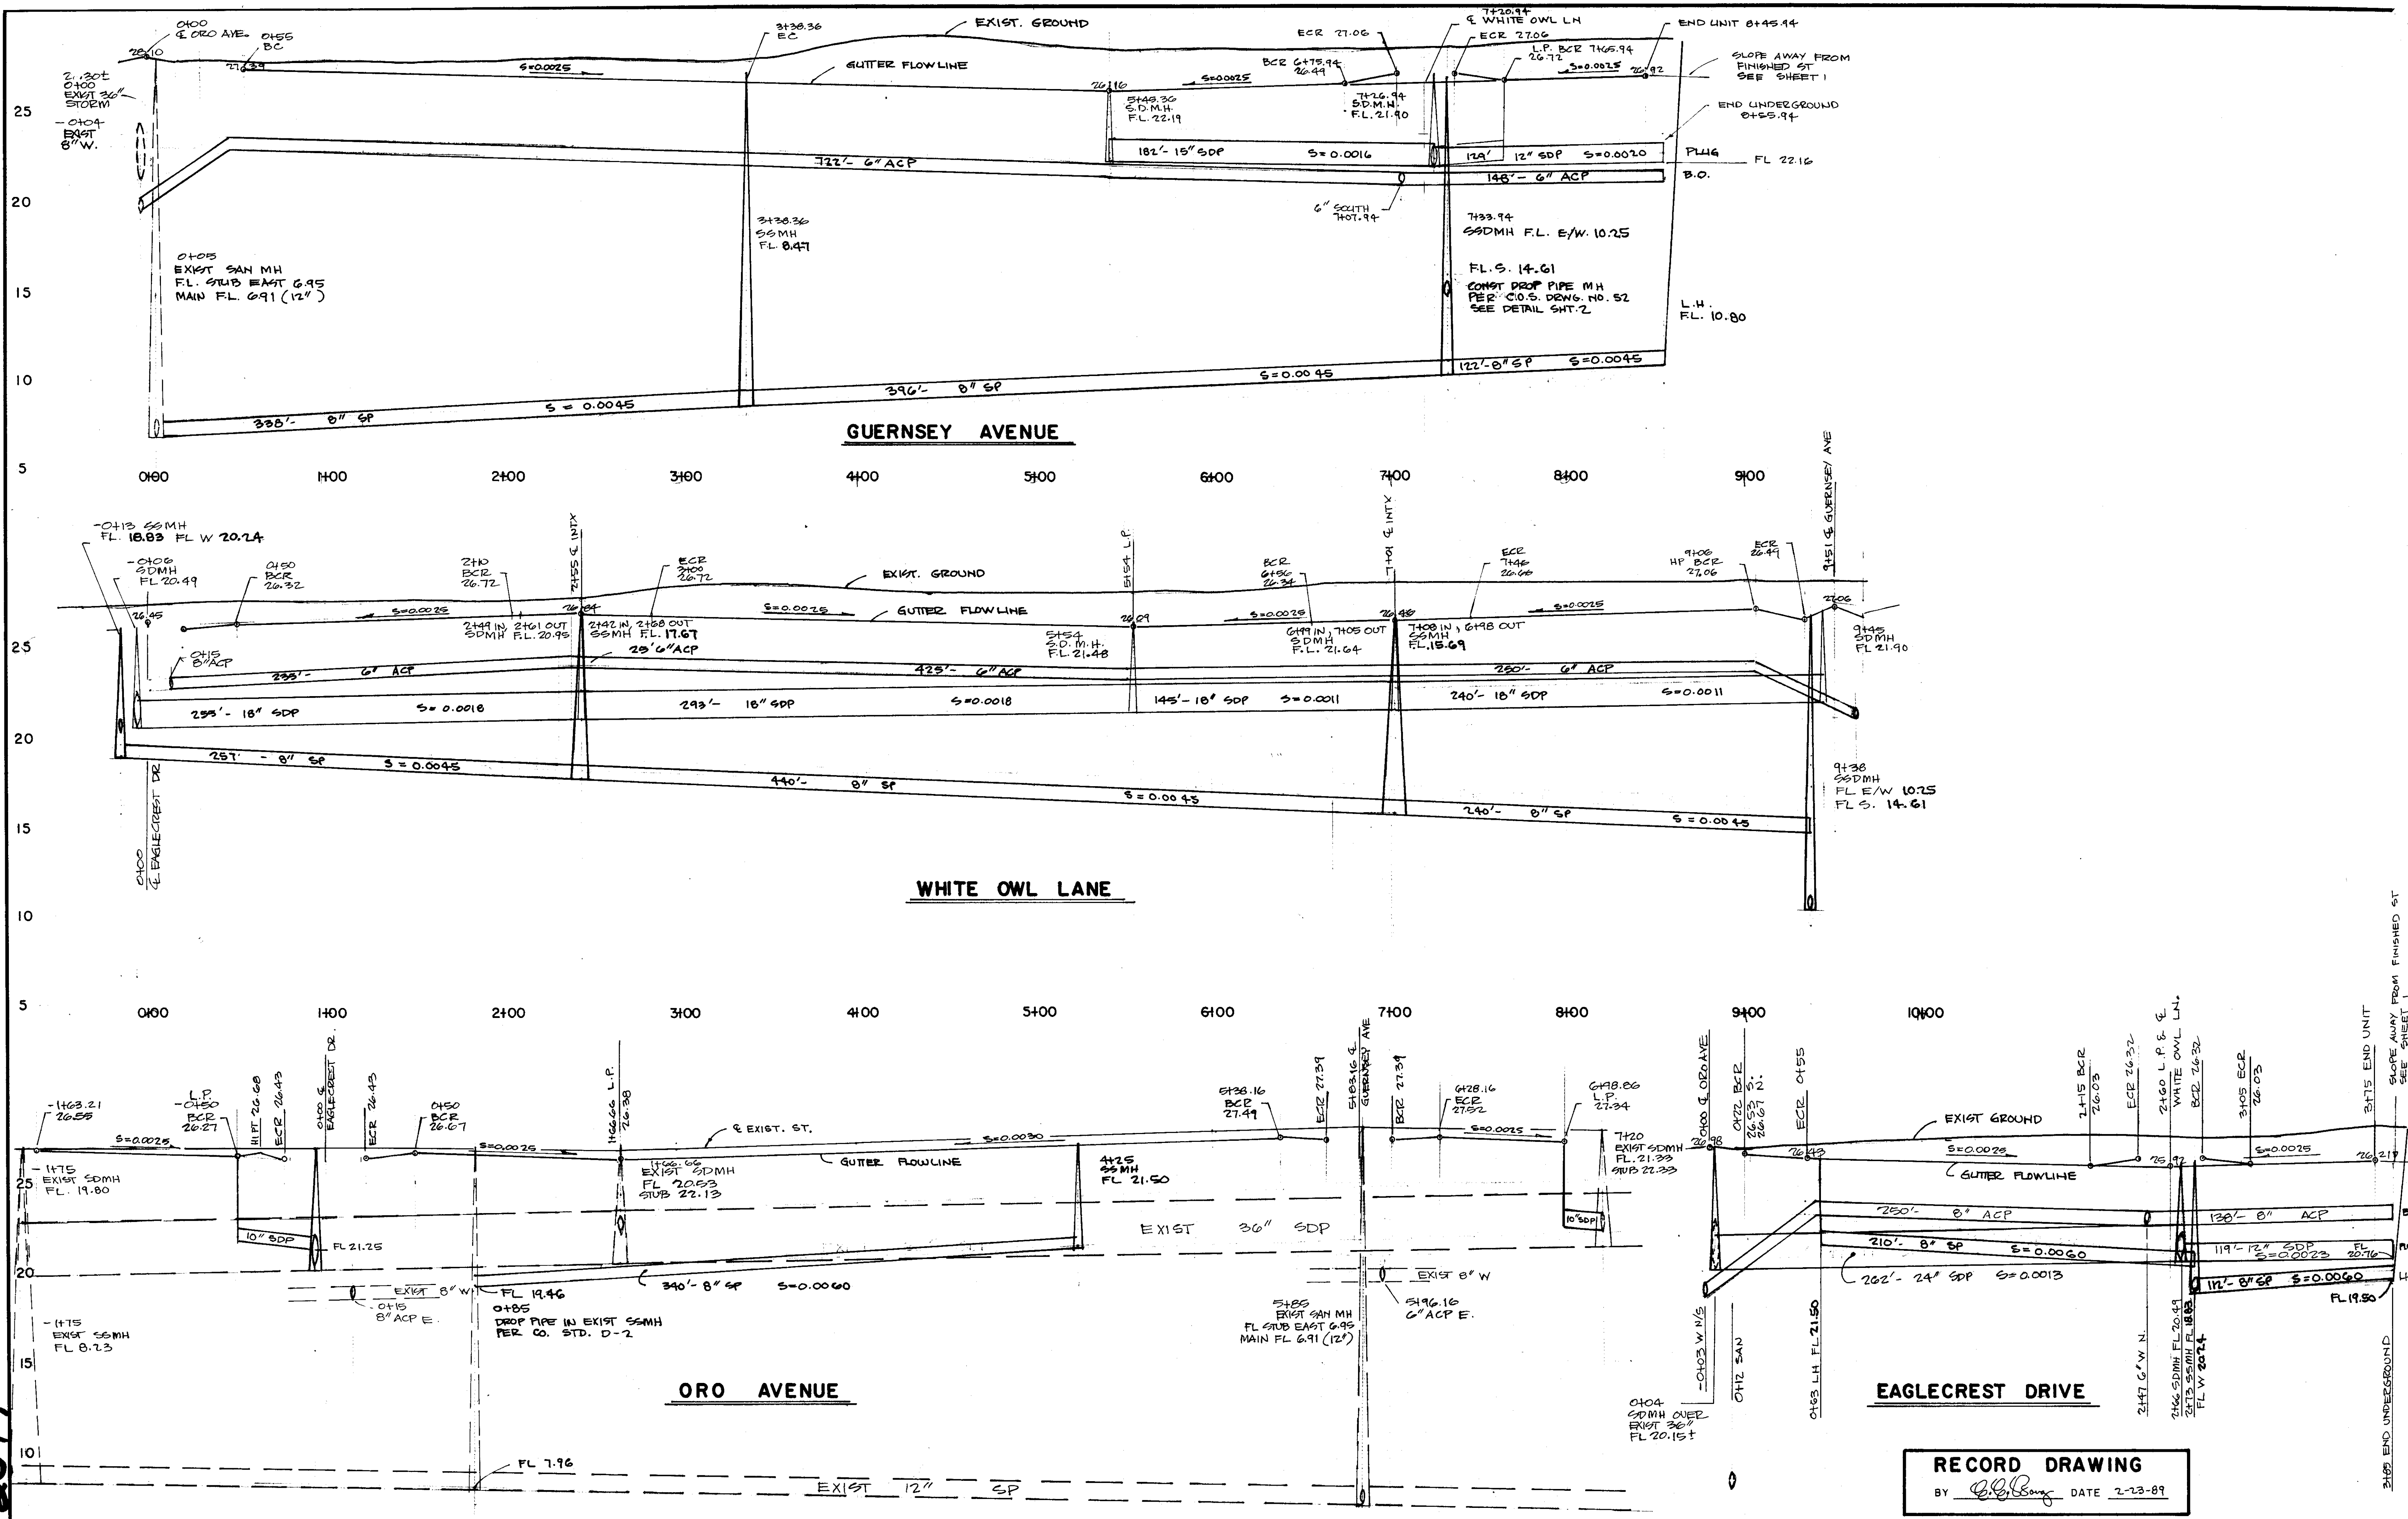


RECORD DRAWING
BY *[Signature]* DATE 2-23-89

APPROVED _____ 19__	APPROVED SANITARY SEWER ONLY 6/14 19 88 <i>[Signature]</i> JAMES B. GIOTTONINI, CITY ENGINEER	NO. _____	DESCRIPTION REVISE SEWER SLOPE, SIZE, DROP M.H.	DATE 6-11-88	BY B.P.	APPROVED <i>[Signature]</i>	WONG ENGINEERS, INC. PLANNING • ENGINEERING • SURVEYING STOCKTON, CALIFORNIA <i>[Signature]</i>	NO. 14 269 EXPIRES 3-31-89 NO. 14 268 CIVIL OF CALIFORNIA	JOB NO. 2364 DATE OCT. 1987 SCALE HORIZ 1" = 40' SCALE VERT 1" = 4' DRAWN <i>[Signature]</i> DESIGN WE CHECK	EAGLECREST / UNIT ONE STOCKTON, CALIFORNIA PROFILE SHEET	SHEET 3 OF FOUR FILE
---------------------	---	-----------	--	-----------------	------------	--------------------------------	--	---	--	--	----------------------------

3151.1 C

SV-2050


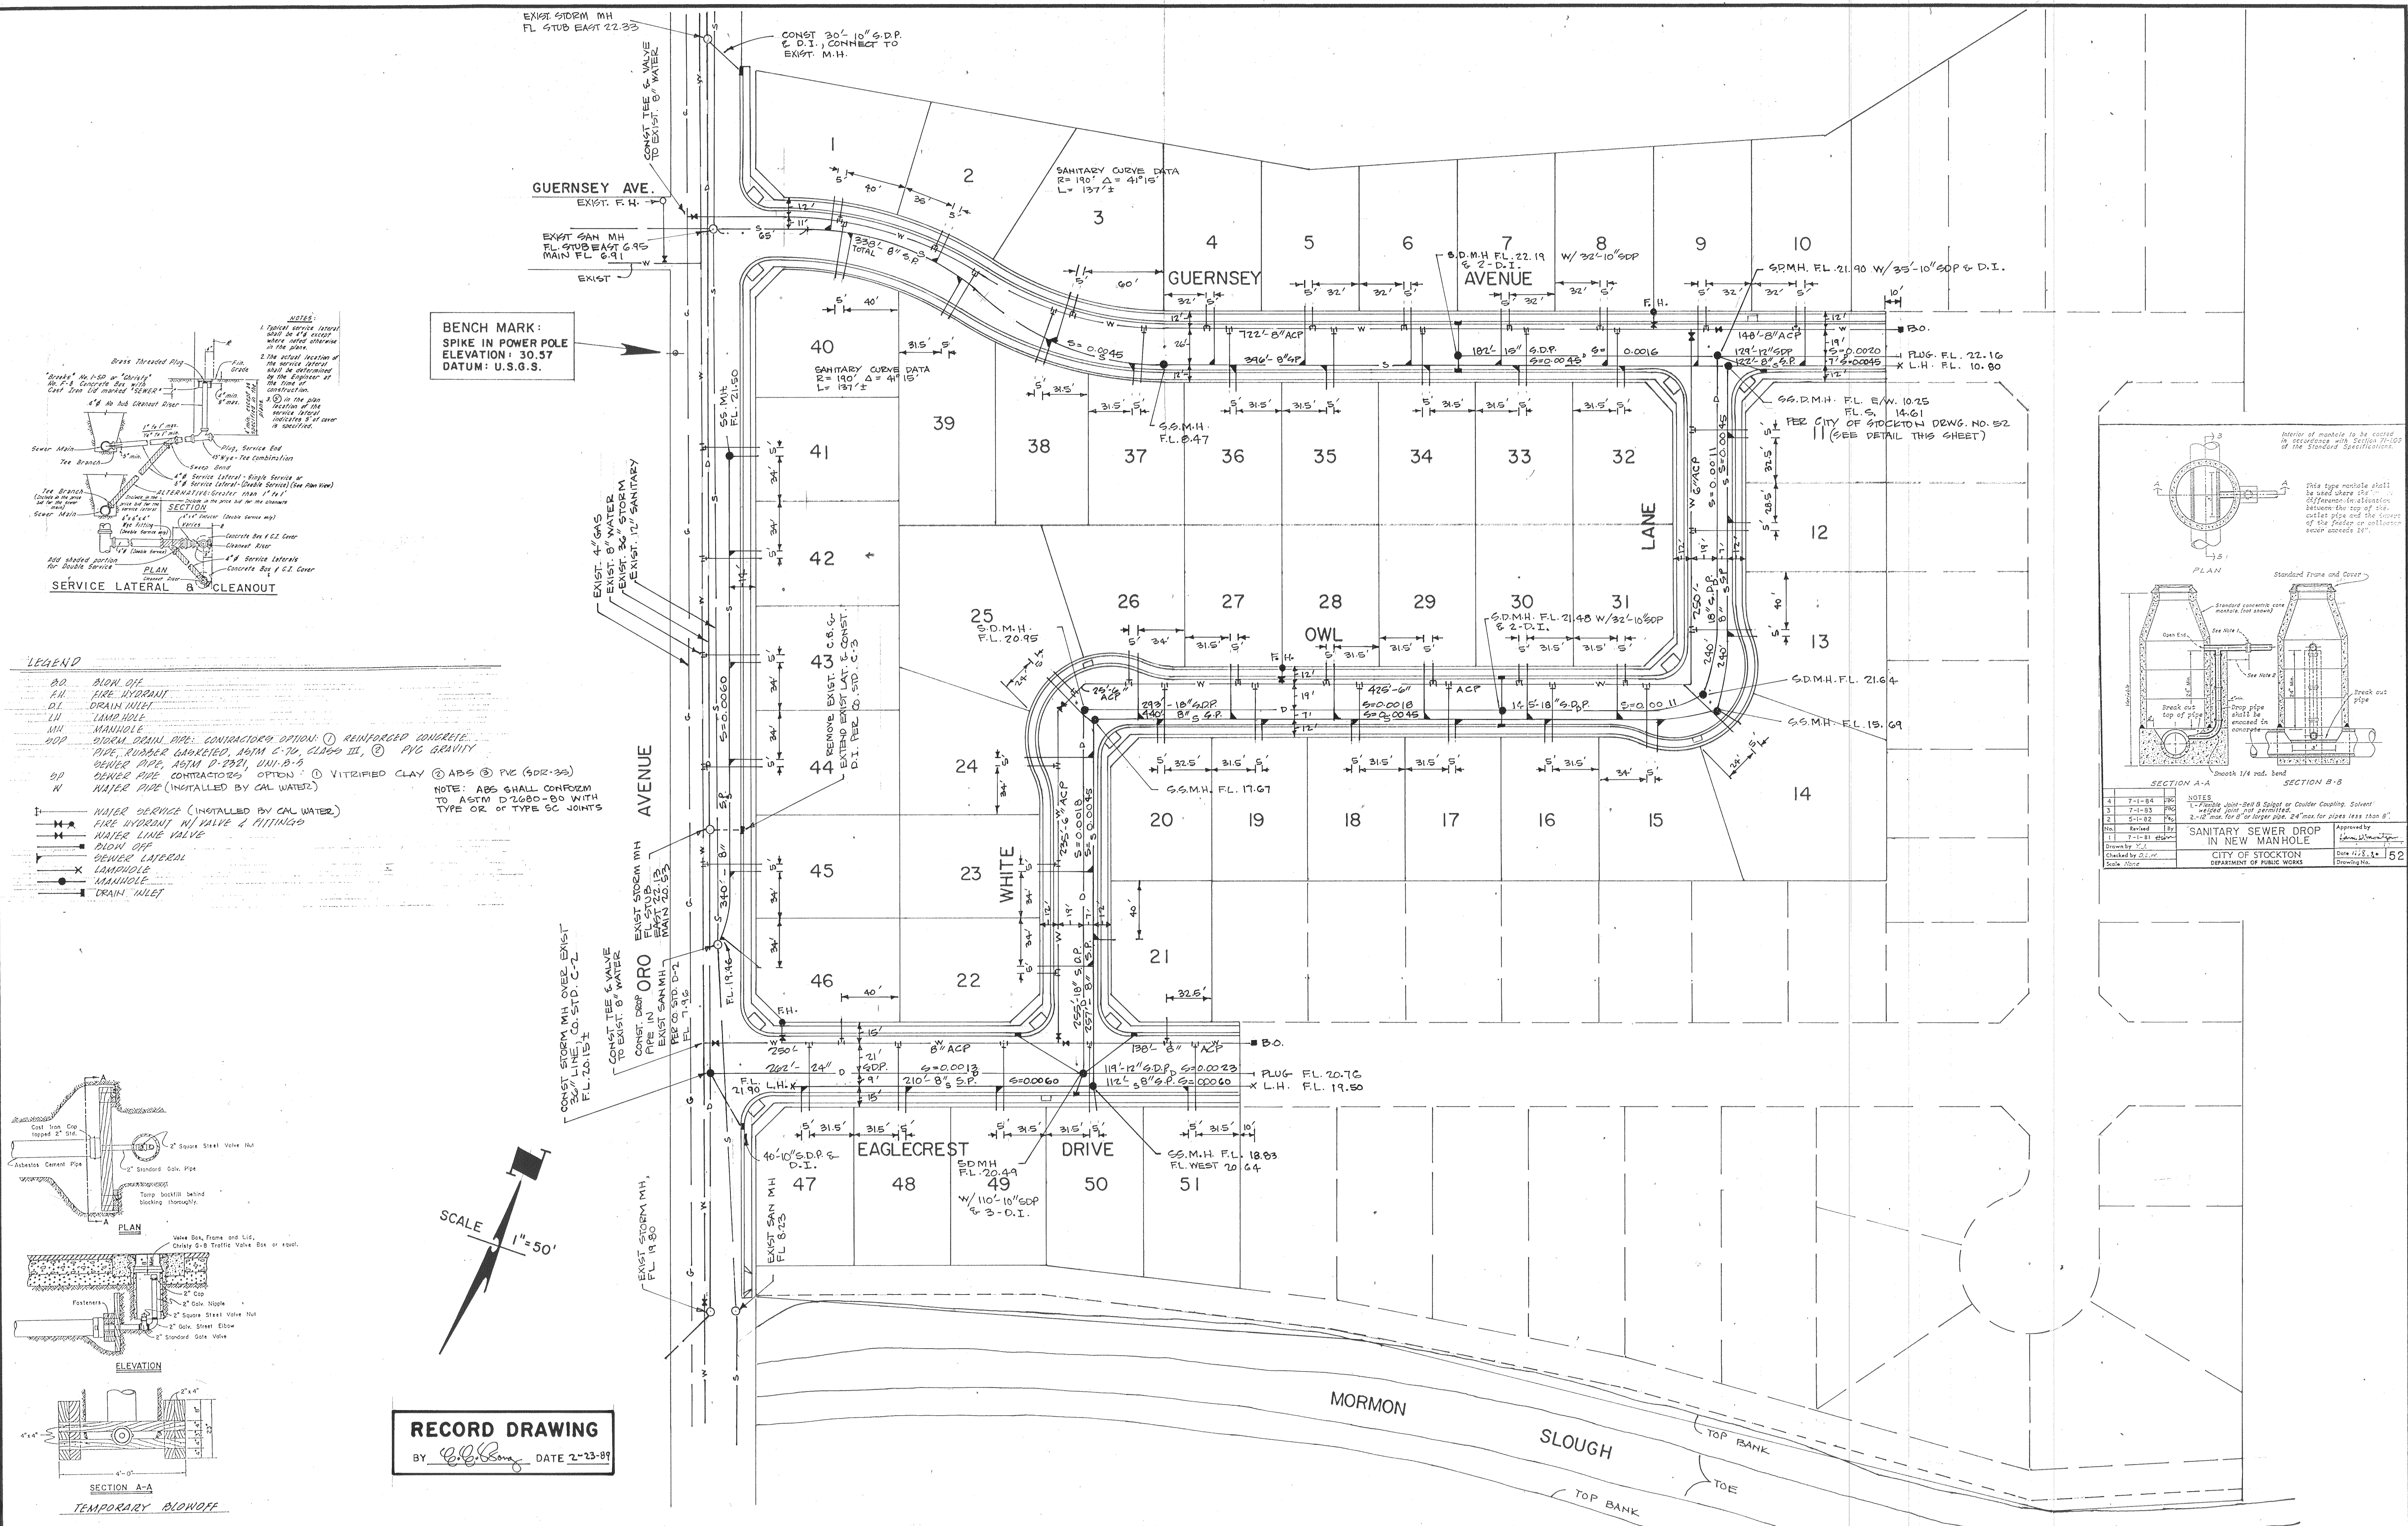


RECORD DRAWING
BY *[Signature]* DATE 2-23-89

APPROVED _____ 19__		APPROVED SANITARY SEWER ONLY <u>6/14</u> 19 <u>88</u>		REVISIONS				 WONG ENGINEERS, INC. PLANNING • ENGINEERING • SURVEYING STOCKTON, CALIFORNIA 		JOB NO. <u>2364</u>		EAGLECREST / UNIT ONE		STOCKTON, CALIFORNIA		SHEET <u>2</u>															
				NO.		DESCRIPTION				DATE		BY		APPD		DATE		OCT. 1987		SCALE HORIZ 1" = 50'		SCALE VERT		DRAWN <u>JD</u>		DESIGN <u>WE</u>		CHECK		UNDERGROUND IMPROVEMENT PLAN	
						REUSE SEWER SLOPE, SIZE, DROP M.H.		6-11-88		B.P.		 JAMES B. GIOTTONINI, CITY ENGINEER																FILE			

3151 C

SU-2051

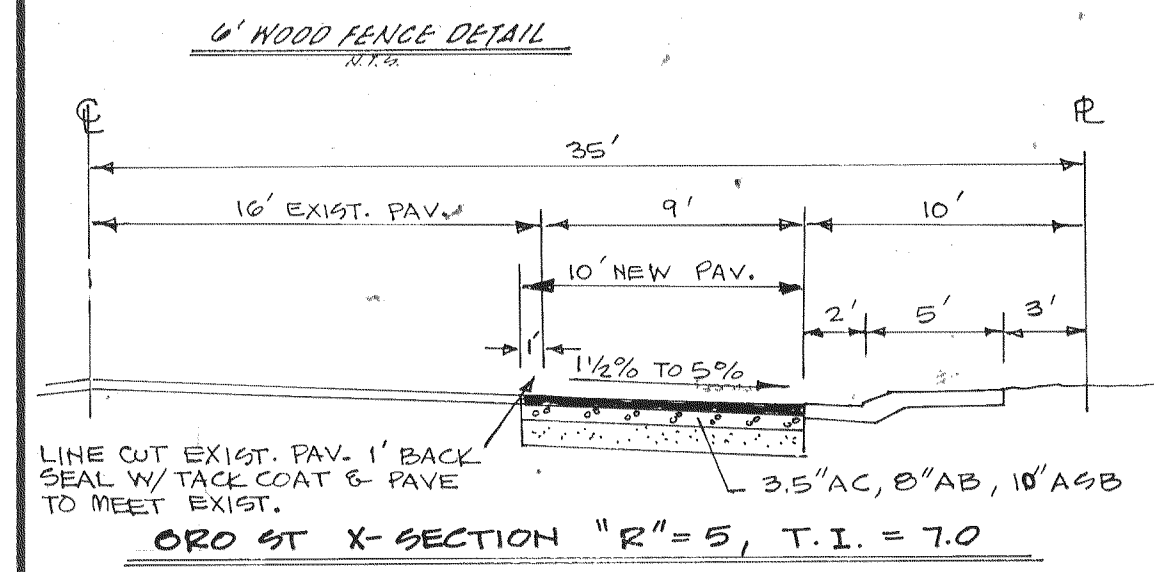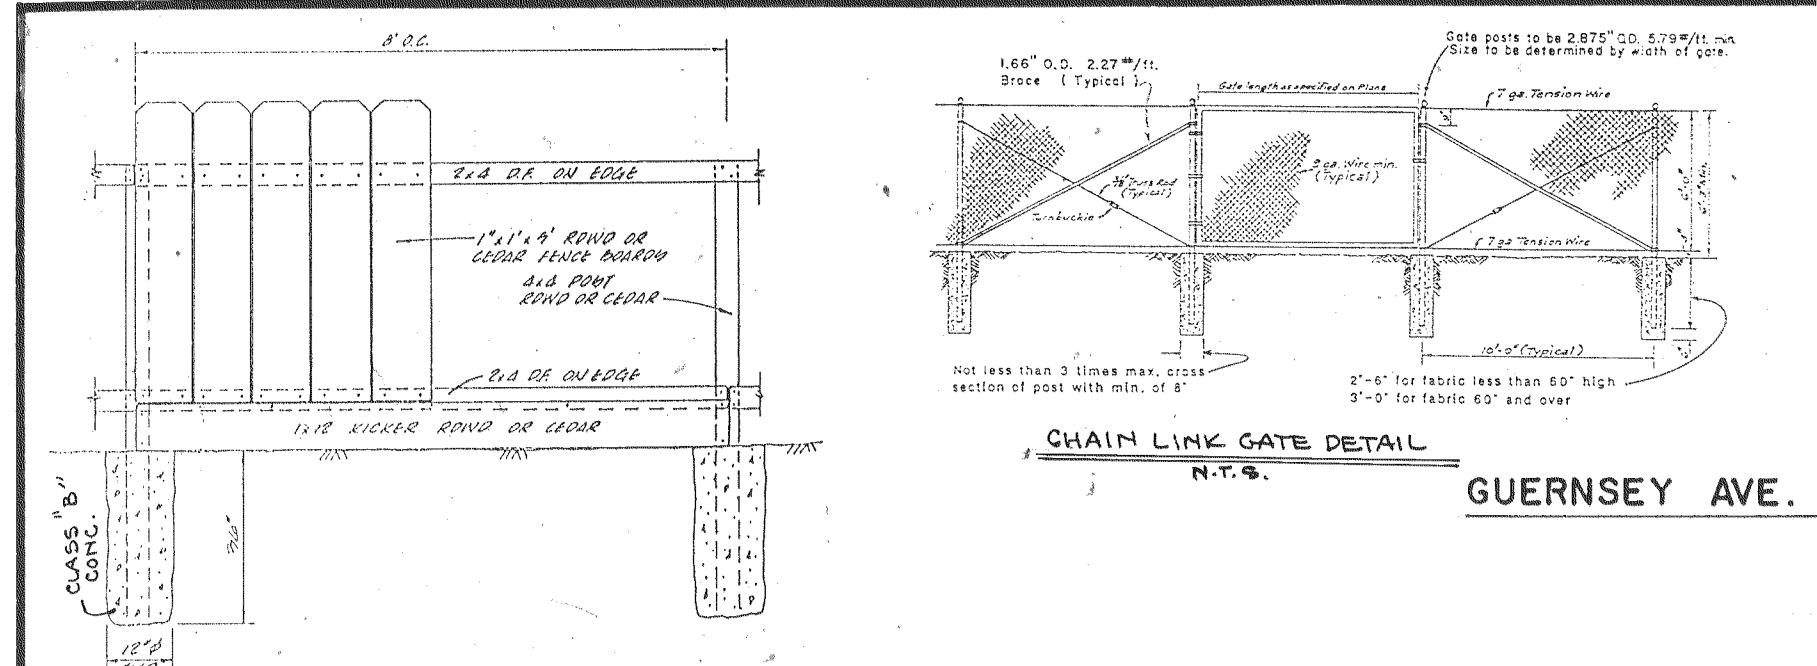

BENCH MARK:
SPIKE IN POWER POLE
ELEVATION: 30.57
DATUM: U.S.G.S.

DISTRICTS SUPPLYING SERVICES

WATER CALIFORNIA WATER SERVICE
SEWER EAST STOCKTON SANITARY DISTRICT NO. 51
STORM COUNTY SERVICE AREA NO. 41
STREET LIGHTS COUNTY SERVICE AREA NO. 41
FIRE CITY OF STOCKTON FIRE DEPARTMENT

SHEET INDEX

SHEET 1 STREET IMPROVEMENT AND GRADING PLAN
2 UNDERGROUND IMPROVEMENT PLAN
3 PROFILE SHEET
4 DETAIL SHEET



LEGEND

▲ STREET LIGHT LOCATIONS - H.P.S.V. LAMPS PER P.G.&E. REQ'TS.
● R-1 STOP SIGN & STREET SIGN
○ CENTER LINE MONUMENT - SEE DETAIL
○ WHEEL CHAIR RAMP - SEE DETAIL
○ BARRICADE - SEE DETAIL
○ EXIST. GROUND (TYP.)
○ BACK OF LOT/HOUSE PAD GRADE (TYP.)
○ B.S.B.L. BUILDING SET BACK LINE


NOTES:

1- AT THE TIME OF ACCEPTANCE OF IMPROVEMENTS, THE RESOLUTION OF ACCEPTANCE SHOULD INCLUDE THAT EAGLECREST DRIVE AND GUERNSEY AVENUE AT WHITE OWL LANE ARE DECLARED THROUGH HIGHWAYS.
2- STREET SIGNS AND MARKINGS SHALL CONFORM TO THE UNIFORM TRAFFIC CONTROL REQUIREMENTS.

ST. NAME	T.I.	R	A.C.	A.B.	A.S.B.
ORO ST.	7.0	5	3 1/2"	8"	10"
EAGLECREST DR.	6.0	5	3 1/2"	6"	8"
GUERNSEY AVE.	5.0	5	2"	6"	7"
WHITE OWL LN.	4.0	5	2"	4"	6"

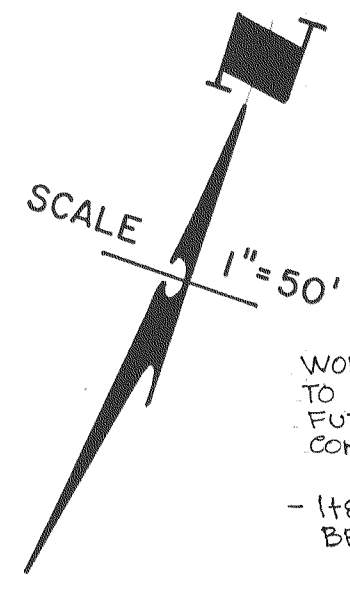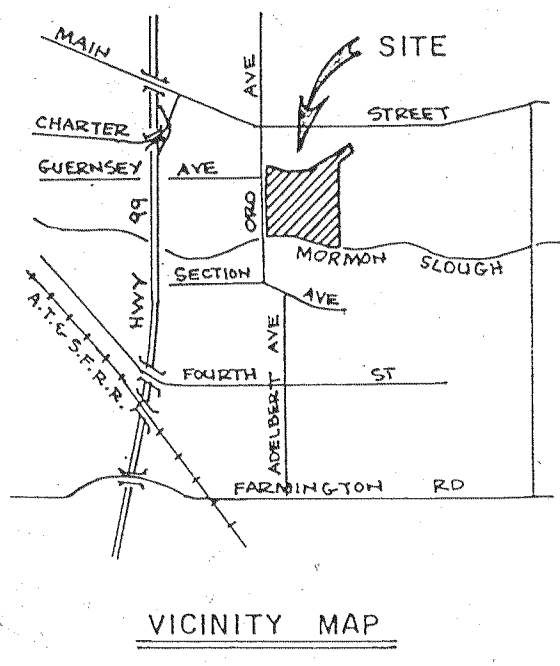

RECORD DRAWING
BY *[Signature]* DATE 2-23-89

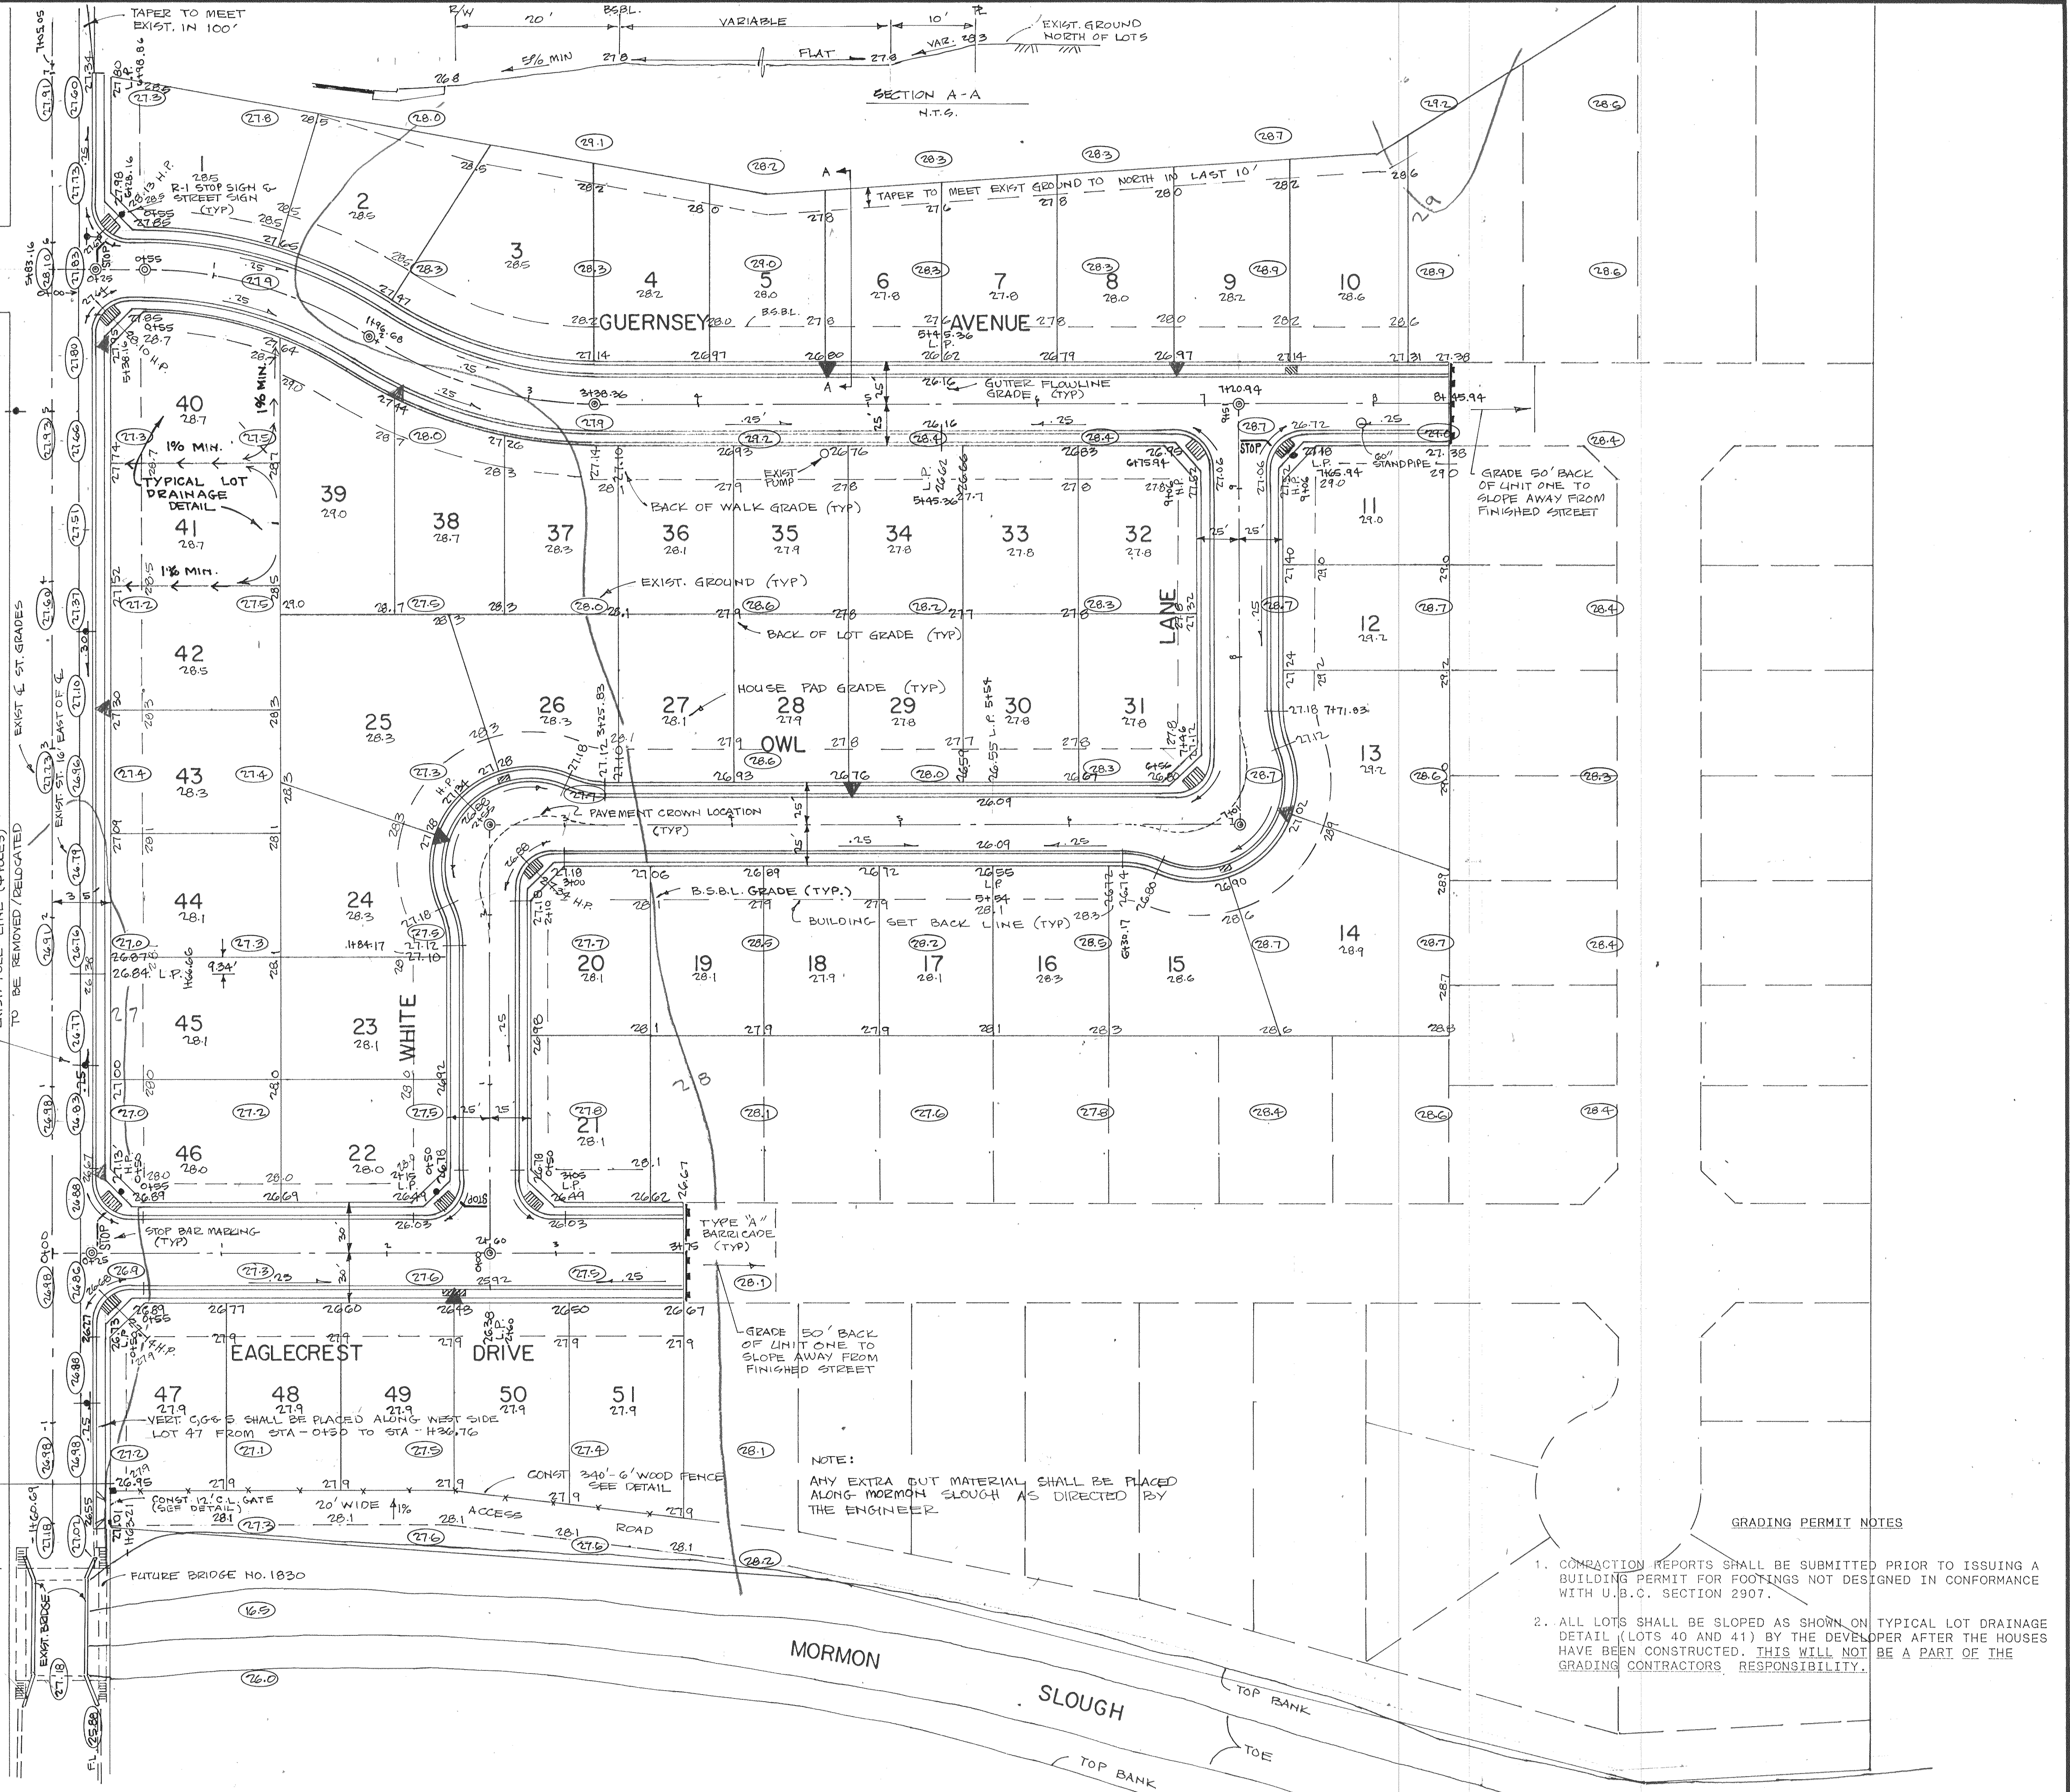

GRADING PERMIT NOTES
1. CONSTRUCTION REPORTS SHALL BE SUBMITTED PRIOR TO ISSUING A BUILDING PERMIT FOR FOOTINGS NOT DESIGNED IN CONFORMANCE WITH U.B.C. SECTION 2907.
2. ALL LOTS SHALL BE SLOPED AS SHOWN ON TYPICAL LOT DRAINAGE DETAIL (LOTS 40 AND 41) BY THE DEVELOPER AFTER THE HOUSES HAVE BEEN CONSTRUCTED. THIS WILL NOT BE A PART OF THE GRADING CONTRACTORS' RESPONSIBILITY.

APPROVED _____ 19__	APPROVED <i>May 4</i> 1988	REVISIONS NO. DESCRIPTION DATE BY	WONG ENGINEERS, INC. PLANNING • ENGINEERING • SURVEYING STOCKTON, CALIFORNIA <i>[Signature]</i> R.C.E. NO. 14269	JOB NO. 2364 DATE OCT. 1987 SCALE HORIZ 1"=50' SCALE VERT 1"=10' DRAWN <i>[Signature]</i> DESIGN WE CHECK	EAGLECREST UNIT ONE STREET IMPROVEMENT AND GRADING PLAN STOCKTON, CALIFORNIA	SHEET 1 OF FOUR FILE
---------------------	----------------------------	--------------------------------------	--	---	--	-------------------------------