



SU-2239

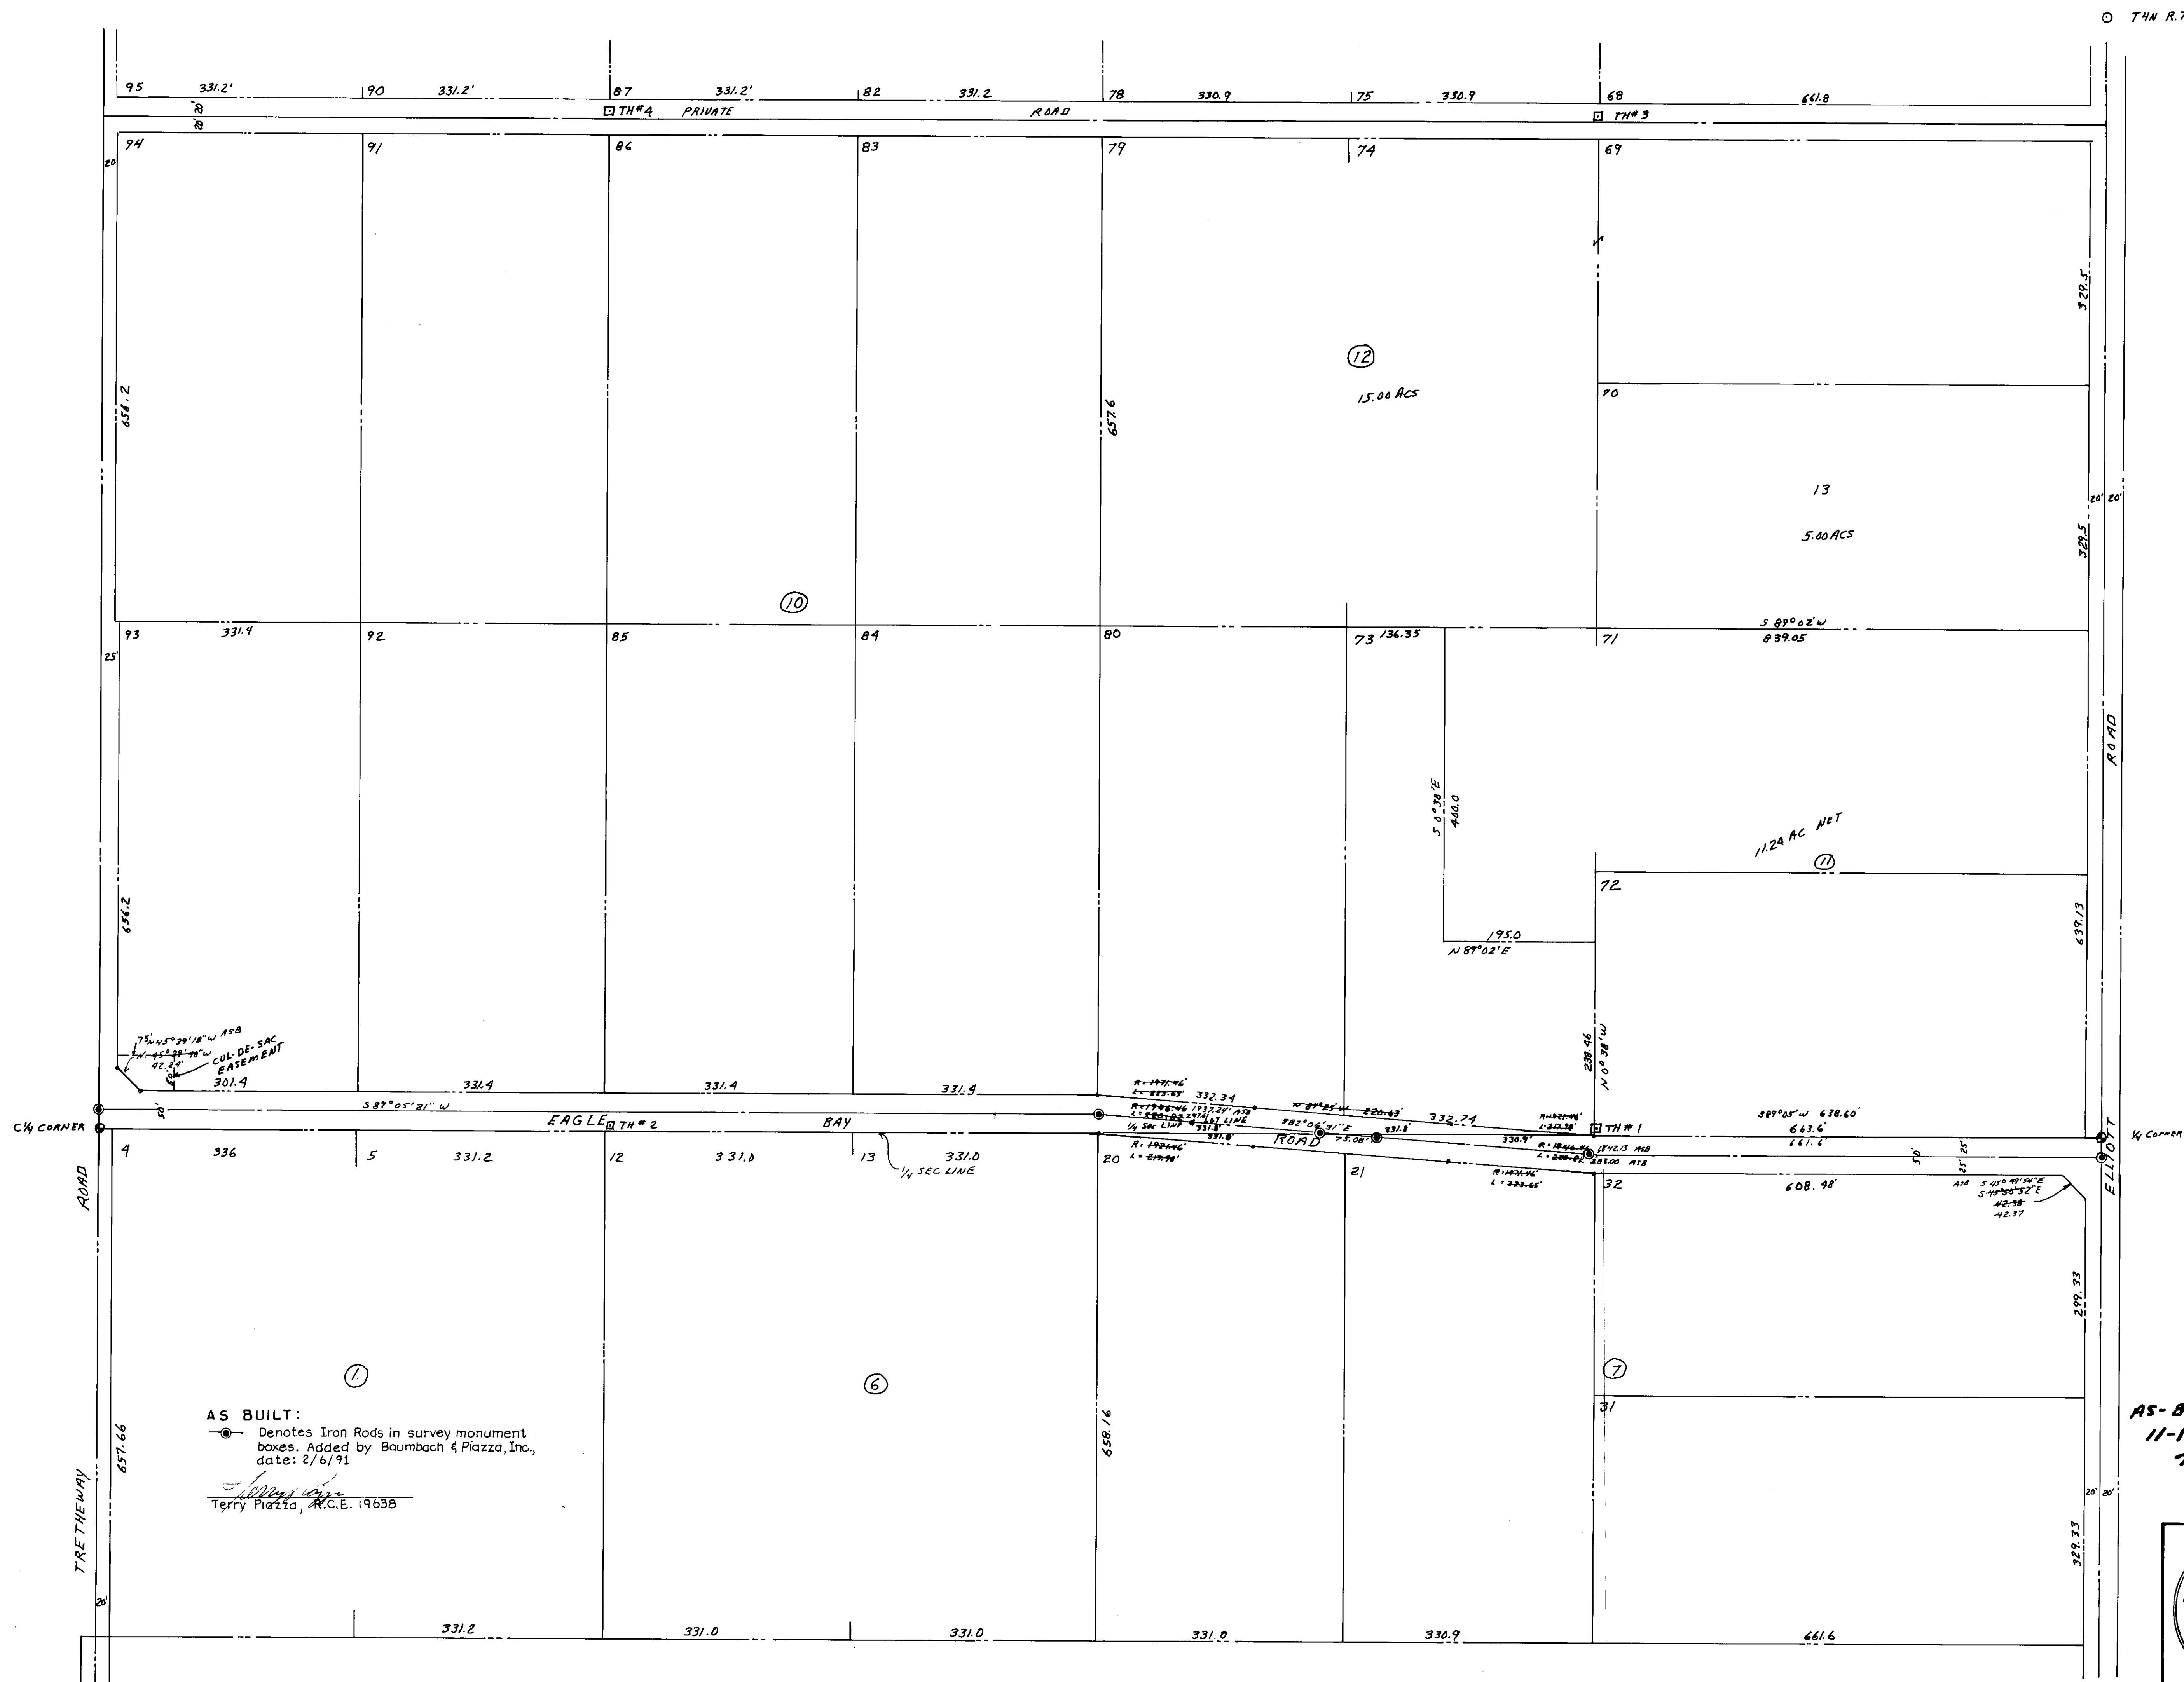

AS-BUILT
11-12-90
WCA

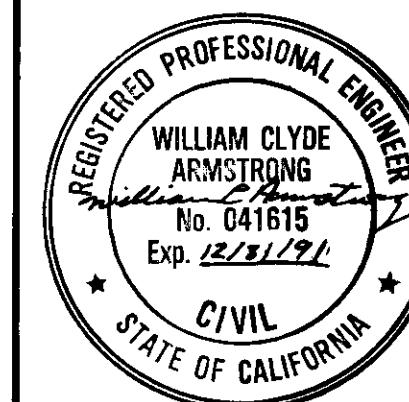

SMALL FARMS IMPROVEMENT

TRACT DIV. "C"
TRACT DIV. "P"
SAN JOAQUIN COUNTY

Date 6/28/77
Scale: 1" = 100'
Drawn: WCA
Job
Sheet 2
of 3 sheets

[illegible]

ARMSTRONG ENGINEERING
3233 LANCE DRIVE
STOCKTON, CA 95205
(209) 465-1526

