




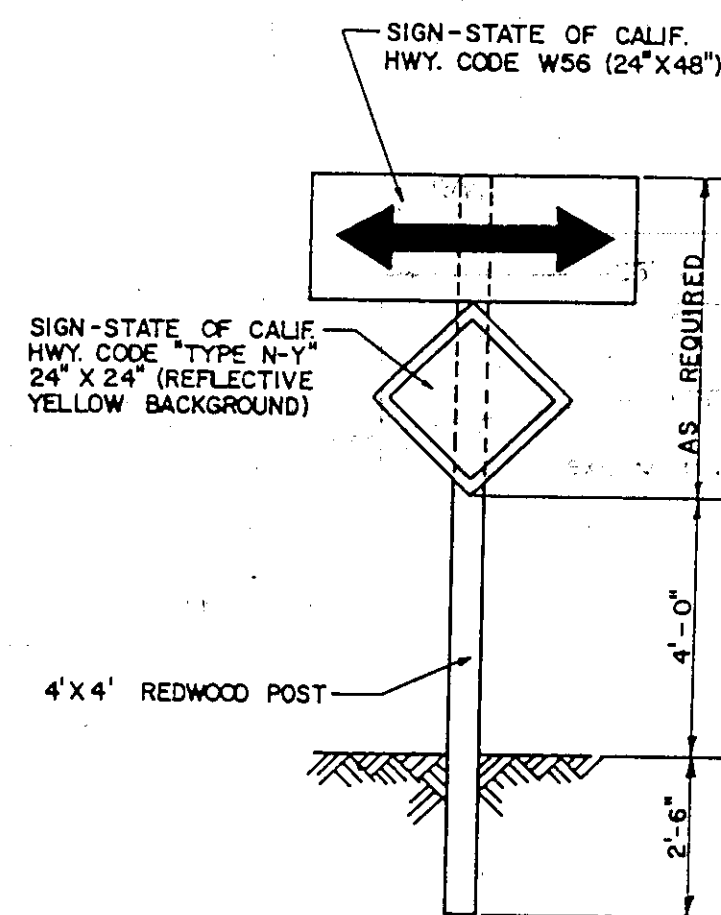


DETAIL B - SIGN
NOT TO SCALE

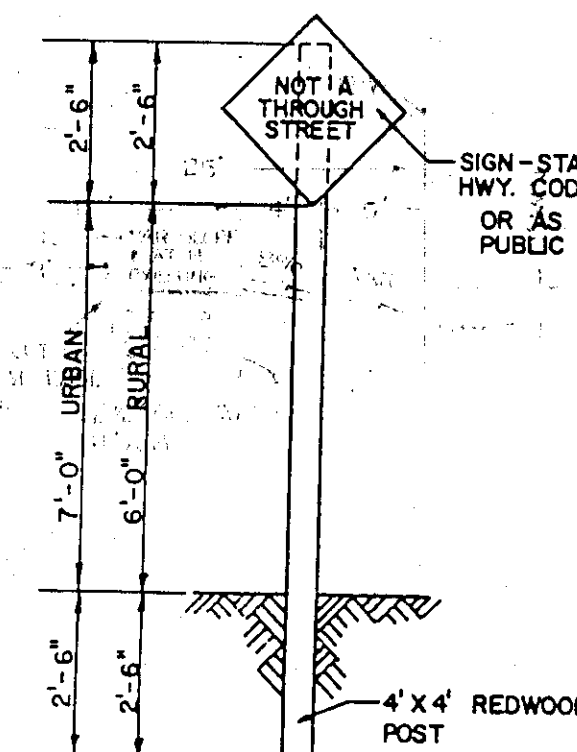


DETAIL C - SIGN
NOT TO SCALE

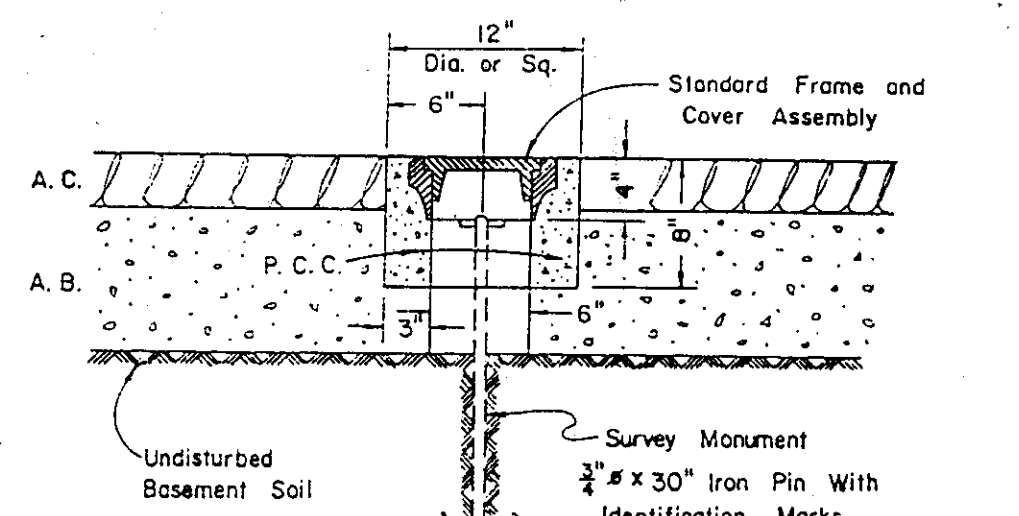


TYPICAL SECTION

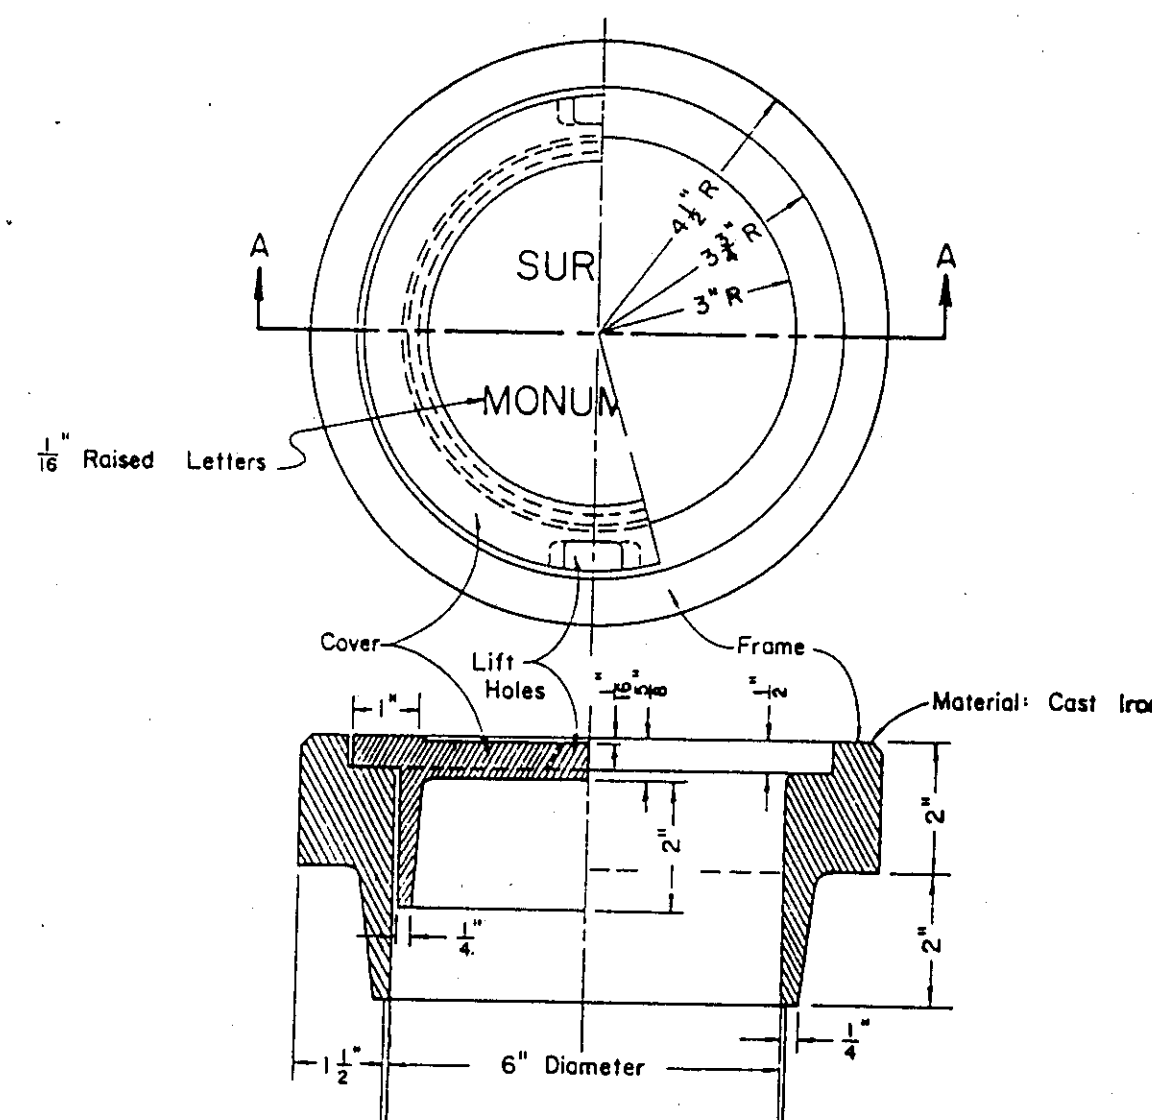

SURVEY MONUMENT
FRAME & COVER ASSEMBLY

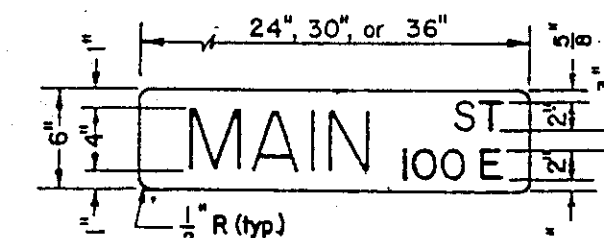


TYPICAL STREET SIGN

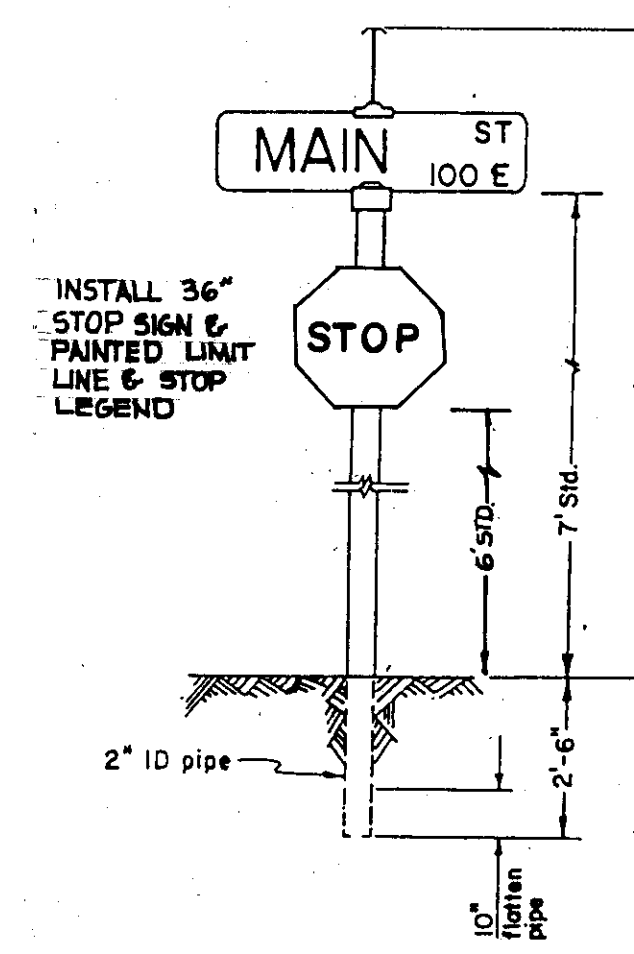


TYPICAL STREET SIGN
INSTALLATION


- NOTES:
1. One street sign is required at each intersection.
 2. Block numbers are to be acquired from the San Joaquin County Department of Planning and Building Inspection.
 3. See improvement plans for location of STOP signs, when required.
 4. The length of the street sign varies due to the length of the street name.

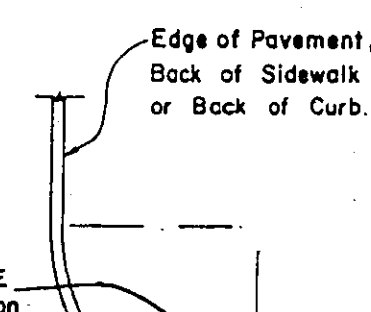

STREET SIGN POST
LOCATION DETAIL
DETAIL A

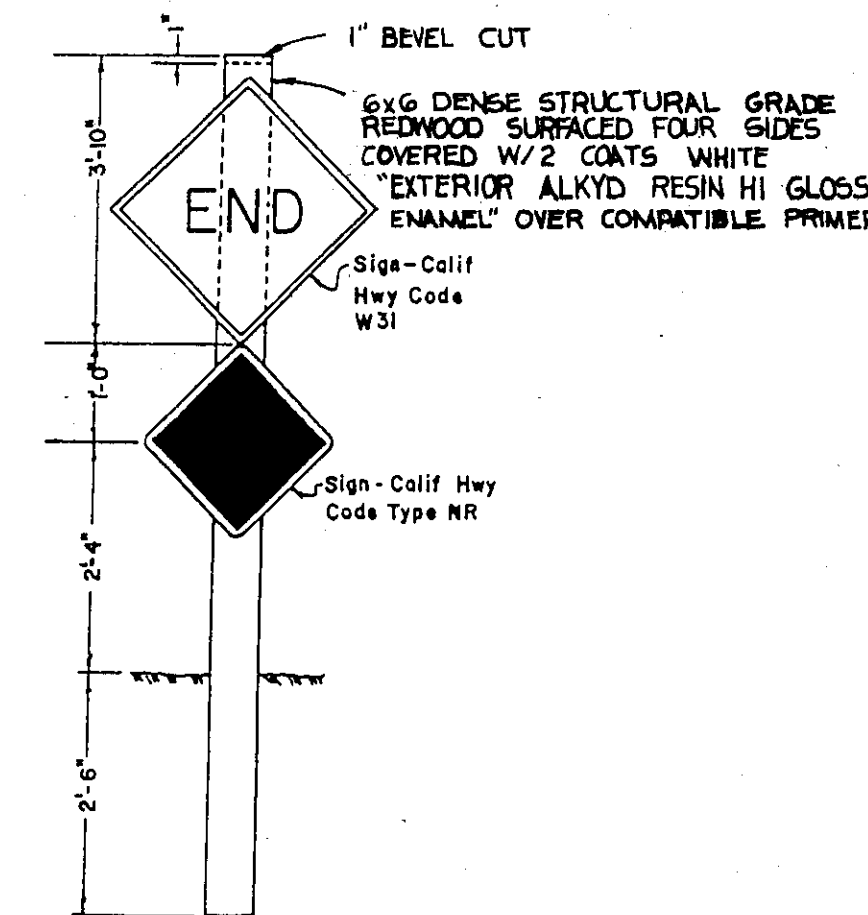


TYPE "B"

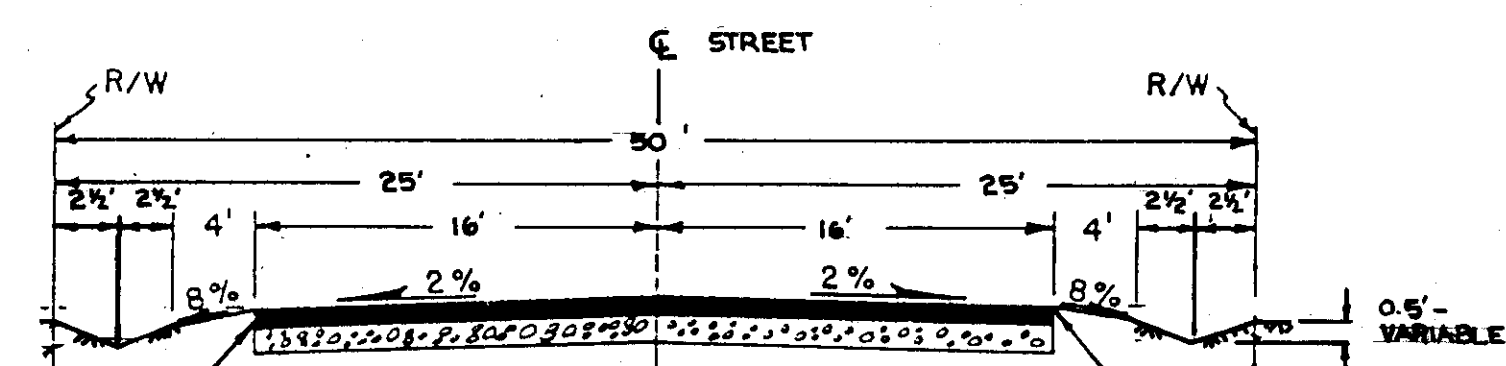


PAMPY COURT
TYPICAL SECTION
N.T.S.

STA. 0+39 TO 2+49

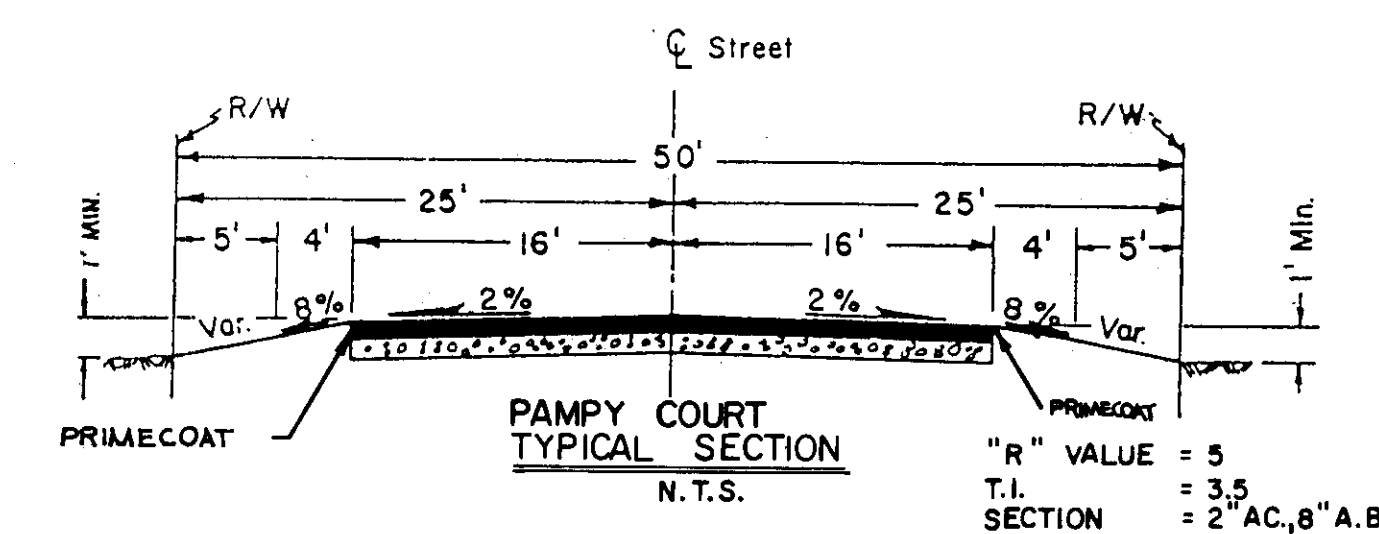


PAMPY COURT
TYPICAL SECTION
N.T.S.

STA. 2+49 TO 5+62.57 END PAVING

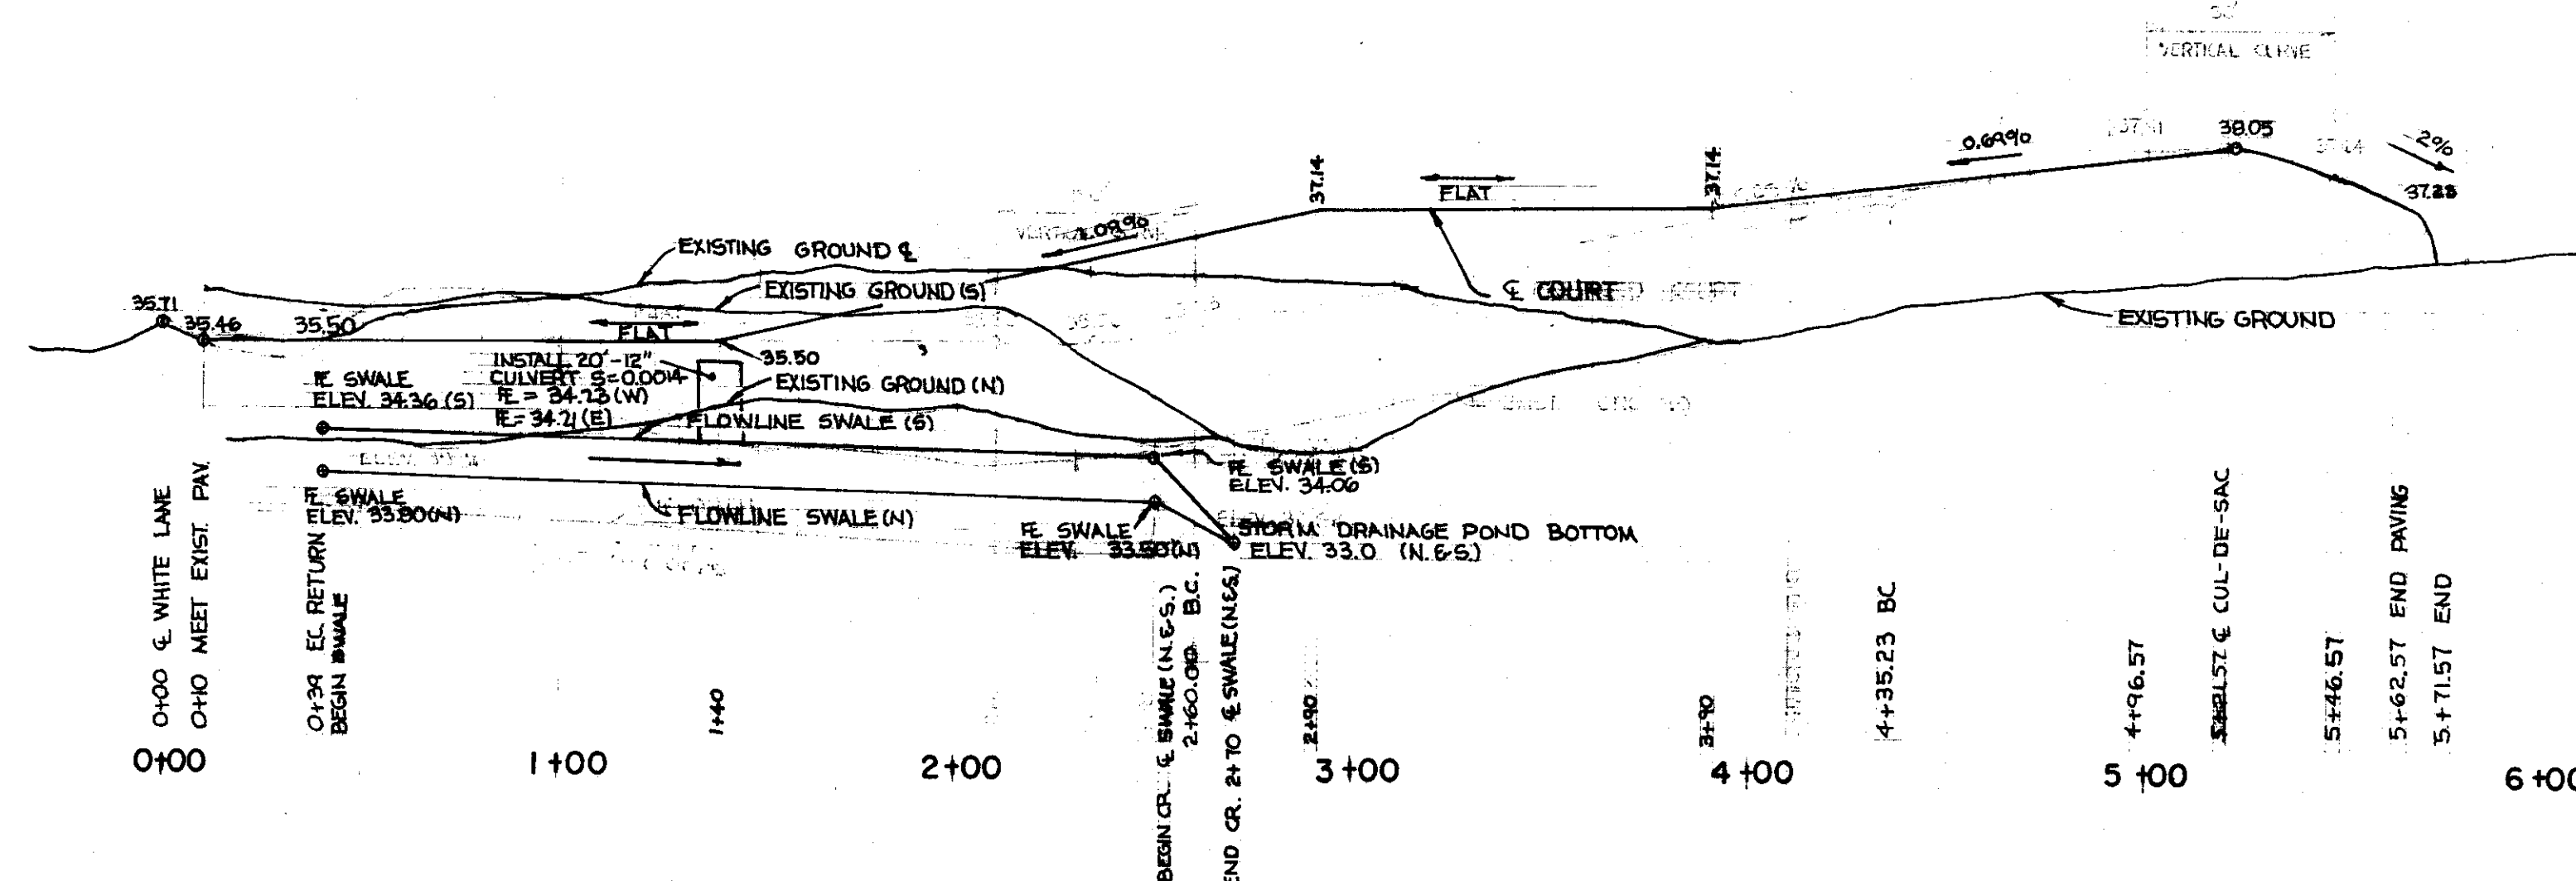

SCALE HORIZ. 1" = 40'
VERT. 1" = 2'

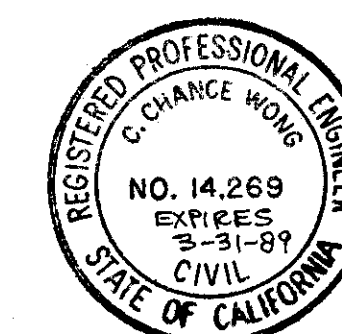

40
39
38
37
36
35
34
33

"AS BUILT"

APPROVED _____ 19 _____

APPROVED _____ 19 _____

REVISIONS

NO. DESCRIPTION DATE BY



WONG ENGINEERS, INC.
PLANNING • ENGINEERING • SURVEYING
STOCKTON, CALIFORNIA



R.C.E. NO. 14269

JOB NO. 2009
DATE DECEMBER 1988
SCALE HORIZ. 1" = 40'
SCALE VERT. 1" = 2'
DRAWN ZW
DESIGN WE
CHECK

PAMPY COURT

PROFILE AND DETAIL

SHEET
2
OF TWO
FILE

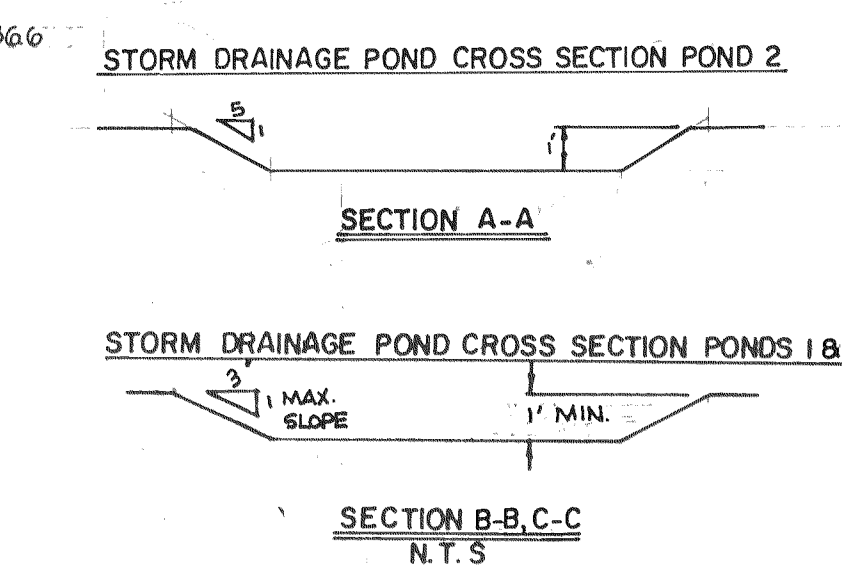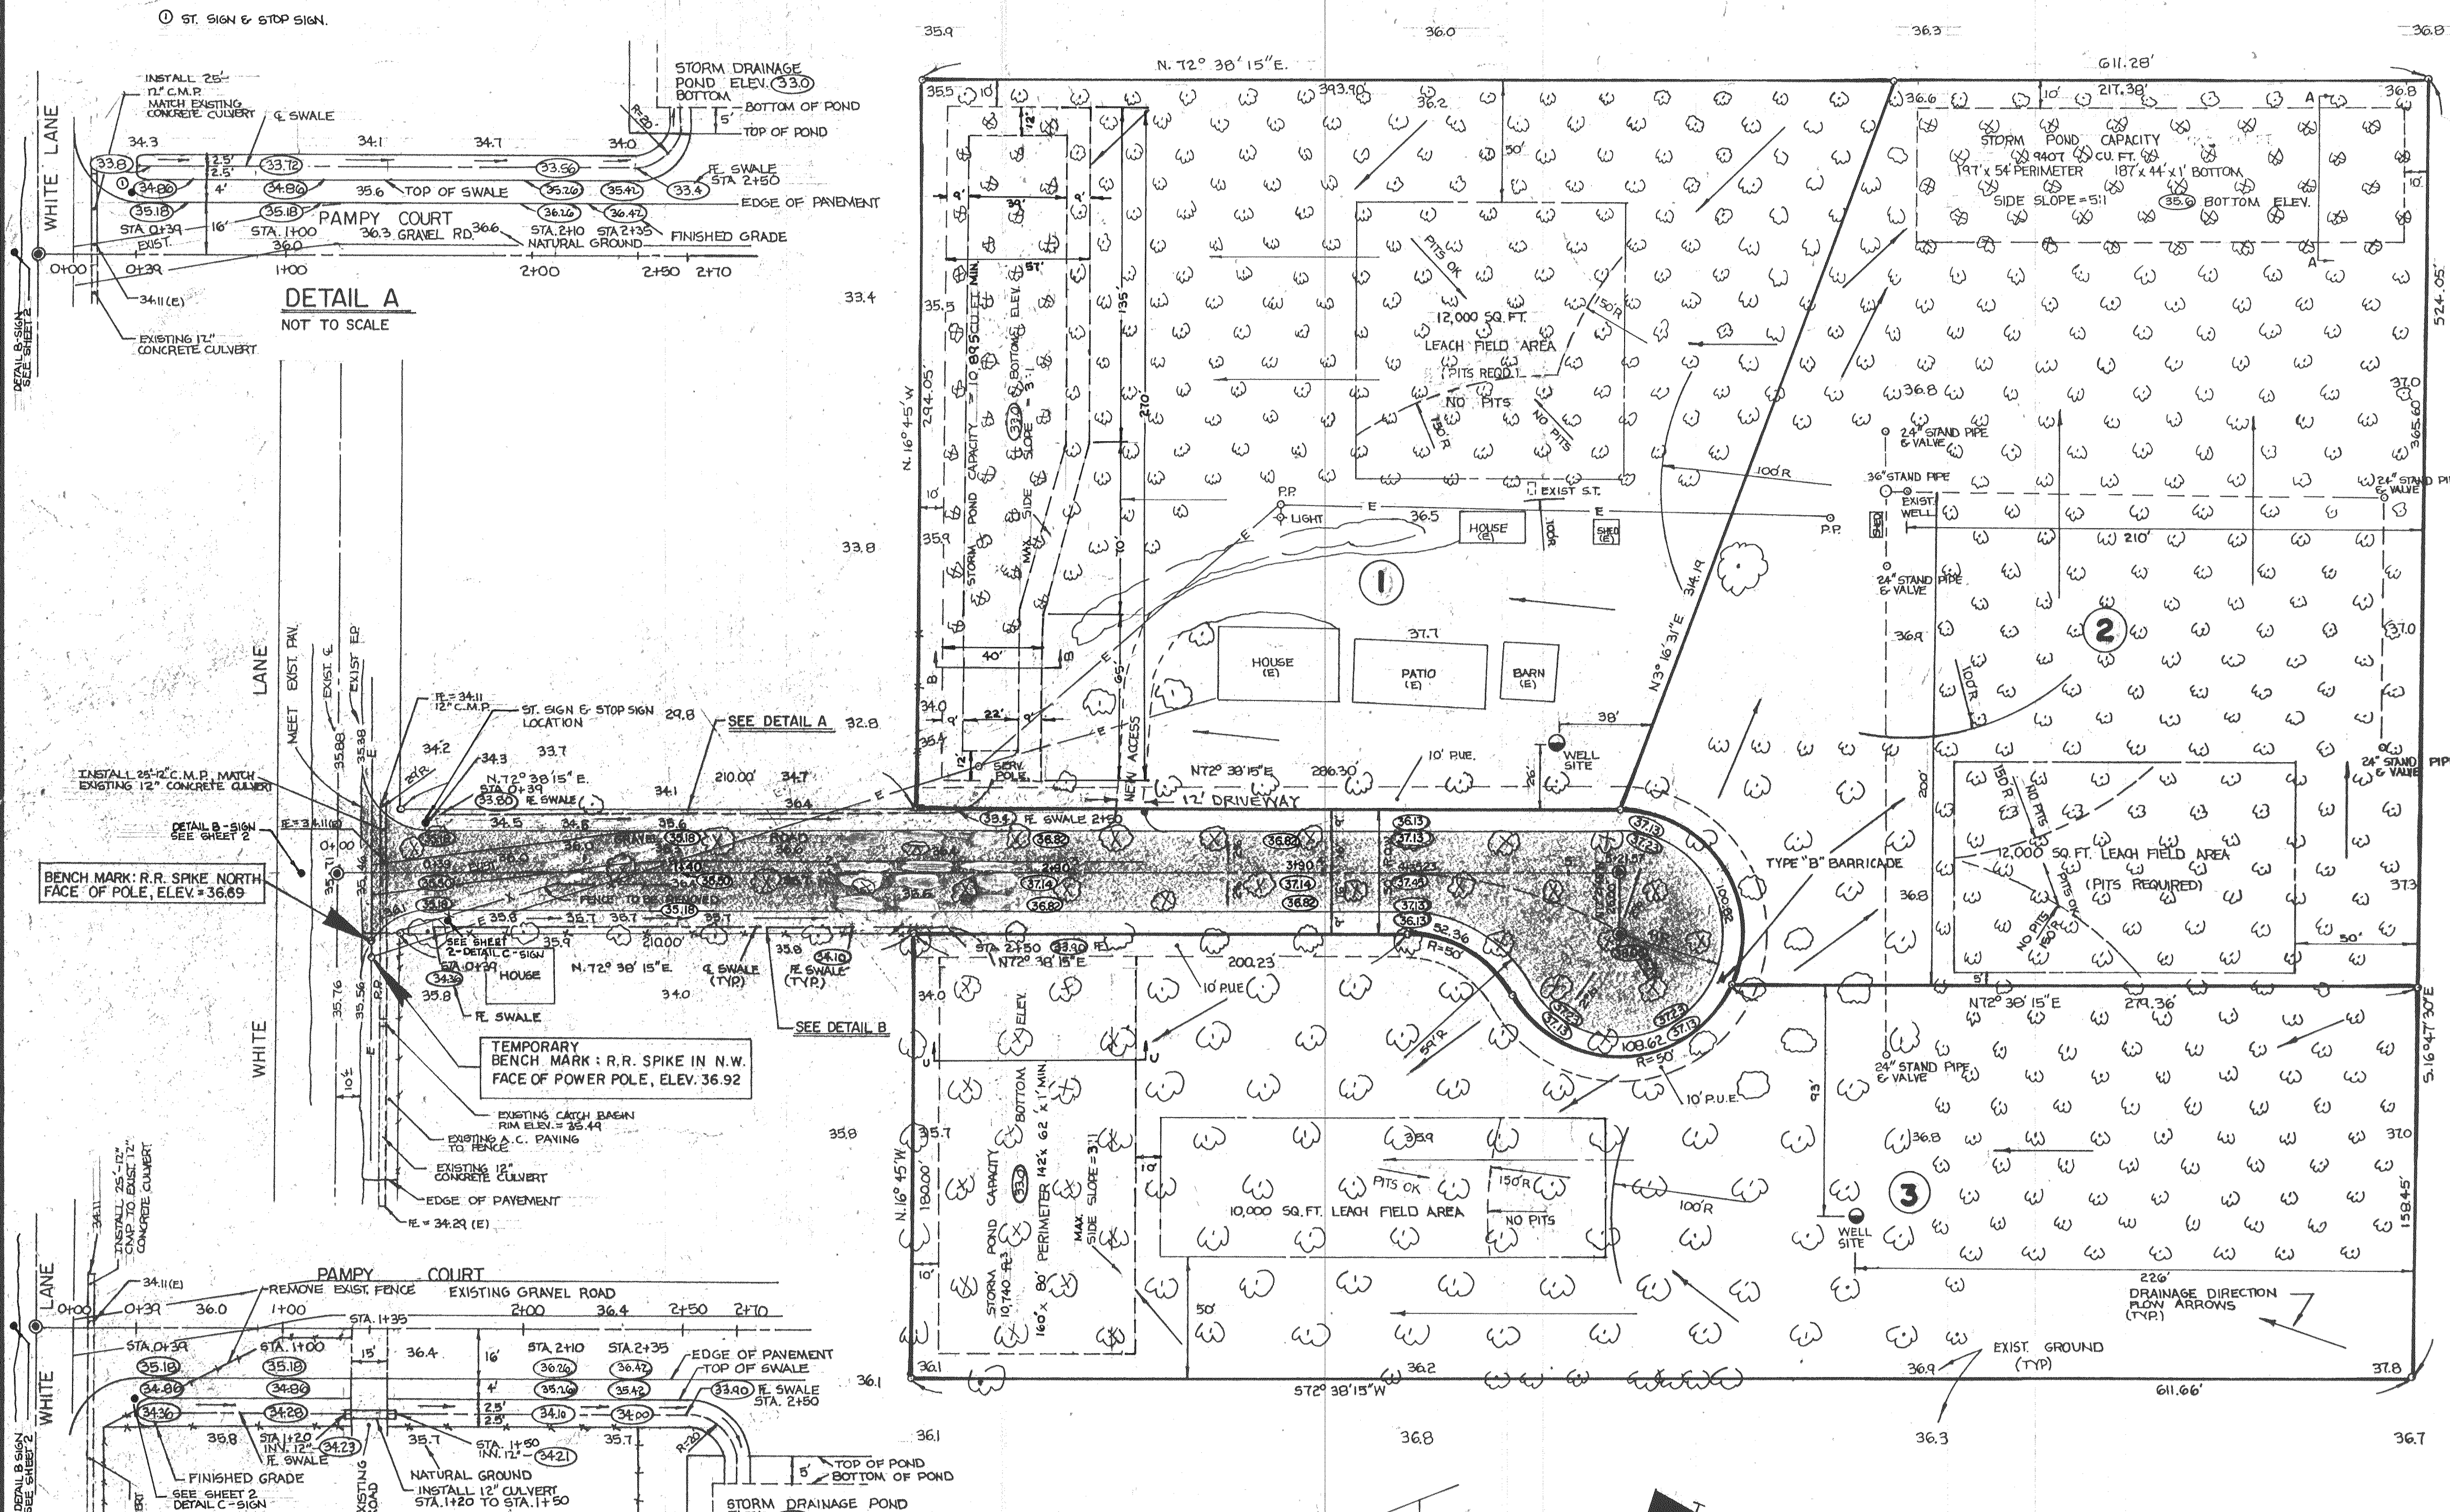


GENERAL NOTES

- CONTRACTOR SHALL ASSUME SOLE AND COMPLETE RESPONSIBILITY FOR JOB SITE CONDITIONS DURING THE COURSE OF CONSTRUCTION OF THIS PROJECT, INCLUDING SAFETY FOR ALL PERSONS AND PROPERTY; THAT THIS REQUIREMENT SHALL APPLY CONTINUOUSLY AND NOT BE LIMITED TO NORMAL WORKING HOURS AND THAT CONTRACTOR SHALL DEFEND, INDEMNIFY, AND HOLD THE OWNER, AND ENGINEER HARMLESS FROM ANY AND ALL LIABILITY, REAL OR ALLEGED, IN CONNECTION WITH THE PERFORMANCE OF WORK ON THIS PROJECT.
- PRIOR TO PERFORMING ANY WORK WITHIN THE ROAD RIGHT-OF-WAY, THE CONTRACTOR SHALL OBTAIN AN ENCROACHMENT PERMIT FROM THE SAN JOAQUIN COUNTY DEPARTMENT OF PUBLIC WORKS.
- CONTRACTOR SHALL OBTAIN A GRADING PERMIT FROM THE SAN JOAQUIN COUNTY BUILDING DIVISION.
- ALL TRAFFIC SIGNS AND MARKINGS SHALL CONFORM TO SAN JOAQUIN COUNTY STANDARDS AND TO THE "MANUAL OF UNIFORM TRAFFIC CONTROL DEVICES."
- ALL COMPACTION TESTS, AND MATERIAL SAMPLING AND TESTING SHALL BE THE RESPONSIBILITY OF THE DEVELOPER.
- ANY CHANGES ON THE APPROVED IMPROVEMENT PLANS AND SPECIFICATIONS MUST BE PREPARED AND CERTIFIED BY THE "CIVIL ENGINEER", AND SHALL BE SUBMITTED TO THE DIRECTOR OF PUBLIC WORKS FOR APPROVAL PRIOR TO IMPLEMENTATION.
- CONTRACTOR AGREES THAT HE SHALL ASSUME SOLE AND COMPLETE RESPONSIBILITY FOR JOB SITE CONDITIONS DURING THE COURSE OF CONSTRUCTION OF THIS PROJECT, INCLUDING SAFETY OF ALL PERSONS AND PROPERTY; THAT THIS REQUIREMENT SHALL APPLY CONTINUOUSLY AND NOT BE LIMITED TO NORMAL WORKING HOURS; AND THAT THE CONTRACTOR SHALL DEFEND, INDEMNIFY AND HOLD HARMLESS, THE COUNTY OF SAN JOAQUIN, ITS ELECTED OFFICIALS, OFFICERS, EMPLOYEES, AND AGENTS FROM ANY AND ALL CLAIMS, COSTS OF LITIGATION, DAMAGES, AND ATTORNEY'S FEES, WHICH ARE CLAIMED TO HAVE OCCURRED DURING THE TERM OF THIS PROJECT.
- ENCROACHMENT PERMIT SHALL BE OBTAINED FROM THE COUNTY OF SAN JOAQUIN, PUBLIC WORKS DEPARTMENT BEFORE BEGINNING OF WORK.

DETAIL B

NOT TO SCALE

SERVICES	
WATER	PRIVATE WELL
SANITARY	SEPTIC TANK
STORM	STORM POND

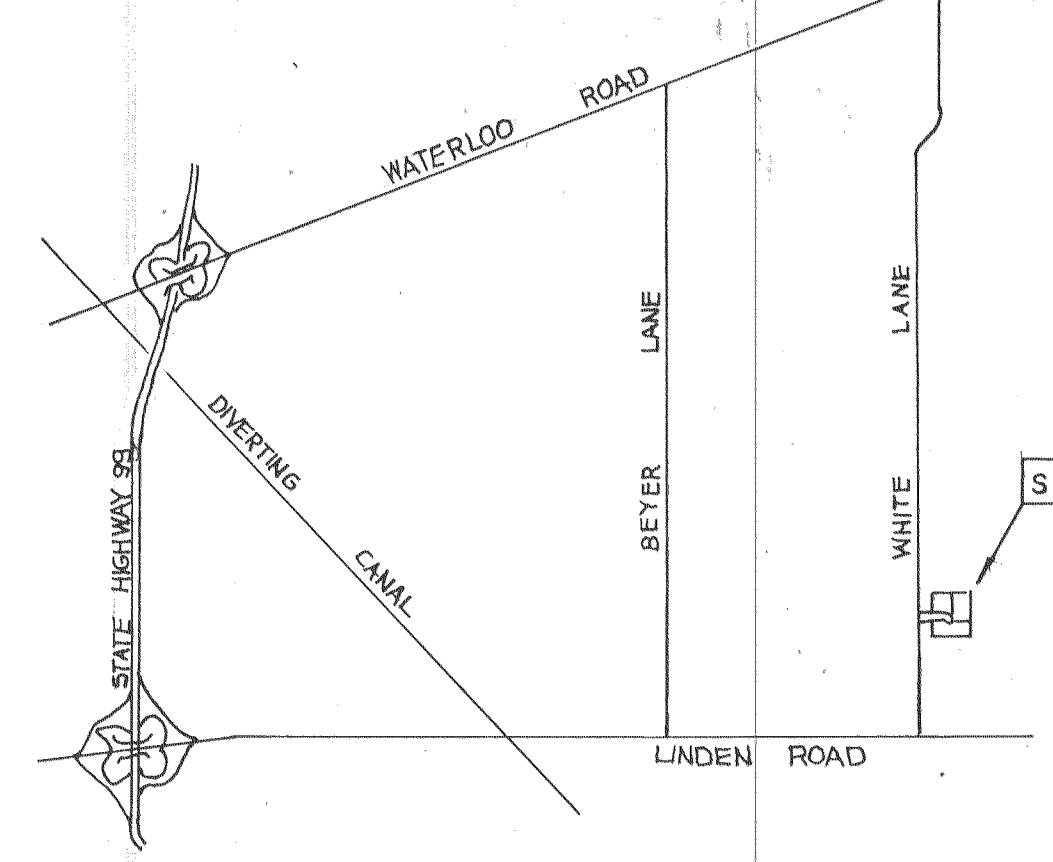

LEGEND

⊗	DENOTES WELL SITE
⊗	DENOTES TREE TO BE REMOVED
⊗	DENOTES LEACH FIELD AREA, SIZE REQ'D SHOWN, WITH PITS REQUIRED
⊗	DENOTES STORM POND AREA, EACH POND TO RETAIN DRAINAGE FROM INDIVIDUAL LOT AND ADJACENT ROAD, SIDE SLOPES INTO POND SHALL BE 5:1.
⊗	DENOTES CENTERLINE MONUMENT
⊗	SEE DETAIL SHEET 2
⊗	DENOTES TYPE "B" BARRICADE
⊗	SEE DETAIL SHEET 2
⊗	DENOTES STREET SIGN
⊗	SEE DETAIL SHEET 2
⊗	FINISHED GRADE
⊗	EXISTING



"AS BUILT"

APPROVED <u>Feb 3</u> 19 <u>89</u>	APPROVED <u>April 11</u> 19 <u>90</u>	REVISIONS		JOB NO. 2009		PAMPY COURT		SHEET 1 OF TWO FILE
James R. Miller, R.S. SAN JOAQUIN LOCAL HEALTH DISTRICT		Henry M. Hirata HENRY M. HIRATA, DIRECTOR OF PUBLIC WORKS SAN JOAQUIN COUNTY R.C.E. 21,258		DATE		DATE DECEMBER 1988		
				BY		SCALE HORIZ 1"=40'		
						SCALE VERT		
						DRAWN ZCW		IMPROVEMENT PLANS
						DESIGN WE		
						CHECK		

WONG ENGINEERS, INC.
PLANNING • ENGINEERING • SURVEYING
STOCKTON, CALIFORNIA
R.C.E. NO. 14269

SL 2323