

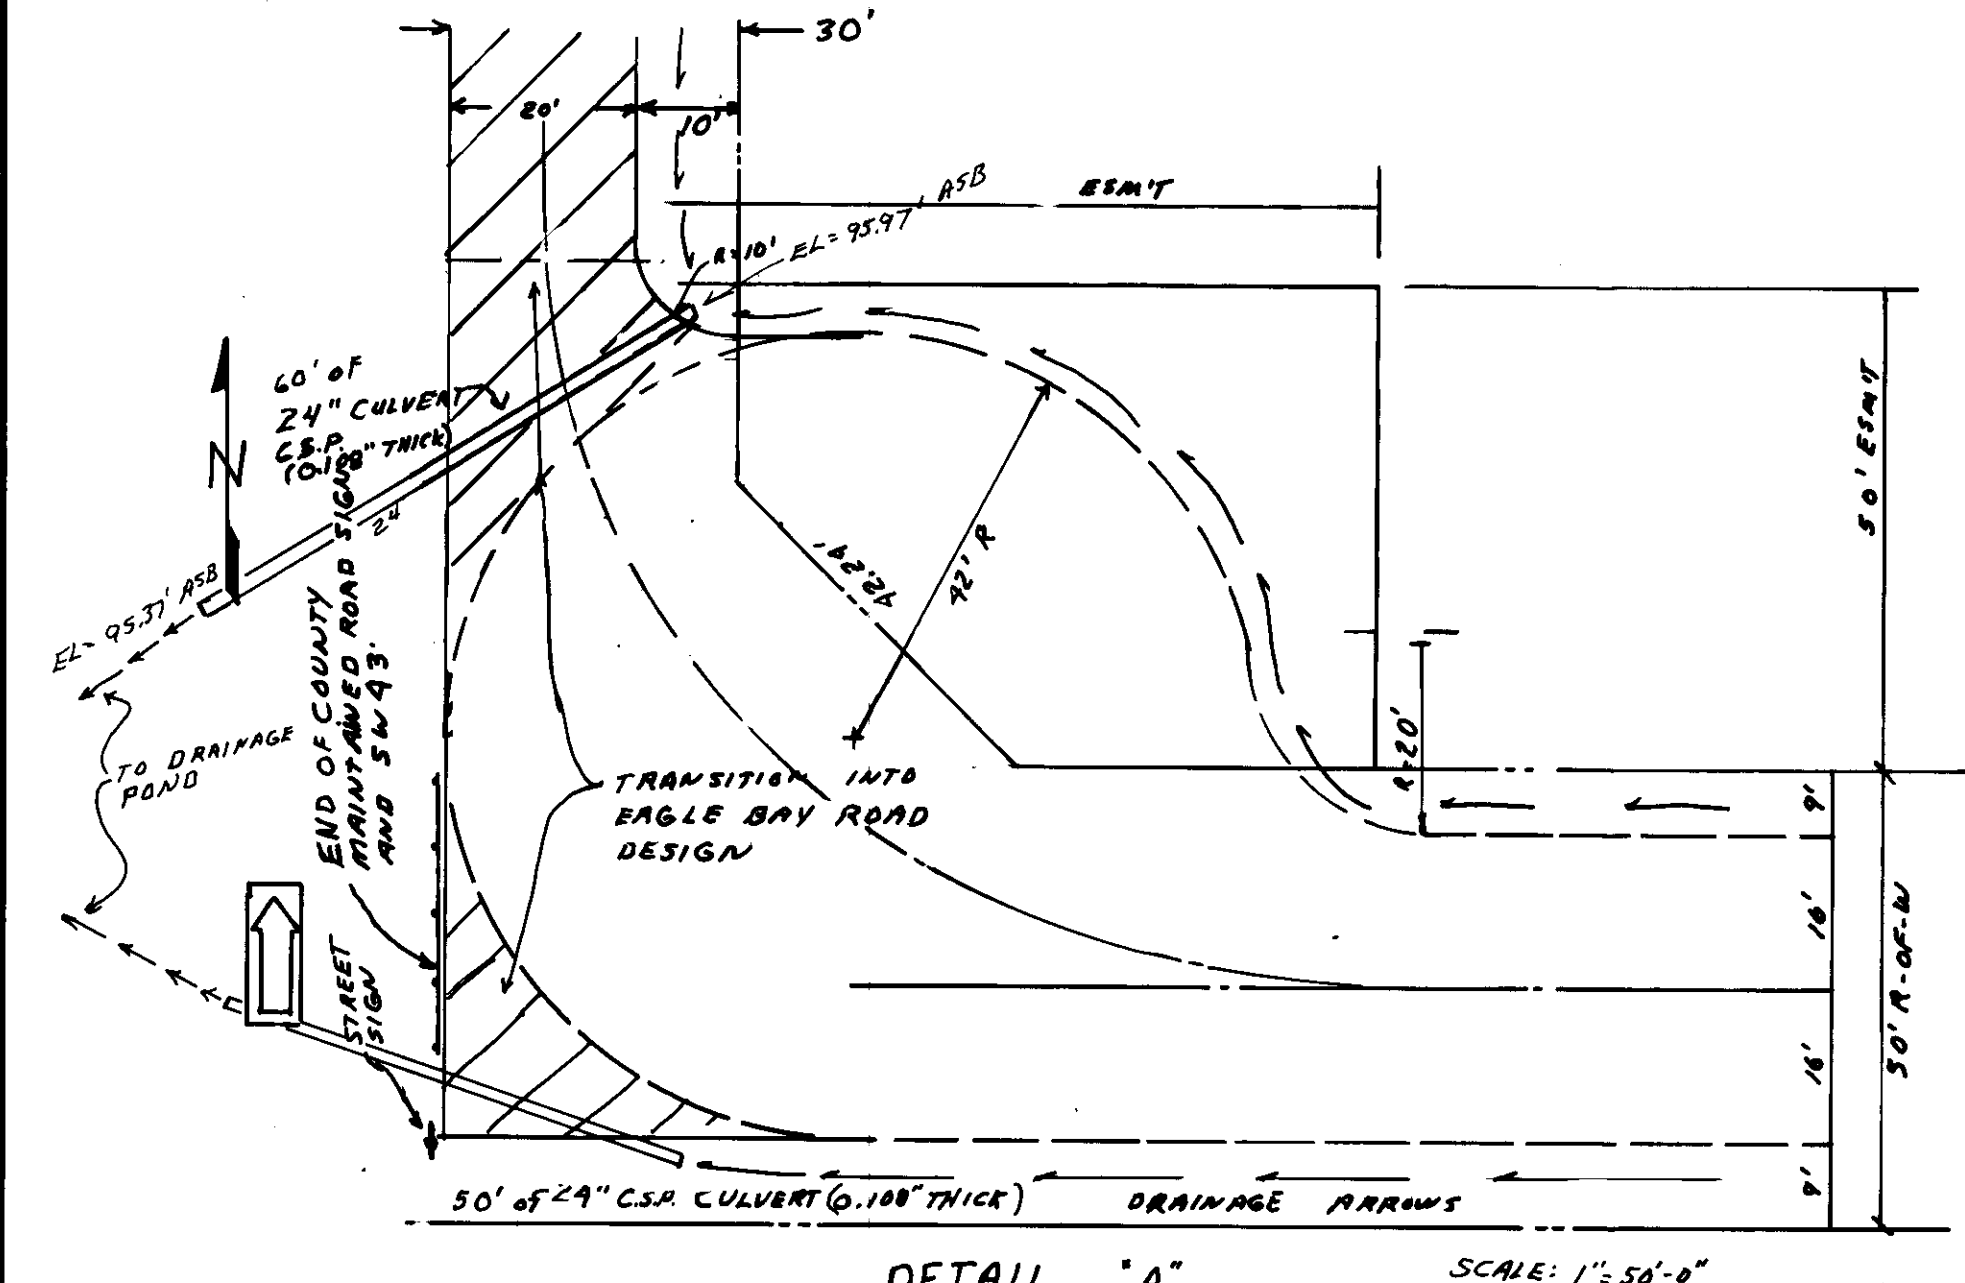
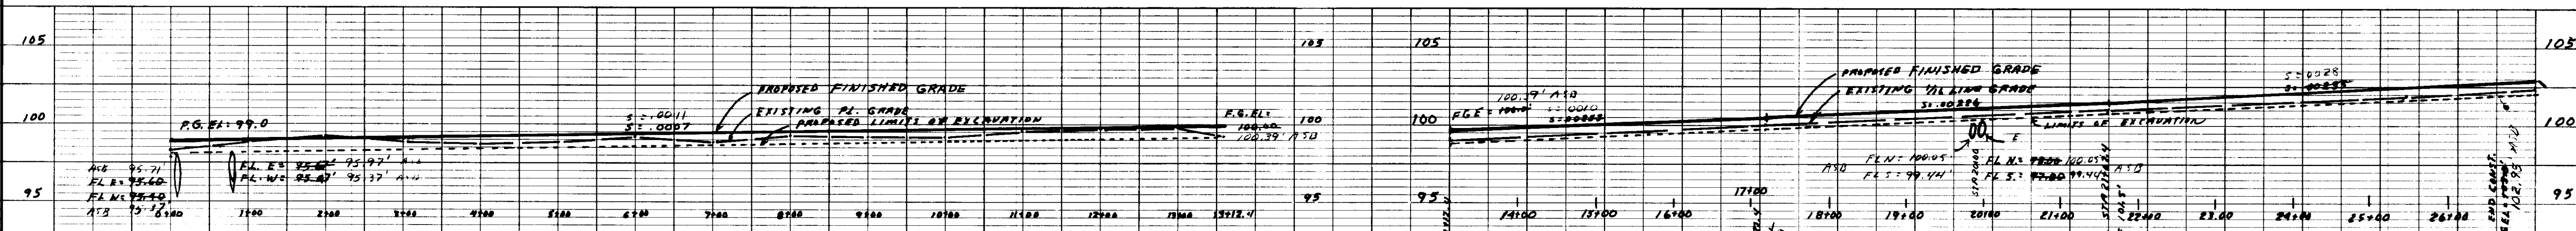
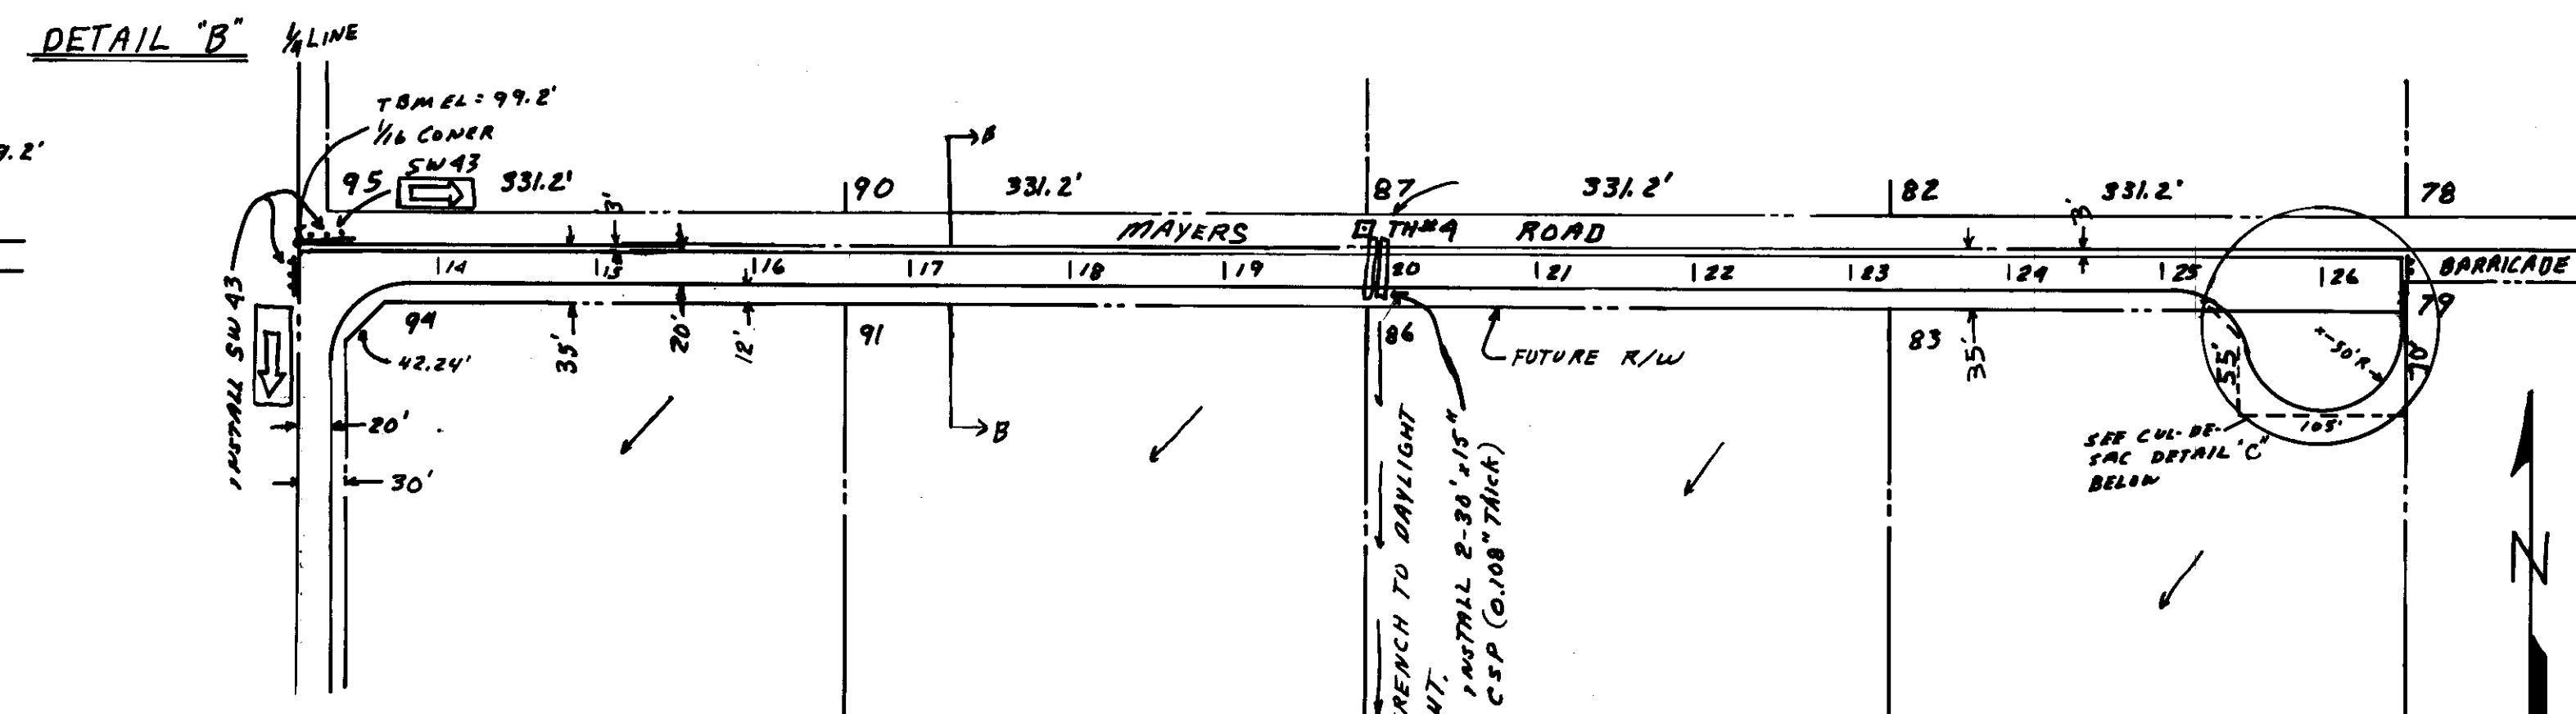
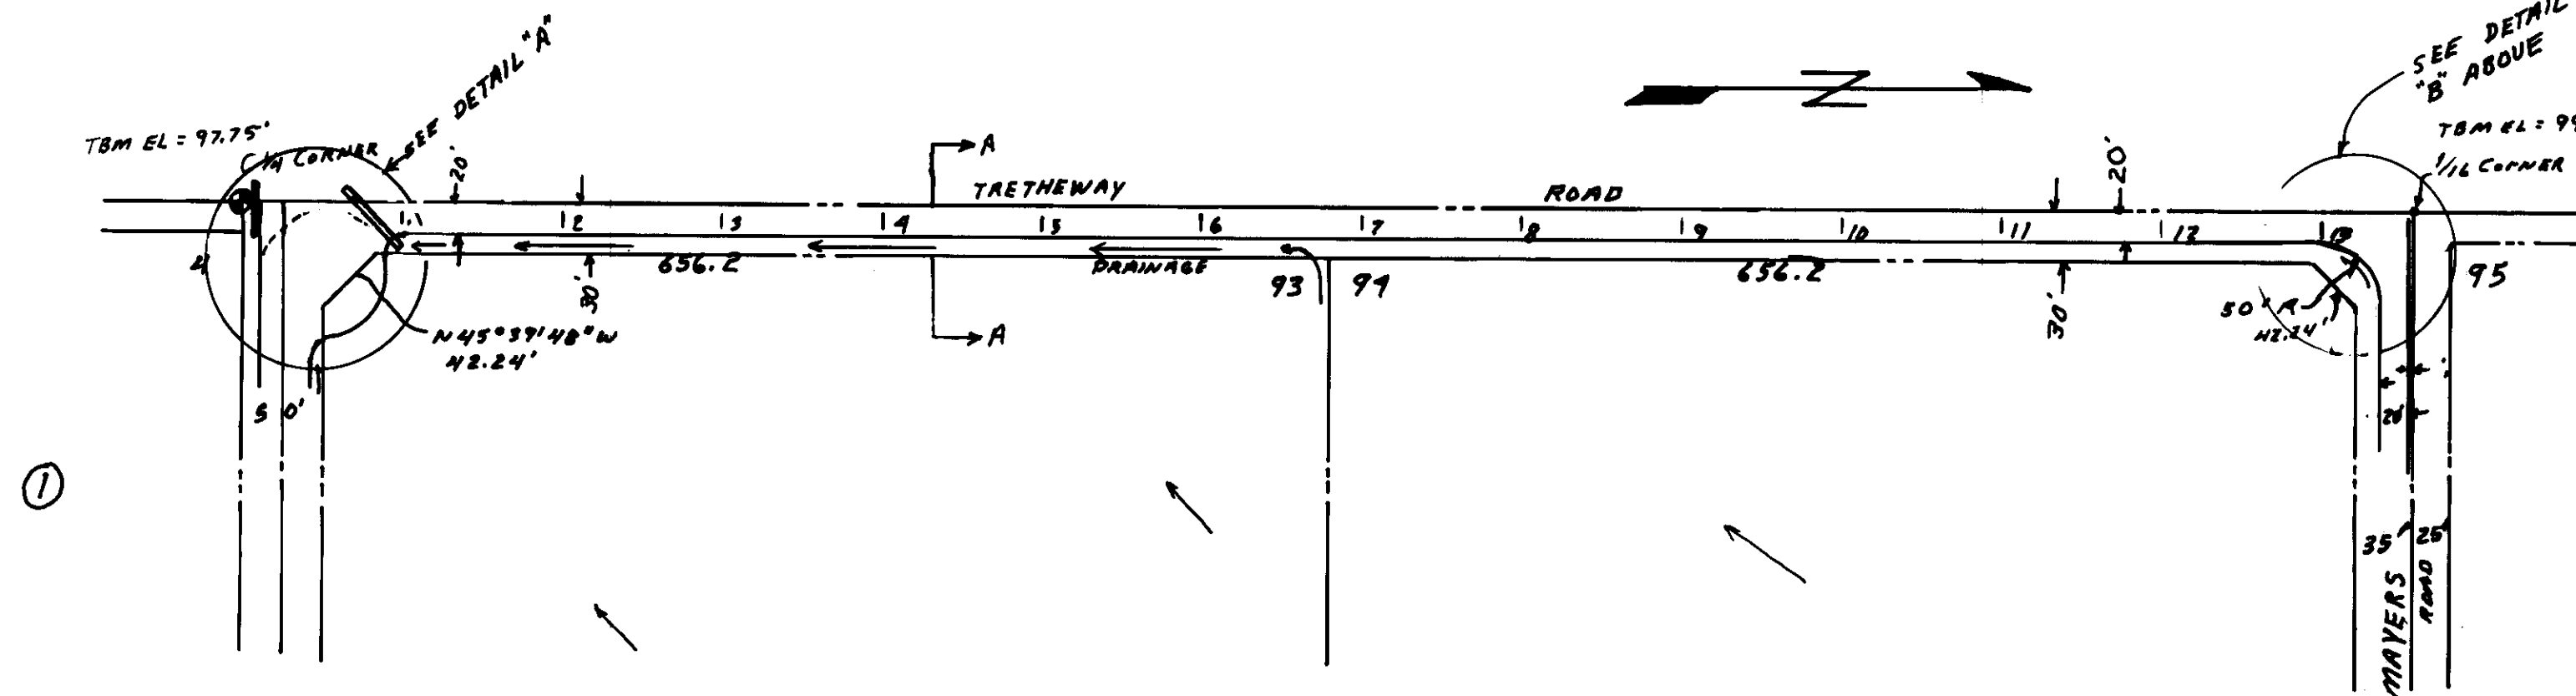
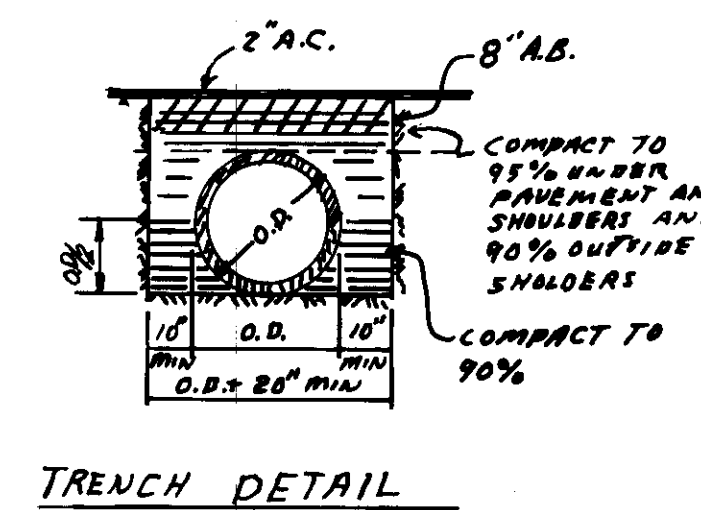
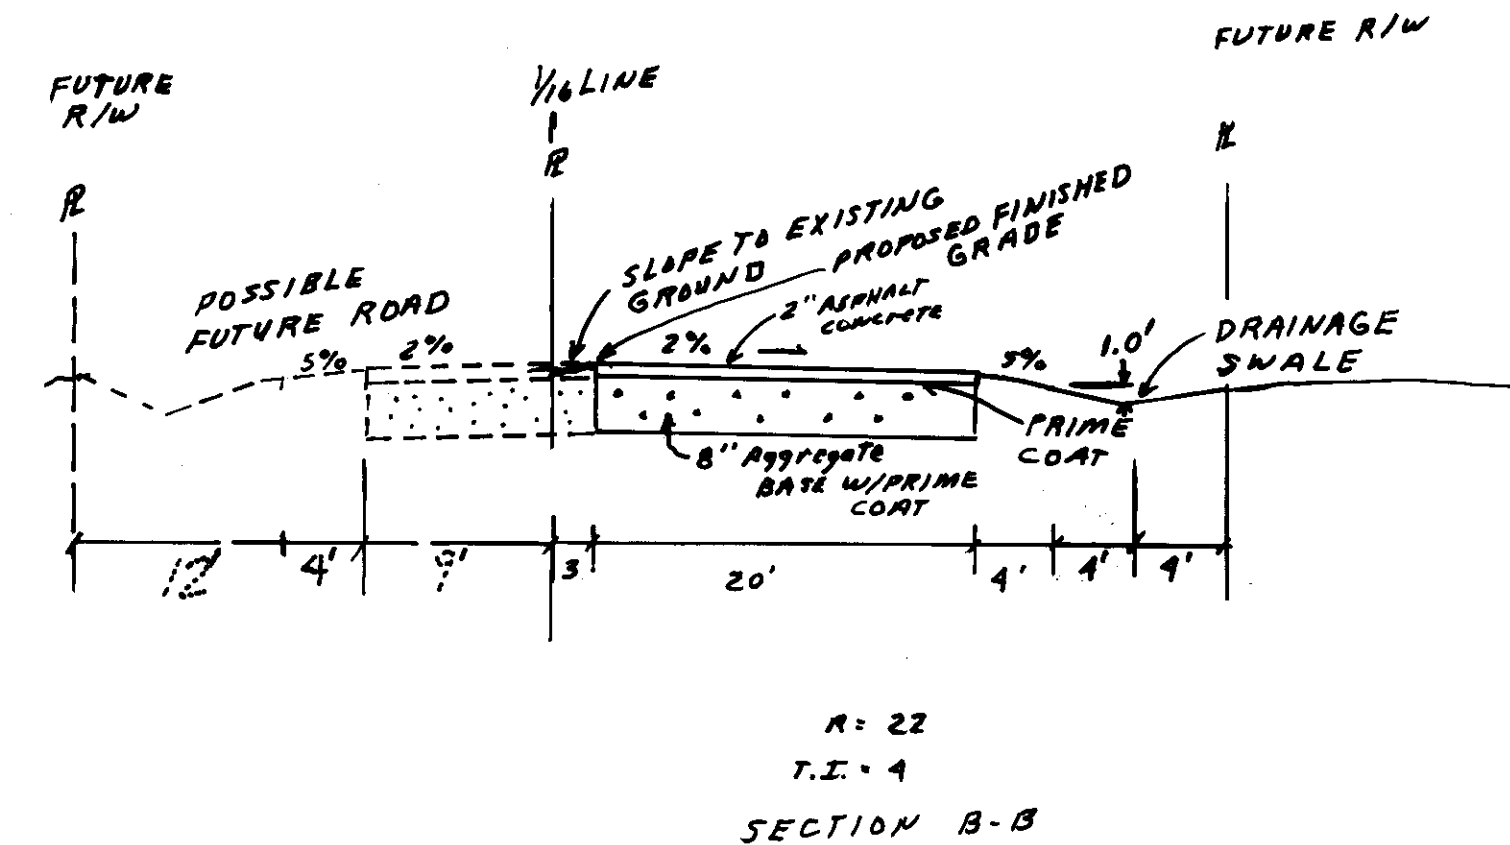
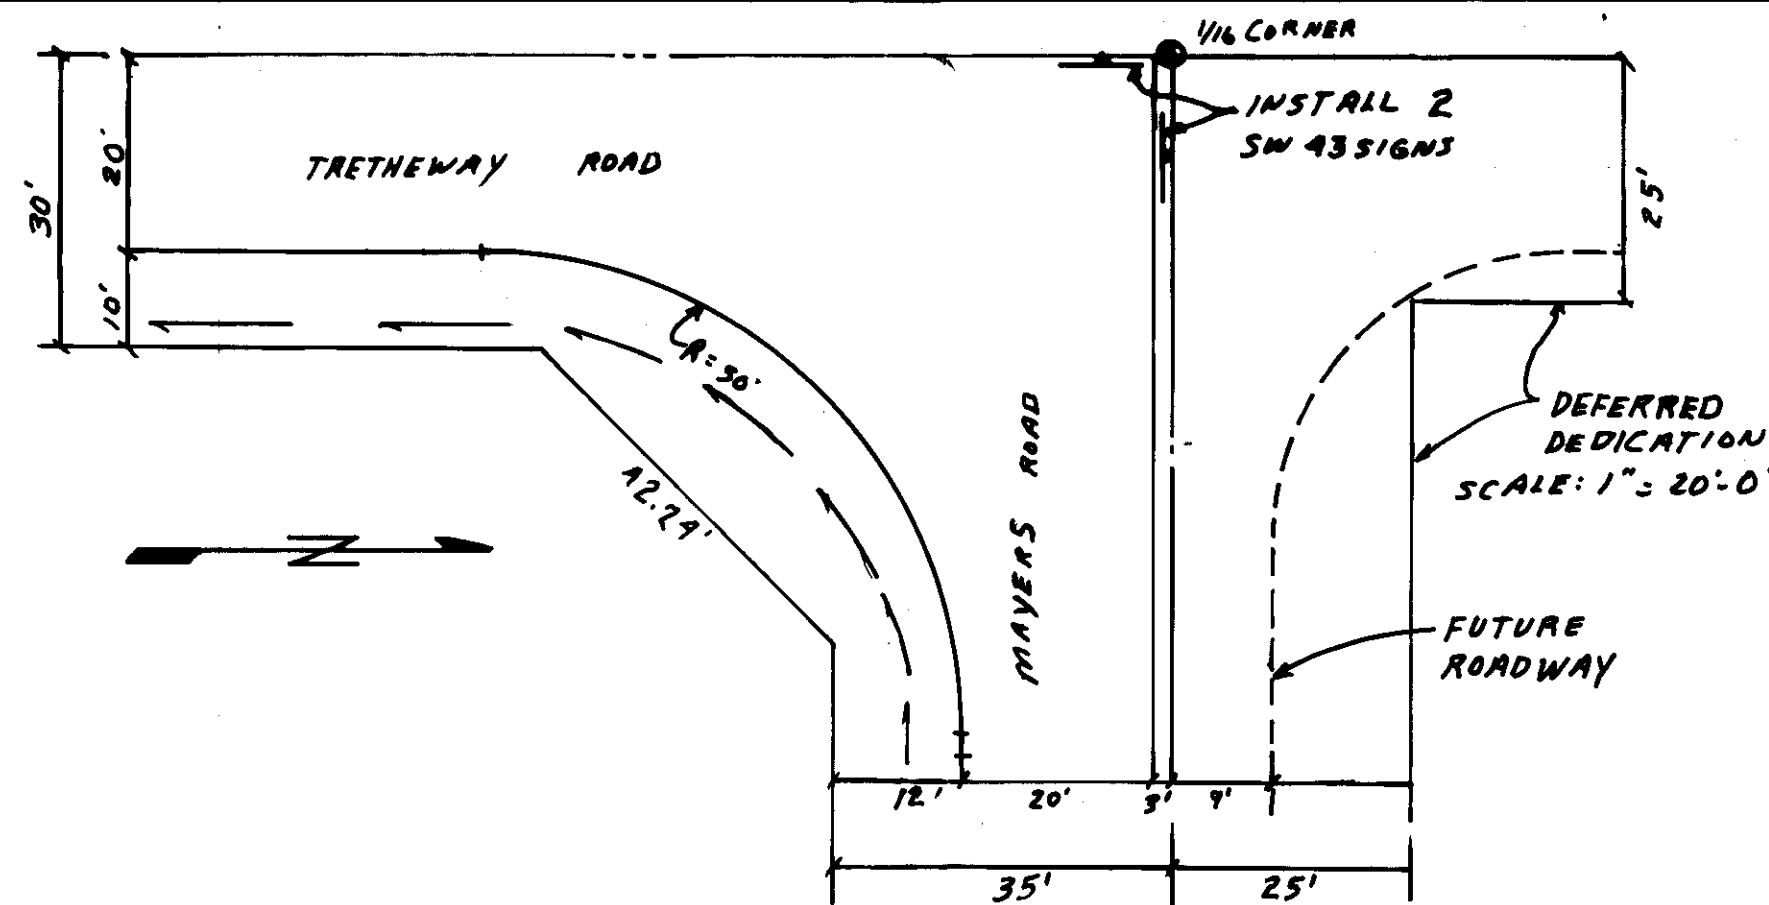


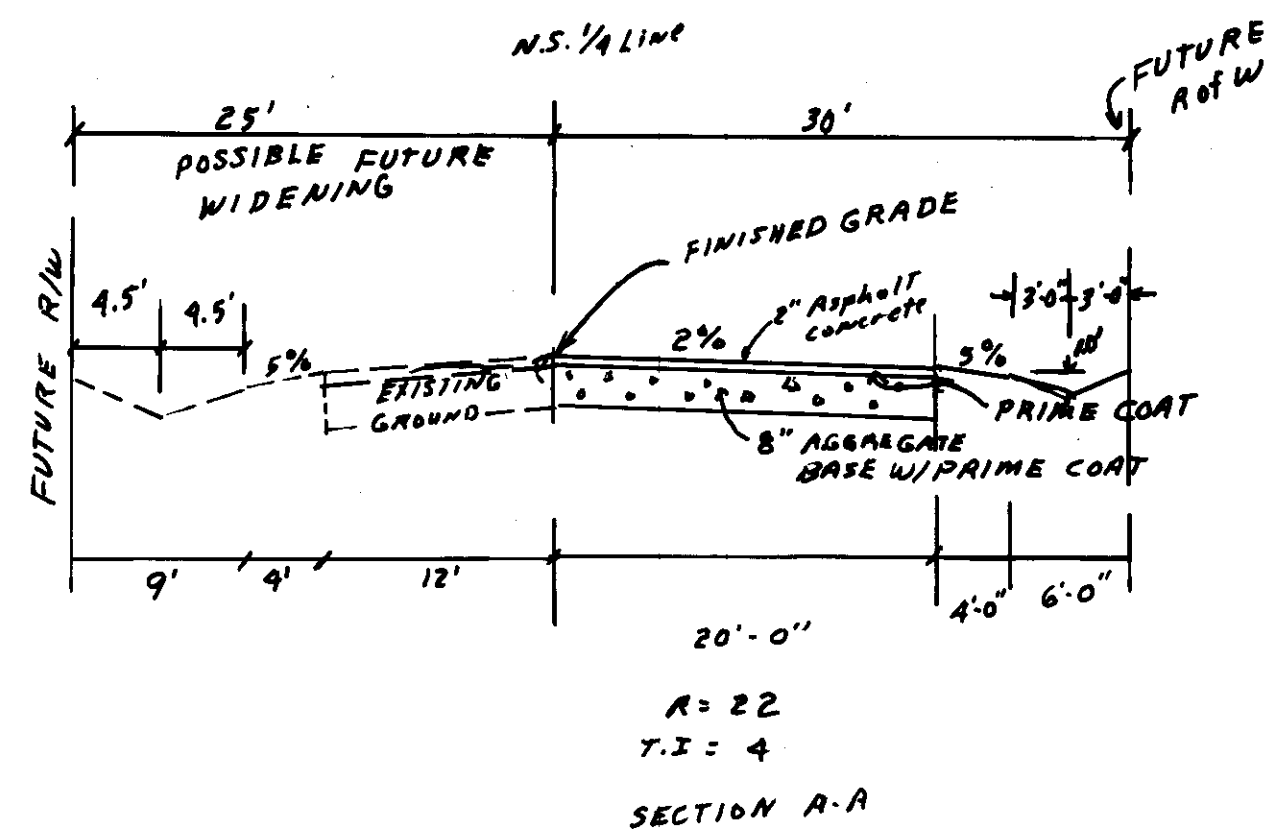

- NOTES:
1. FENCE AND GATES WITHIN LOT 83, 86, 91, 93, 94 THAT ARE IN THE WAY ARE TO BE MOVED PRIOR TO ROAD WORK COMMENCING.
 2. OWNER TO MAINTAIN STATION 102+00 TO BE NEARBY PRIOR TO CONSTRUCTION BEGINNING.
 3. SLOPE ACROSS THE CUL-DE-SAC TO BE 3% TO THE WEST.
 4. TRETHEWAY ROAD EXTENDED TO BE A 20' ROADWAY (PRIVATE DRIVE).
 5. WHEN TRETHEWAY ROAD IS EXTENDED TO JAHANT OR NORTH OF LOT 93 THEN THE CUL-DE-SAC OUTSIDE OF THE DEDICATED R.O.W. COVERED BY THE EASEMENT WILL BE VACATED AND GIVEN BACK TO THE PROPERTY OWNER OF LOT 93.
 6. ALL CONSTRUCTION TO MEET LATEST SAN JOAQUIN COUNTY STANDARDS.
 7. WHEN MAYERS ROAD IS EXTENDED TO THE EAST AND CONNECTS TO JAHANT ROAD THE CUL-DE-SAC INSIDE OF THE R.O.W. FOR LOT 83 WILL BE RETURNED TO THE OWNER TO PROVIDE CONSTRUCTION STAGING AND HAVE AS BUILT PREPARED AND SUBMITTED TO THE COUNTY FOR COMPLETION OF THE IMPROVEMENTS.
 8. CONSTRUCTION TESTS SHALL BE THE RESPONSIBILITY OF THE DEVELOPER.
 9. STREET SIGNS AND MARKINGS TO MEET THE MANUAL OF UNIFORM TRAFFIC CONTROL DEVICES AND SAN JOAQUIN COUNTY STANDARDS.

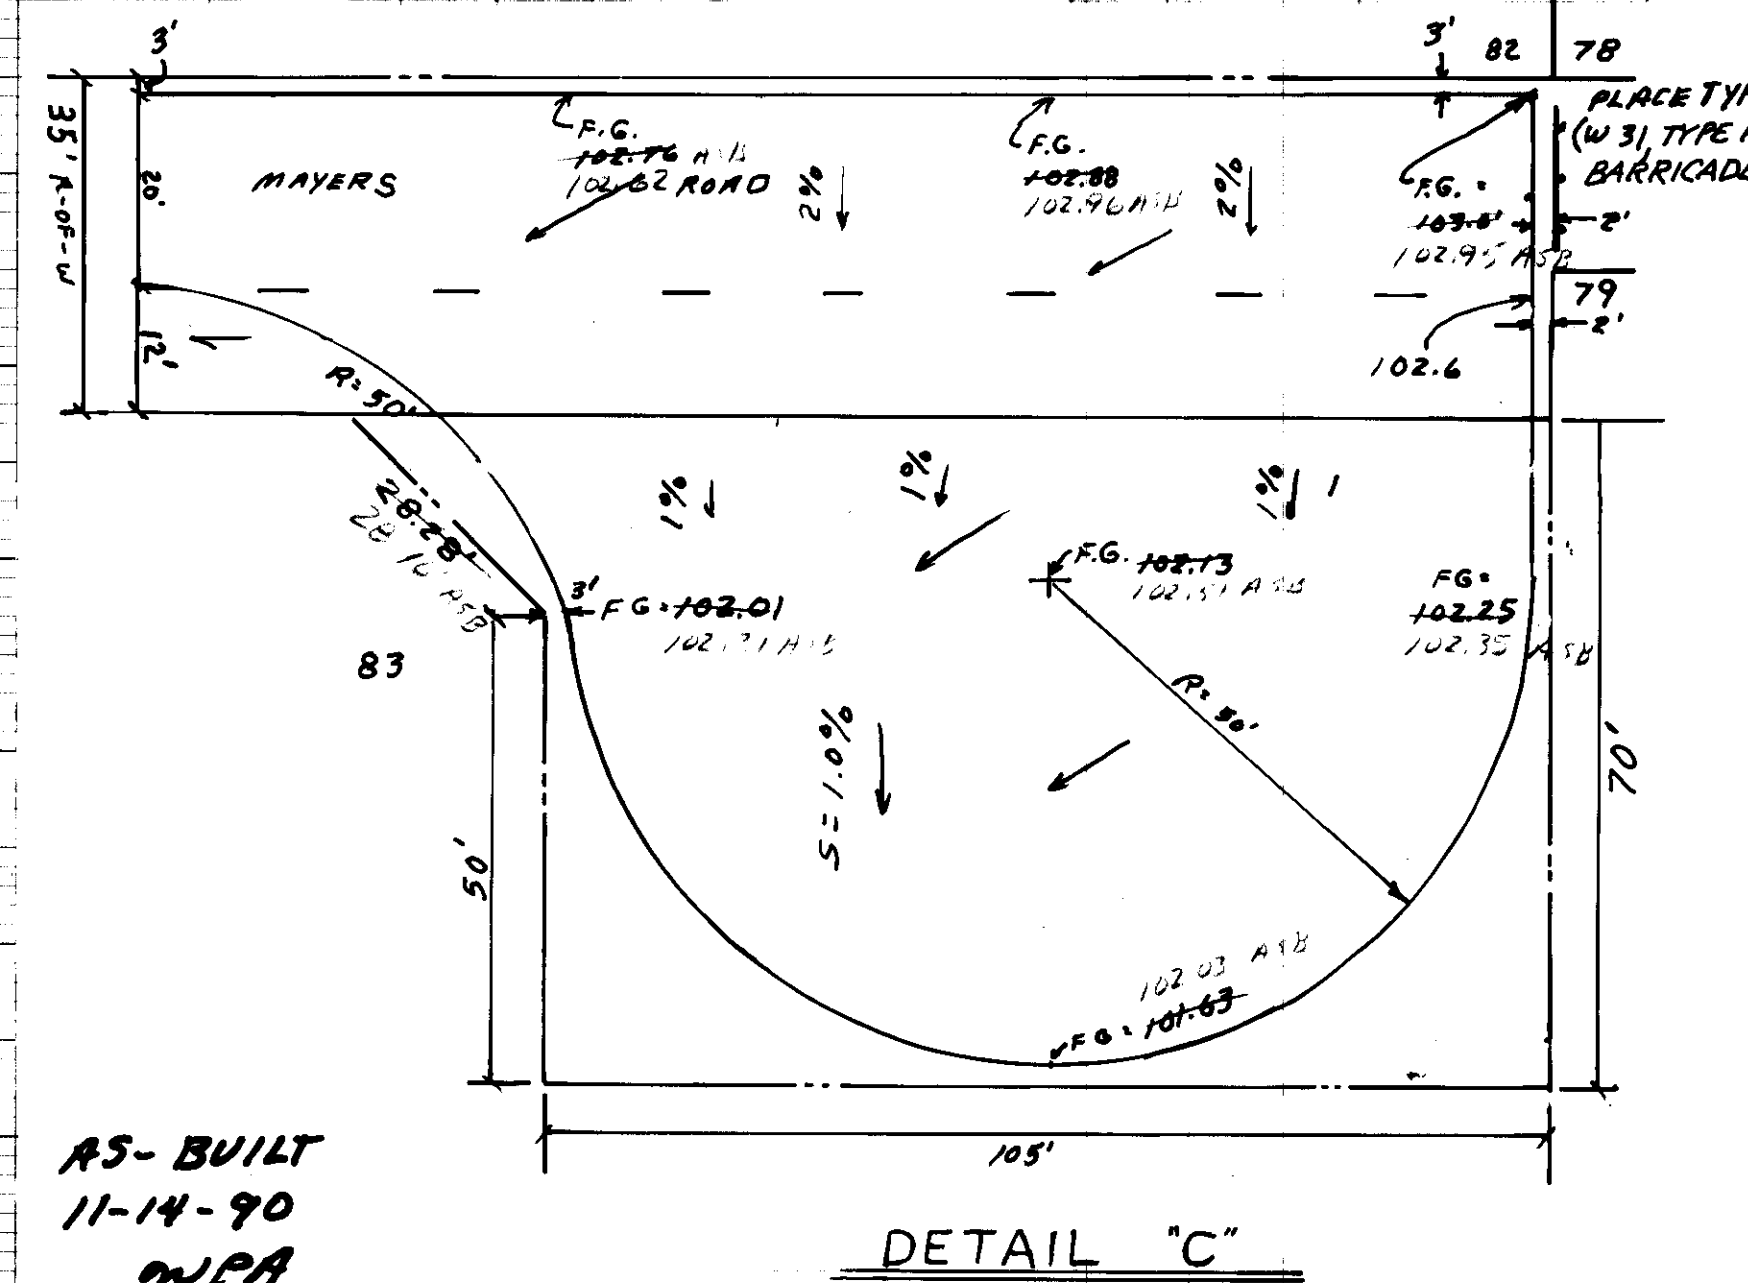

GRAPHIC SCALE									
FIELD BOOKS	REV	DATE	DESCRIPTION	BY	TBM NO.	LOCATION	ELEV.	TBM NO.	LOCATION
DESIGN			ALL SURVEY BASED ON U.S.G.S. DATUM						
STAKING									
AS BUILT									
CONTRACTOR									
INSPECTOR									
REVISIONS									
VERTICAL DATUM									
PLAN CHECK									
ENGINEERS									

ARMSTRONG ENGINEERING
3233 LANCE DR
STOCKTON CA 95205
(209) 465-1526


TRETHEWAY ROAD AND MAYERS ROAD
PRIVATE ROAD SERVING LOTS 83, 86, 91, 94, SMALL FARMS TRACT DIV "C", SEC 19, T4N, R7E, SAN JOAQUIN COUNTY

REGISTERED PROFESSIONAL ENGINEER
WILLIAM CLYDE ARMSTRONG
No. 041815
Exp. 12/31/91
CIVIL
STATE OF CALIFORNIA


SCALE: HOR. 1"=80' DATE: 10-90 GRID: VER. 1"=5' ACCT. NO. SHEET 3 of 3

34-2388

SU-2389

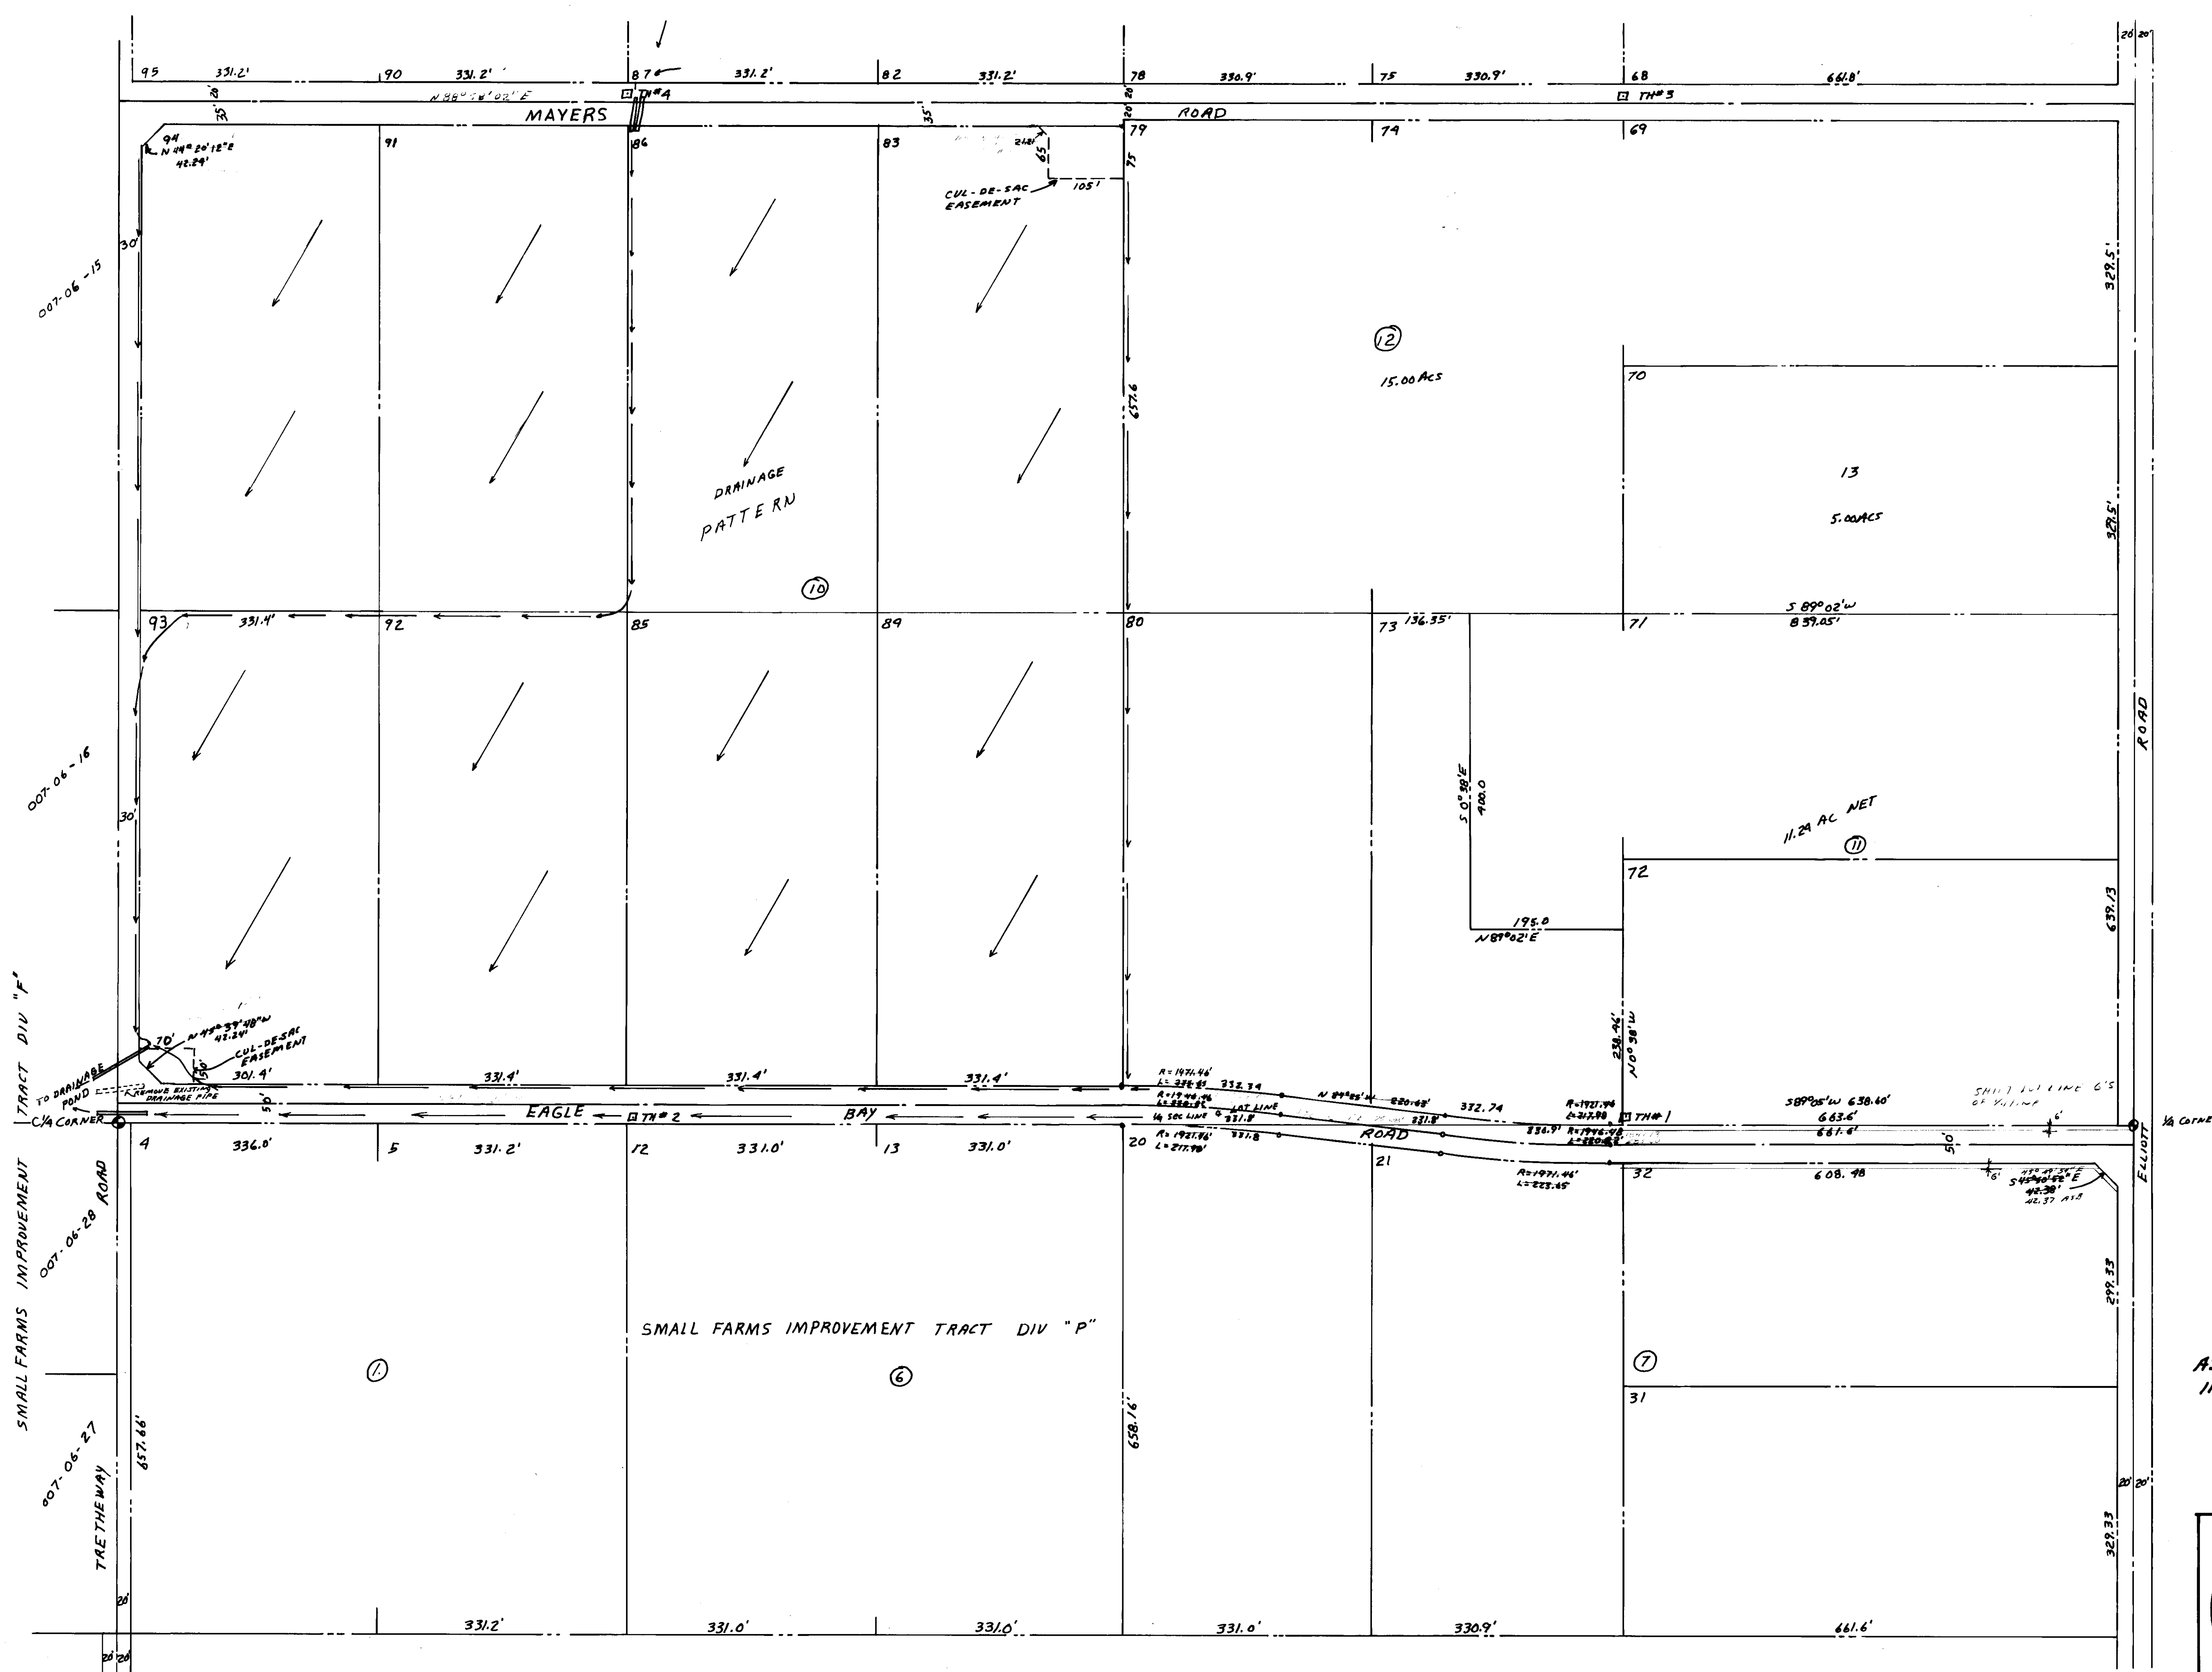

AS-BUILT
11-14-90
WCA

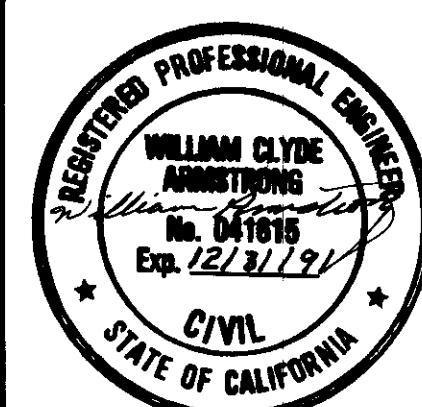

SMALL FARMS IMPROVEMENT
TRACT DIV. "C"
SAN JOAQUIN COUNTY

DATE: MAY 20, 1990
SCALE: 1" = 100'
DRAWN: WBA
JOB:
SHEET 2
OF 3 SHEETS

• MAYERS ROAD.



1. CONSTRUCTION TO MEET SAN JOAQUIN COUNTY STANDARDS EXCEPT WIDTHS

- Q STREET CENTERLINE
- R PROPERTY LINE
- o LOT CORNER (DO NOT DISTURB)
- ⊙ BENCH MARK
- # STREET SIGN
- TEST HOLE
- ⊕ TEMPORARY BENCH MARK
- DIRECTION OF DRAINAGE NATURAL

9 CONTOLLED

1. PACIFIC GAS AND ELECTRIC
2. LIBERTY RURAL COUNTY
FIRE PROTECTION DISTRICT
3. POLICE PROTECTION-SAN JOAQUIN COUNTY SHERIFF DEPT.

1. TITLE SHEET
2. KEY SHEET 2
3. PRIVATE DRIVE (TRENWAY RD Y
MAYERS ROAD)

NOTE: SEWER HOUSE SERVICE TO
BE 4" TO ON SITE SEPTIC
SYSTEM

NOTE: WATER TO BE PRIVATE
WELLS

AS-BUILT 11/12/90 WCA

APPROVED:

S. J. Sargent
FIRE CHIEF, LIBERTY FIRE DEPARTMENT

7-20-80
DATE

Henry M. Merata
PUBLIC WORKS DIRECTOR, SAN JOAQUIN COUNTY

8/14/90
DATE

[illegible]