EP.06.274 1/2

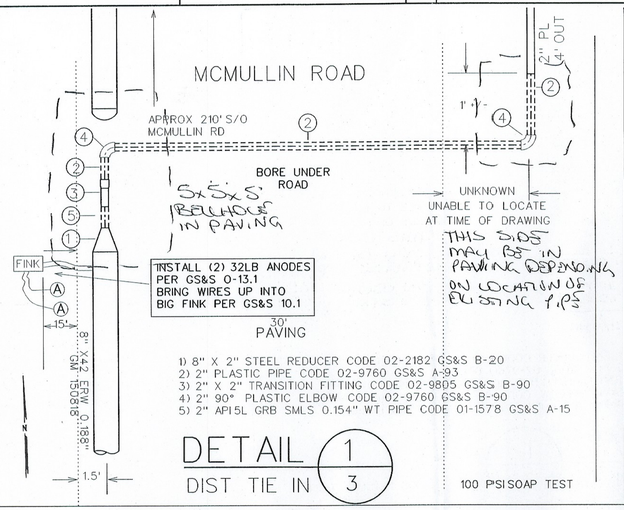

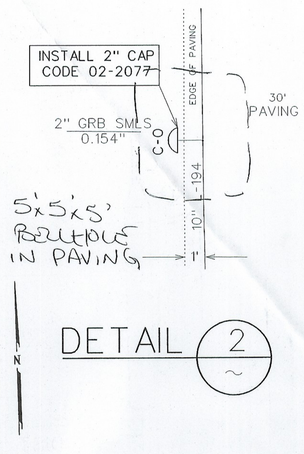

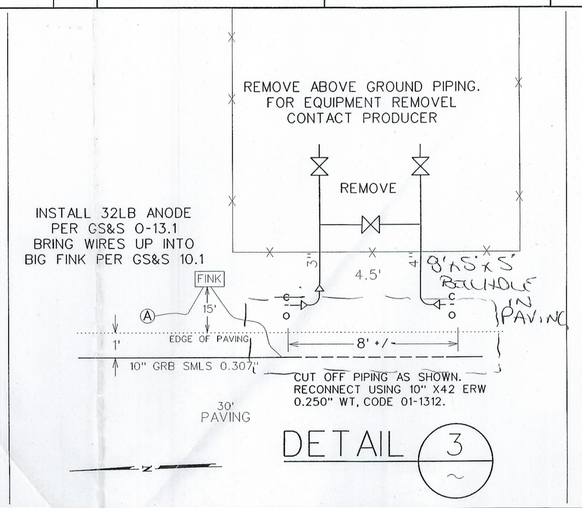

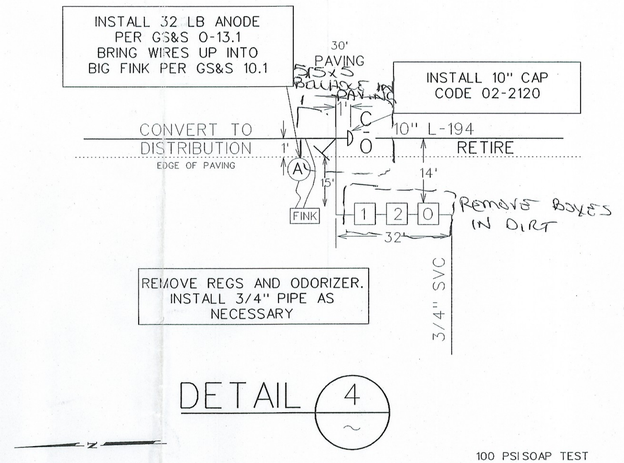

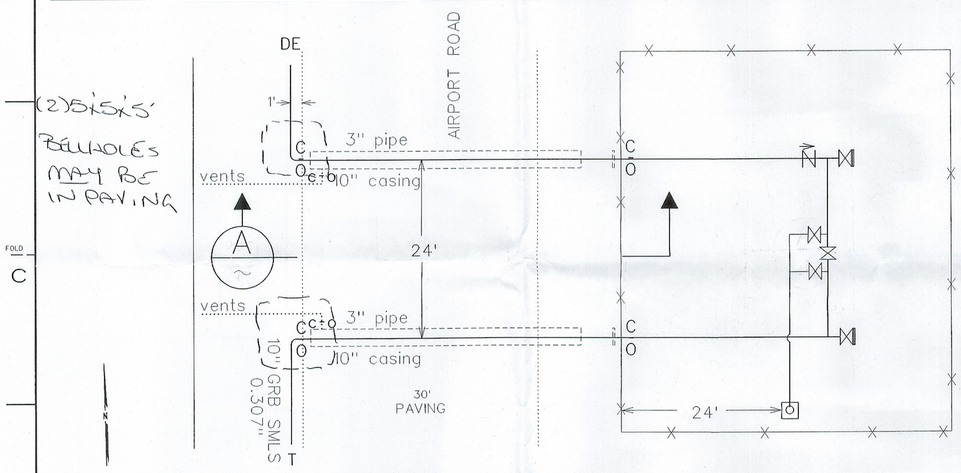

REMOVE ALL ABOVE GROUND PIPING AND VALVING. FOR EQUIPMENT REMOVAL CONTACT THOM TRIMBLE 925.974.4145

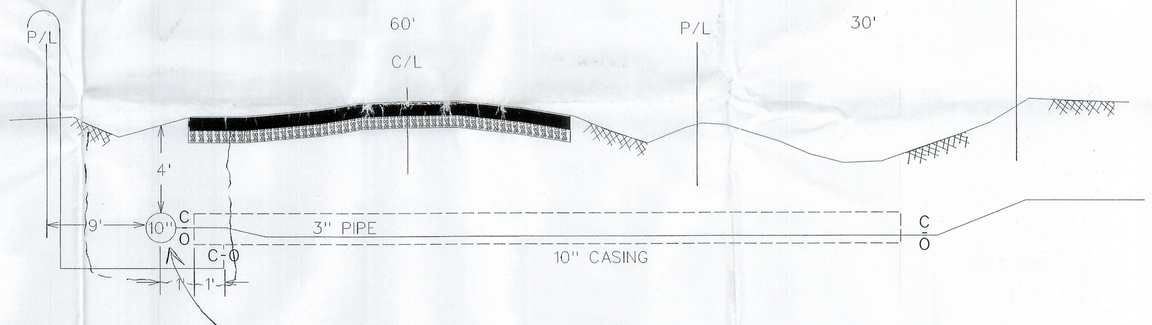

OUR AS BUILTS SHOW THIS TO BE THE LOCATION OF PIPE WITCH MEANS OUR BELLHOLES WILL BE IN PAVING. HOWEVER OUR MARK & LOCATE CREW SAID THEY FOUND PIPE 15' OFF EDGE OF PAVING IN DIRT.

DRAWN FROM AS BUILT GM 4440624 - 1984

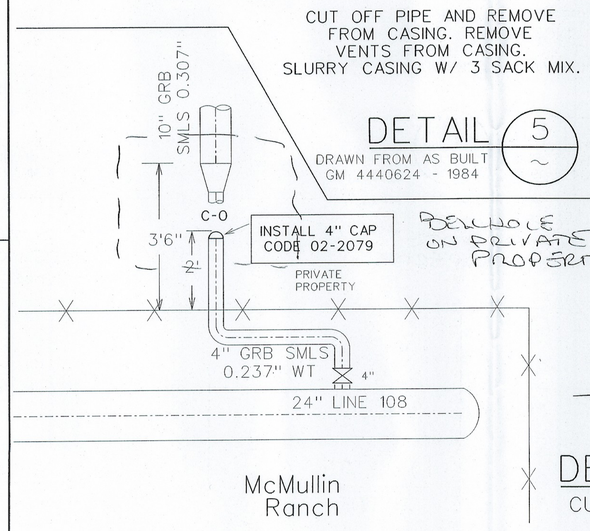

CUT OFF PIPE AND REMOVE FROM CASING. REMOVE VENTS FROM CASING. SLURRY CASING W/ 3 SACK MIX.

DRAWN FROM AS BUILT GM 4440624 - 1984

BELLHOLE ON PRIVATE PROPERTY

GC FYI:
MARK AND LOCATE LOCATED 10" PIPE 18' OFF EDGE OF PAVING IN DIRT AREA NEAR VENTS

BELLHOLE SIZES ARE APPROXIMATE. CONSTRUCTION TO DETERMINE ACTUAL SIZE.

WELDING INSPECTED PER PG&E GAS STANDARD D-40
BY_____
INSPECTOR

CALL BEFORE YOU DIG
1-800-227-2600
UNDERGROUND SERVICE ALERT

Legend
Existing
Retired

NO.	DATE	DESCRIPTION	GM/SPEC	DWN	CHKD	SUPV	APVD BY
	7/06	ISSUE TO CONSTRUCTION	7055210	CMC			

REVISIONS

APPROVED BY

SO	7055210
SUPV	
DSGN	CMC
DWN	CMC
CHKD	MAN
OK	
DATE	6/30/06
SCALES	NONE

RETIRE AND CONVERT SECTIONS OF LINE 194 MCMULLIN GAS FIELD
MANTECA- SAN JOAQUIN COUNTY
CALIFORNIA GAS TRANSMISSION
GAS TRANSMISSION & DISTRIBUTION
PACIFIC GAS AND ELECTRIC COMPANY
SAN FRANCISCO, CALIFORNIA

BILL OF MATL	
DWG LIST	
SUPSDS	
SUPSD BY	
SHEET NO. 3	3 SHEETS
7055210	REV

N180B

..\7055210\7055210.dgn 07/12/2006 10:28:18 AM