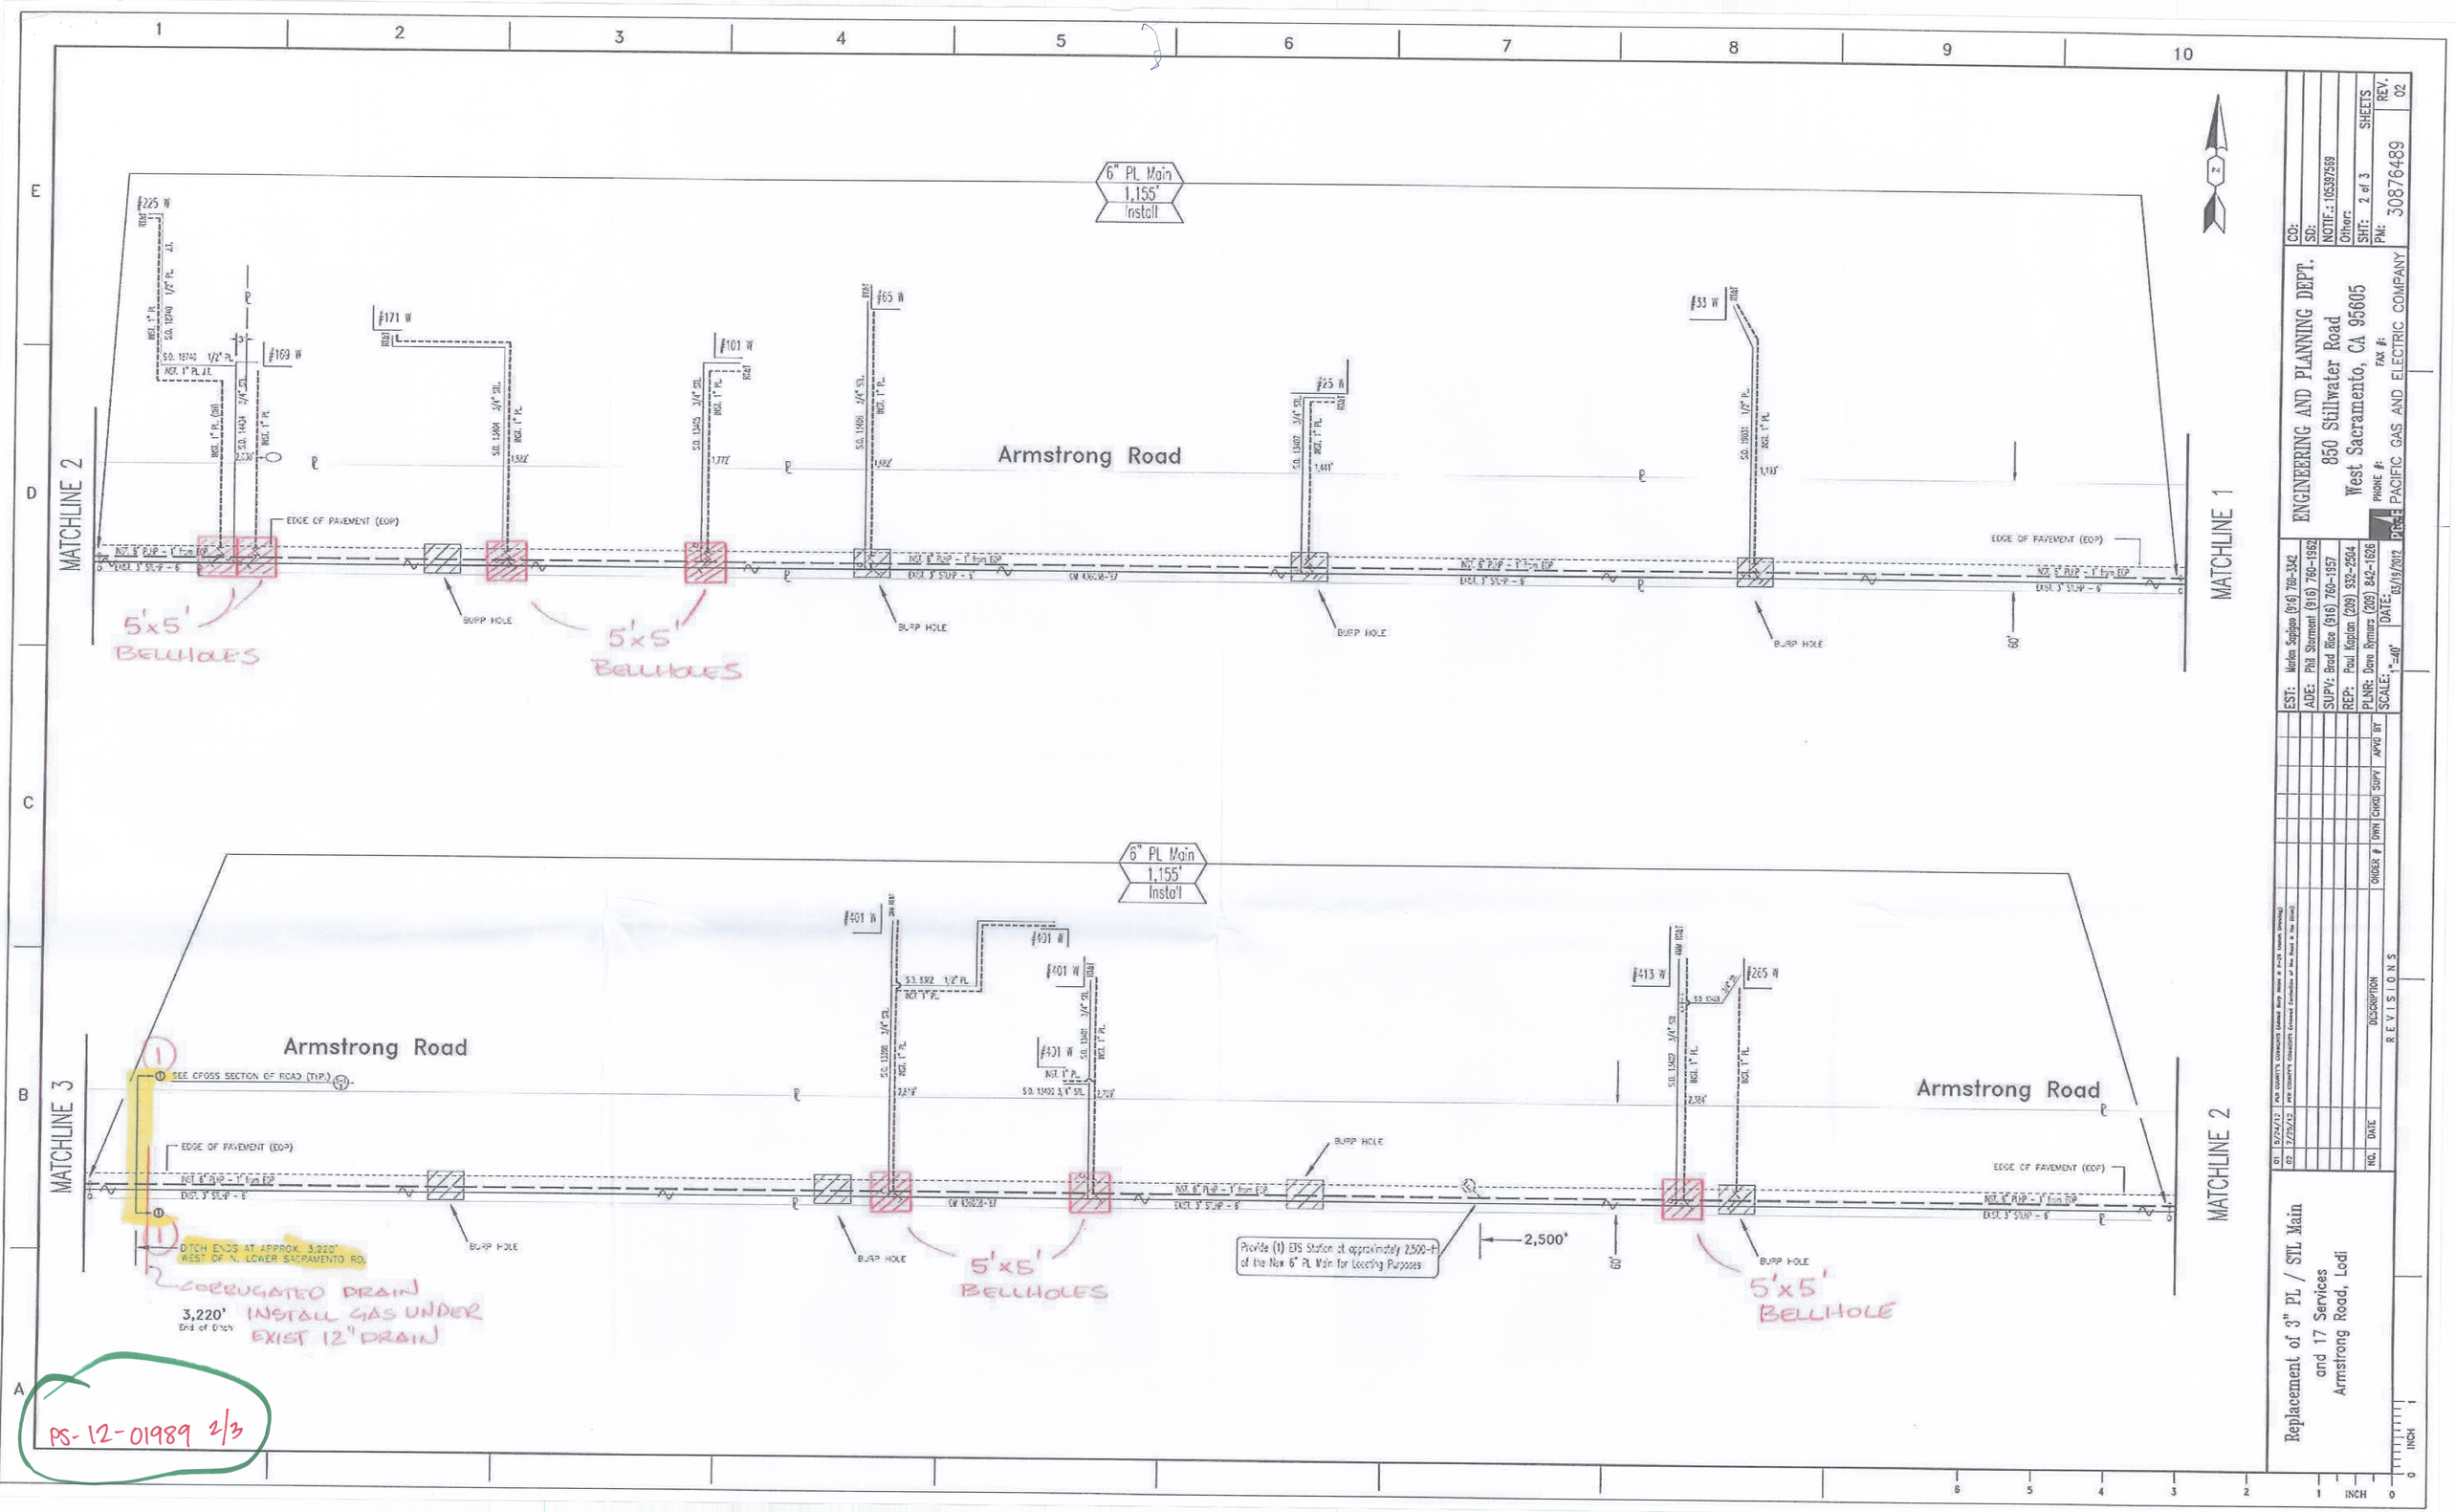

CO:
SD:
NOTIF.: 105397569
Other:
SHT: 2 of 3 SHEETS
PM: 30876489
REV. 02

ENGINEERING AND PLANNING DEPT.
850 Stillwater Road
West Sacramento, CA 95605
PHONE #:
FAX #:
PG&E PACIFIC GAS AND ELECTRIC COMPANY

EST: Marlon Sapigao (916) 780-3342
ADE: Phil Sterment (916) 780-1962
SUPV: Brad Rice (916) 780-1957
REP: Paul Kaplan (209) 932-2504
PLNR: Dave Rymers (209) 842-1626
SCALE: 1"=40'
DATE: 03/15/2012

NO.	DATE	DESCRIPTION	ORDER #	DWN	CHKD	SUPV	APVD
01	5/24/12	PER COUNTY'S COMMENTS (MINOR REDLINE REVISIONS)					
02	7/25/12	PER COUNTY'S COMMENTS (Revised Location of the Bellhole & the Ditch)					

REVISIONS

Replacement of 3" PL / STL Main
and 17 Services
Armstrong Road, Lodi