FREEWAY WILL NOT BE EFFECTED BY SHOULDER WORK

N
W E
S

SIGNS BEING USED

ROAD WORK AHEAD — 48X48" W20-1

SHOULDER CLOSED — 48x48" C30A-CA

SHOULDER CLOSED AHEAD — 48X48" W21-5

PEDESTRIAN AND BIKE ACCESS SHALL BE ALLOWED AND MAINTAINED AT ALL TIMES

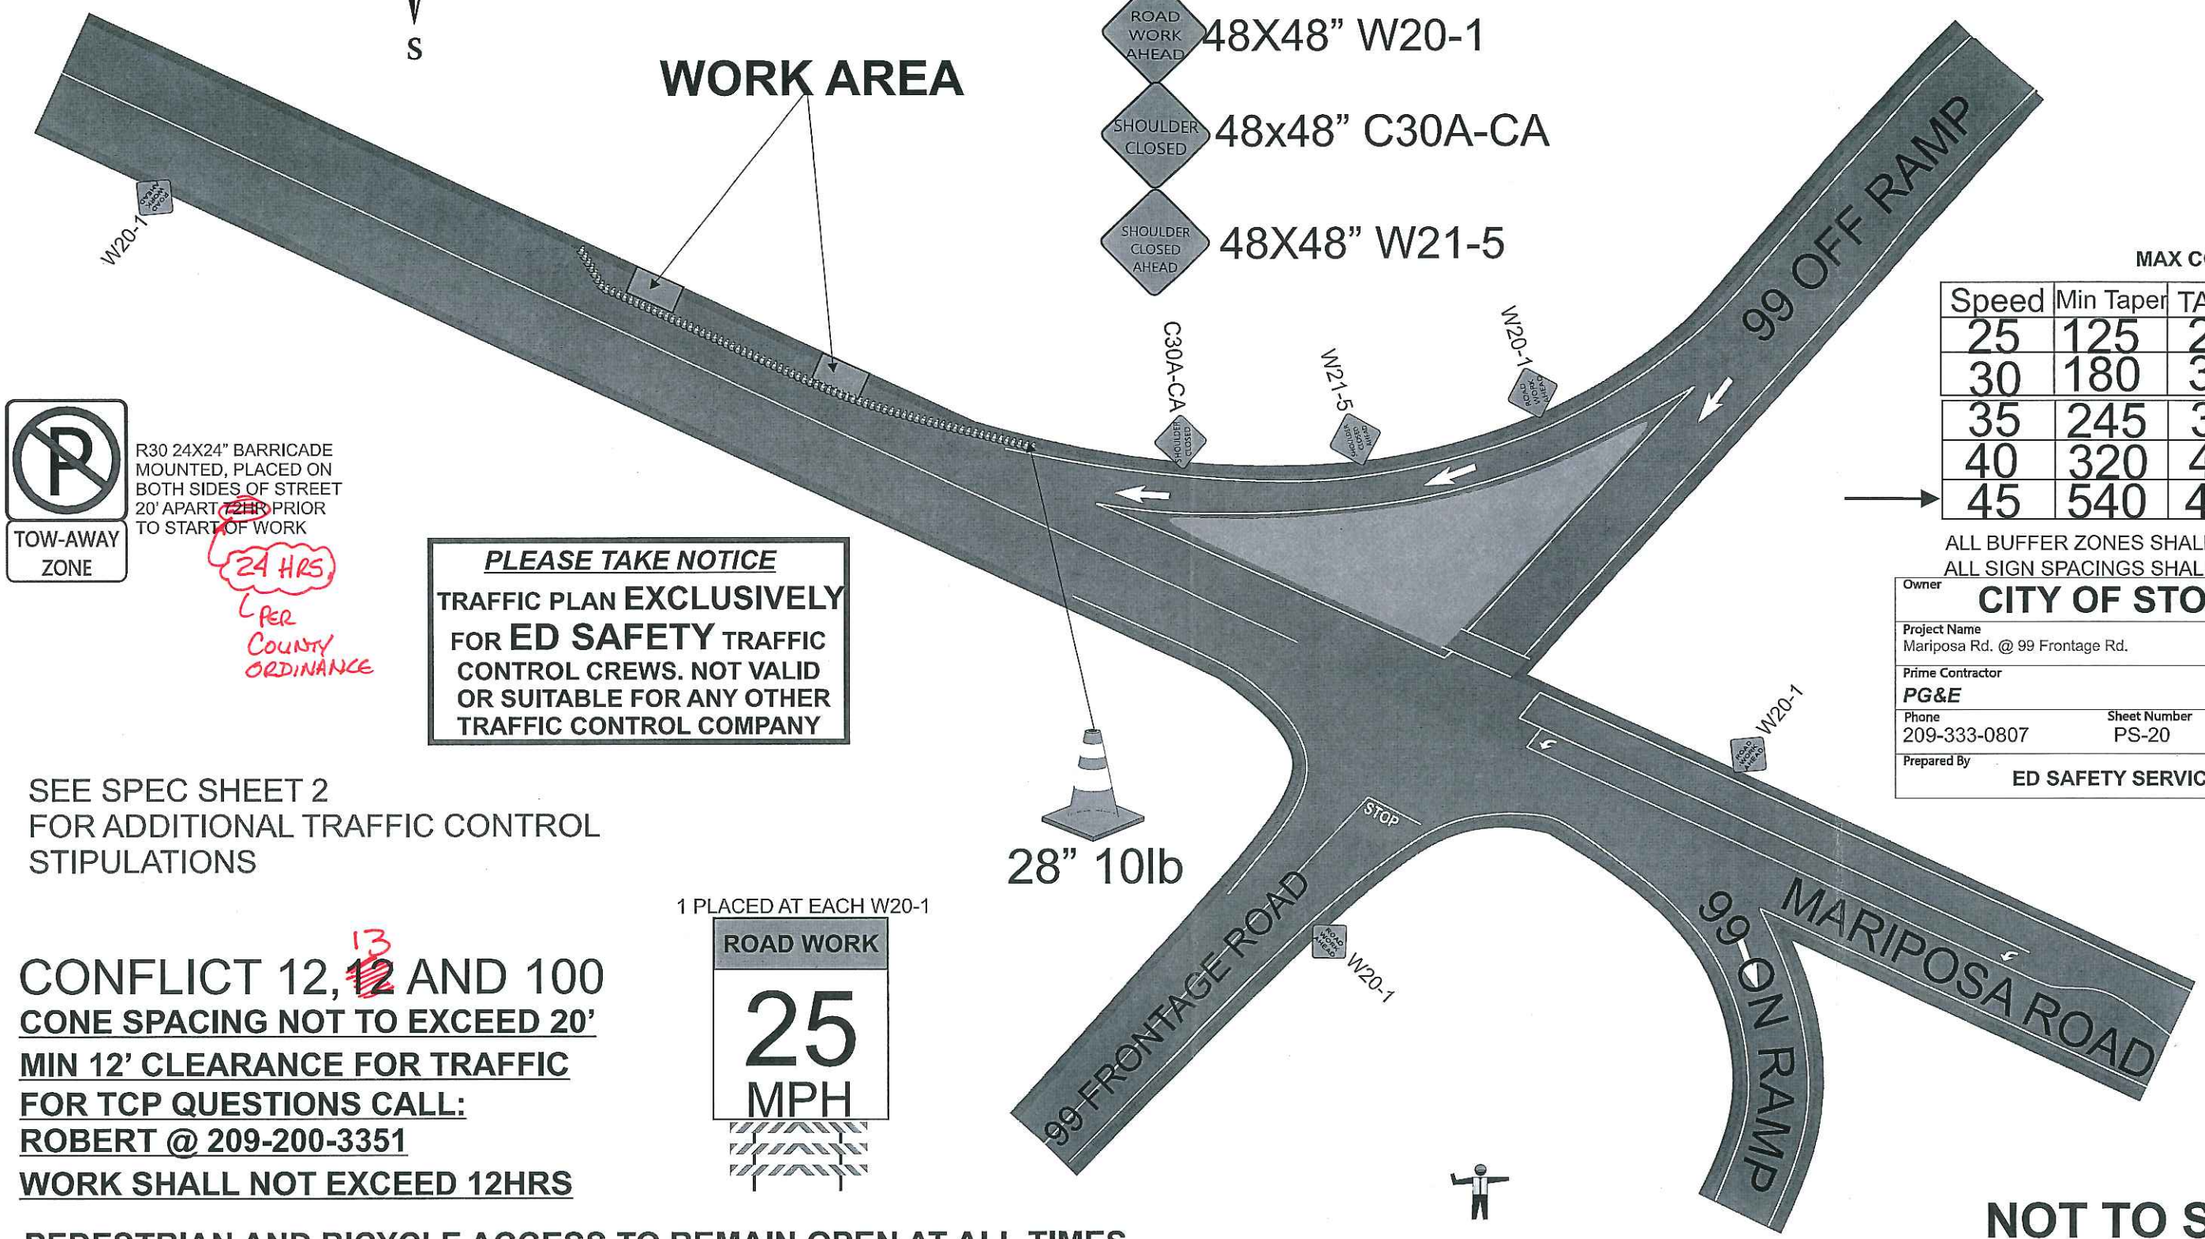

MAX CONE SPACINGS

Speed	Min Taper	TAPER	TANGENT
25	125	25	50
30	180	30	60
35	245	35	70
40	320	40	80
45	540	45	90

ALL BUFFER ZONES SHALL BE A MIN OF 540'
ALL SIGN SPACINGS SHALL BE A MIN OF 540'

Owner: **CITY OF STOCKTON**		
Project Name: Mariposa Rd. @ 99 Frontage Rd.		Project Number: Stockton,California
Prime Contractor: *PG&E*		Traffic Control Contractor: ED SAFETY INC
Phone: 209-333-0807	Sheet Number: PS-20	Date: 12/2/2012
Prepared By: ED SAFETY SERVICES, INC		

TOW-AWAY ZONE

R30 24X24" BARRICADE MOUNTED, PLACED ON BOTH SIDES OF STREET 20' APART ~~72HR~~ PRIOR TO START OF WORK

24 HRS PER COUNTY ORDINANCE

PLEASE TAKE NOTICE
TRAFFIC PLAN EXCLUSIVELY FOR ED SAFETY TRAFFIC CONTROL CREWS. NOT VALID OR SUITABLE FOR ANY OTHER TRAFFIC CONTROL COMPANY

SEE SPEC SHEET 2
FOR ADDITIONAL TRAFFIC CONTROL
STIPULATIONS

28" 10lb

1 PLACED AT EACH W20-1

ROAD WORK
25
MPH

CONFLICT 12, ~~12~~ 13 AND 100
CONE SPACING NOT TO EXCEED 20'
MIN 12' CLEARANCE FOR TRAFFIC
FOR TCP QUESTIONS CALL:
ROBERT @ 209-200-3351
WORK SHALL NOT EXCEED 12HRS

PEDESTRIAN AND BICYCLE ACCESS TO REMAIN OPEN AT ALL TIMES

PM 30649126 MIN SIGN SPACING 540'

ADDITIONAL TRAFFIC CONTROL PERSON TO MAINTAIN CLOSURE
ASSIST BICYCLE, PEDESTRIAN AND DRIVE WAY
TRAFFIC SHOULD NEED ARISE

NOT TO SCALE

HOURS OF WORK SHALL BE DETERMINED BY THE ~~CITY OF STOCKTON~~ S.J. COUNTY

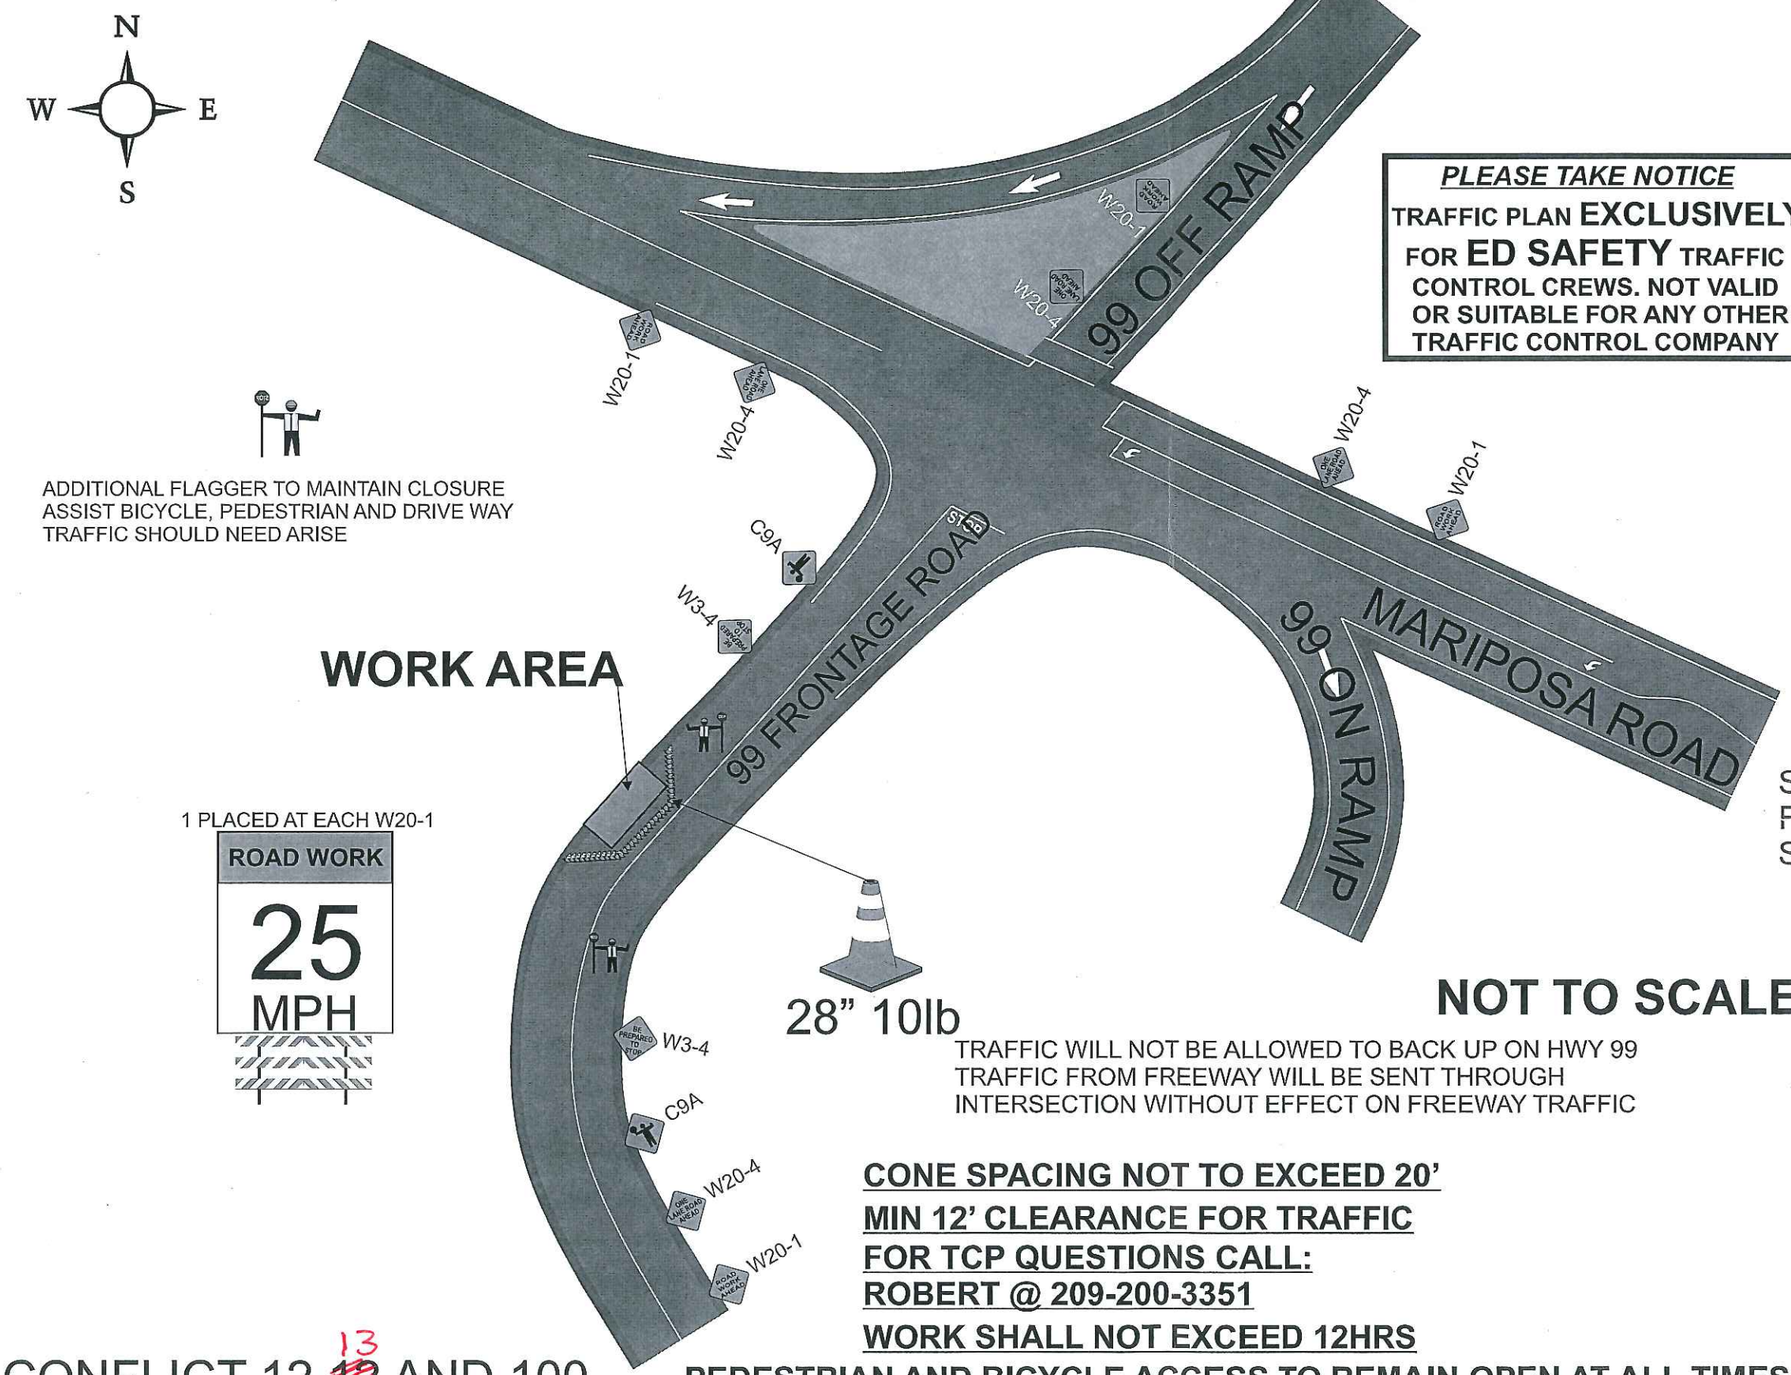

PLEASE TAKE NOTICE

TRAFFIC PLAN **EXCLUSIVELY** FOR **ED SAFETY** TRAFFIC CONTROL CREWS. NOT VALID OR SUITABLE FOR ANY OTHER TRAFFIC CONTROL COMPANY

NOT TO SCALE

PEDESTRIAN AND BIKE ACCESS SHALL BE ALLOWED AND MAINTAINED AT ALL TIMES

SIGNS BEING USED

- BE PREPARED TO STOP — 48X48" W3-4
- 48X48" C9A
- ONE LANE ROAD AHEAD — 48X48" W20-4
- ROAD WORK AHEAD — 48X48" W20-1

SEE SPEC SHEET 2
FOR ADDITIONAL TRAFFIC CONTROL
STIPULATIONS

MAX CONE SPACINGS

Speed	Min Taper	TAPER	TANGENT
25	125	25	50
30	180	30	60
35	245	35	70
40	320	40	80
45	540	45	90

NOT TO SCALE

TRAFFIC WILL NOT BE ALLOWED TO BACK UP ON HWY 99
TRAFFIC FROM FREEWAY WILL BE SENT THROUGH
INTERSECTION WITHOUT EFFECT ON FREEWAY TRAFFIC

CONE SPACING NOT TO EXCEED 20'
MIN 12' CLEARANCE FOR TRAFFIC
FOR TCP QUESTIONS CALL:
ROBERT @ 209-200-3351
WORK SHALL NOT EXCEED 12HRS
PEDESTRIAN AND BICYCLE ACCESS TO REMAIN OPEN AT ALL TIMES

ALL BUFFER ZONES SHALL BE A MIN OF 245'
ALL SIGN SPACINGS SHALL BE A MIN OF 245'

CONFLICT 12, ~~12~~ 13 AND 100
PM 30649126 MIN SIGN SPACING 245'

Owner: CITY OF STOCKTON		
Project Name: Mariposa Rd. @ 99 Frontage Rd.		Project Number: Stockton,California
Prime Contractor: PG&E		Traffic Control Contractor: ED SAFETY INC
Phone: 209-333-0807	Sheet Number: PS-21	Date: 12/2/2012
Prepared By: ED SAFETY SERVICES, INC		

HOURS OF WORK SHALL BE DETERMINED BY THE ~~CITY OF STOCKTON~~ S.J. COUNTY