ALL FLAGGERS WILL COMMUNICATE THROUGH HAND SIGNALS AND WALKIE TALKIES WITH ONE ANOTHER

PEDESTRIAN AND BICYCLE ACCESS TO REMAIN OPEN AT ALL TIMES

PEDESTRIAN AND BIKE ACCESS SHALL BE ALLOWED AND MAINTAINED AT ALL TIMES

PLEASE TAKE NOTICE

TRAFFIC PLAN EXCLUSIVELY FOR ED SAFETY TRAFFIC CONTROL CREWS. NOT VALID OR SUITABLE FOR ANY OTHER TRAFFIC CONTROL COMPANY

N W E S

NOT TO SCALE

SEE SPEC SHEET 2
FOR ADDITIONAL TRAFFIC CONTROL
STIPULATIONS

TOW-AWAY ZONE

R30 24X24" BARRICADE MOUNTED, PLACED ON BOTH SIDES OF STREET 20' APART ~~72HR~~ 24 HRS. PRIOR TO START OF WORK

1 PLACED AT EACH W20-1

ROAD WORK
25
MPH

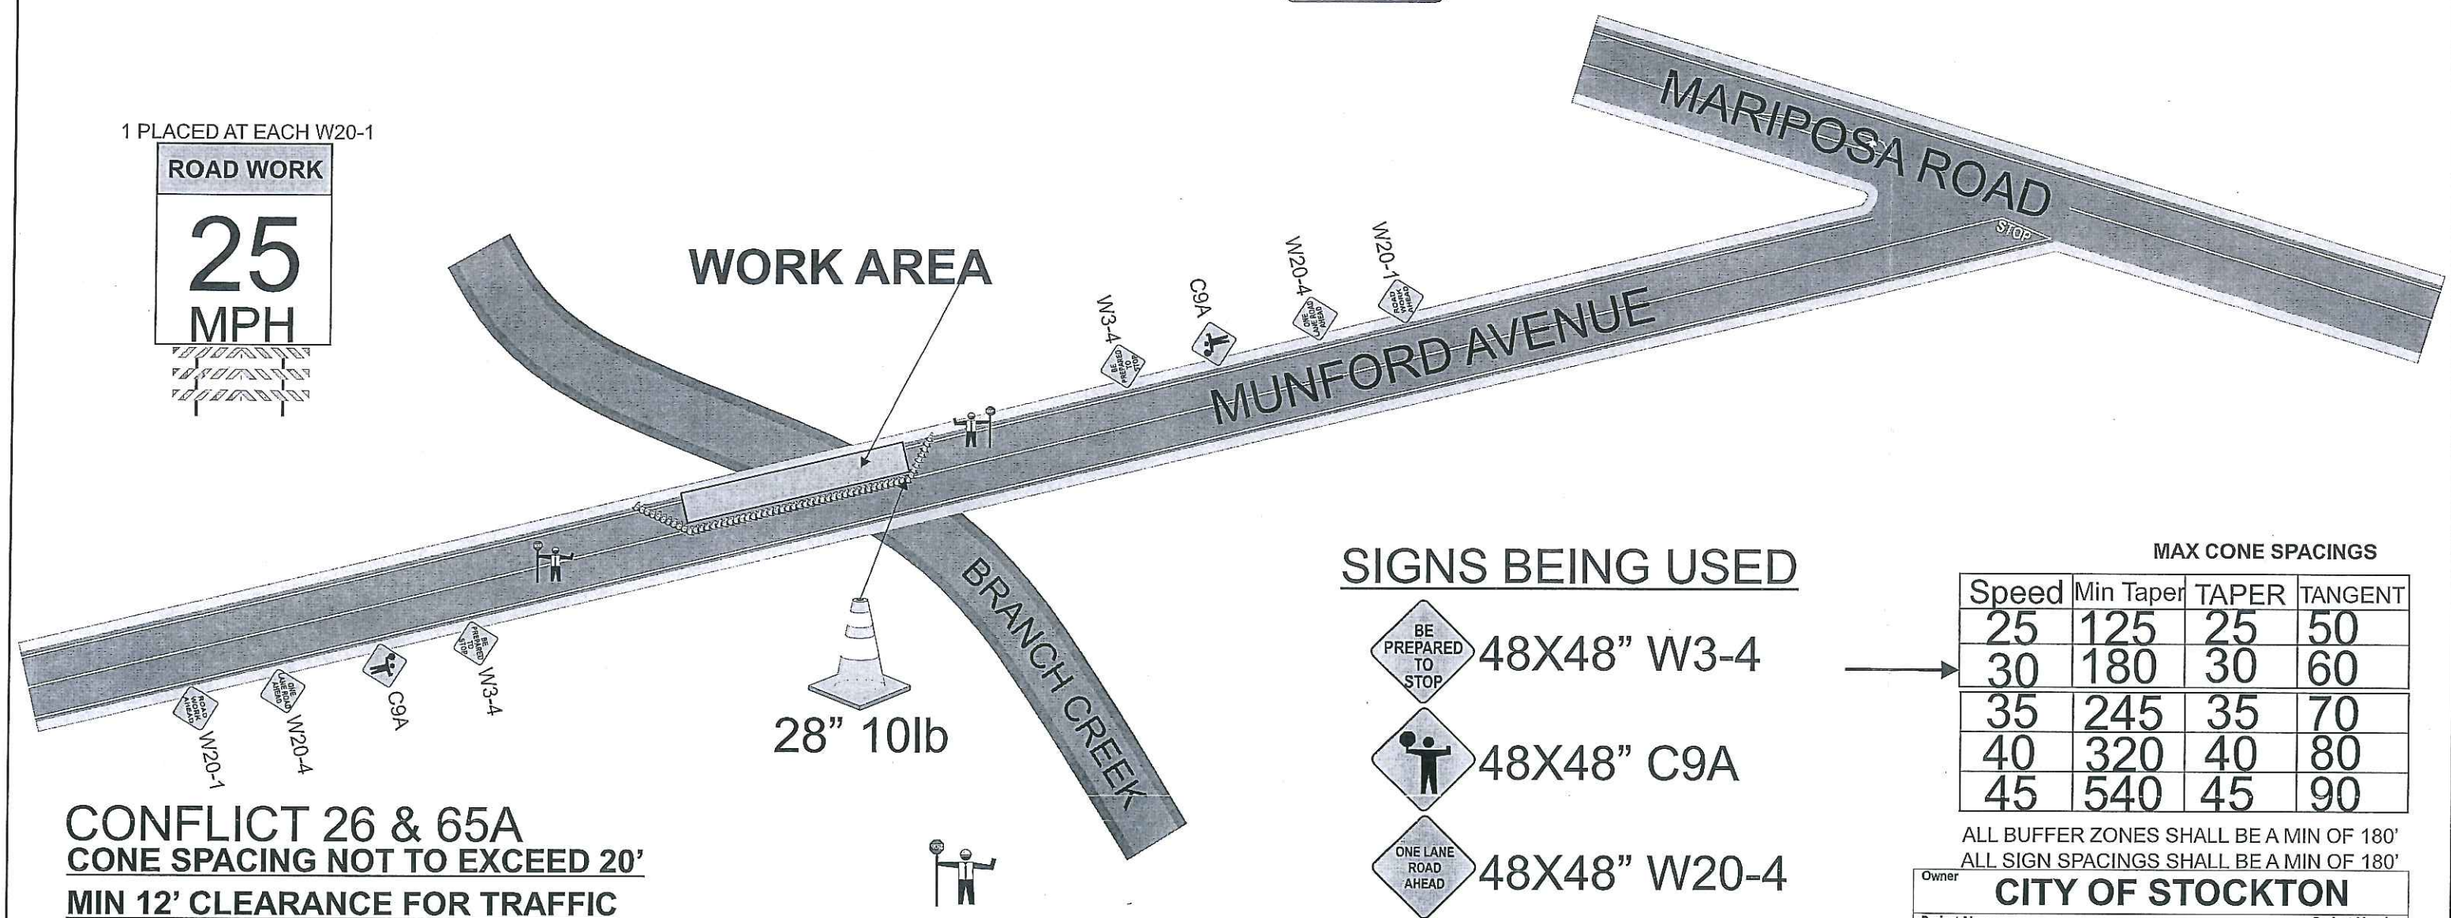

ADDITIONAL FLAGGER TO MAINTAIN CLOSURE ASSIST BICYCLE, PEDESTRIAN AND DRIVE WAY TRAFFIC SHOULD NEED ARISE

SIGNS BEING USED

- BE PREPARED TO STOP — 48X48" W3-4
- 48X48" C9A
- ONE LANE ROAD AHEAD — 48X48" W20-4
- ROAD WORK AHEAD — 48X48" W20-1

MAX CONE SPACINGS

Speed	Min Taper	TAPER	TANGENT
25	125	25	50
30	180	30	60
35	245	35	70
40	320	40	80
45	540	45	90

ALL BUFFER ZONES SHALL BE A MIN OF 180'
ALL SIGN SPACINGS SHALL BE A MIN OF 180'

CONFLICT 26 & 65A
CONE SPACING NOT TO EXCEED 20'
MIN 12' CLEARANCE FOR TRAFFIC
FOR TCP QUESTIONS CALL:
ROBERT @ 209-200-3351
WORK SHALL NOT EXCEED 12HRS
PM 30649126 MIN SIGN SPACING 180'

Owner	**CITY OF STOCKTON**
Project Name	Munford Ave. @ Mariposa Rd.
Project Number	Stockton,California
Prime Contractor	*PG&E*
Traffic Control Contractor	**ED SAFETY INC**
Phone	209-333-0807
Sheet Number	PS-25
Date	12/3/2012
Prepared By	**ED SAFETY SERVICES, INC**

HOURS OF WORK SHALL BE DETERMINED BY THE ~~CITY OF STOCKTON~~ SJ COUNTY