<(1- pothole)>

BZ

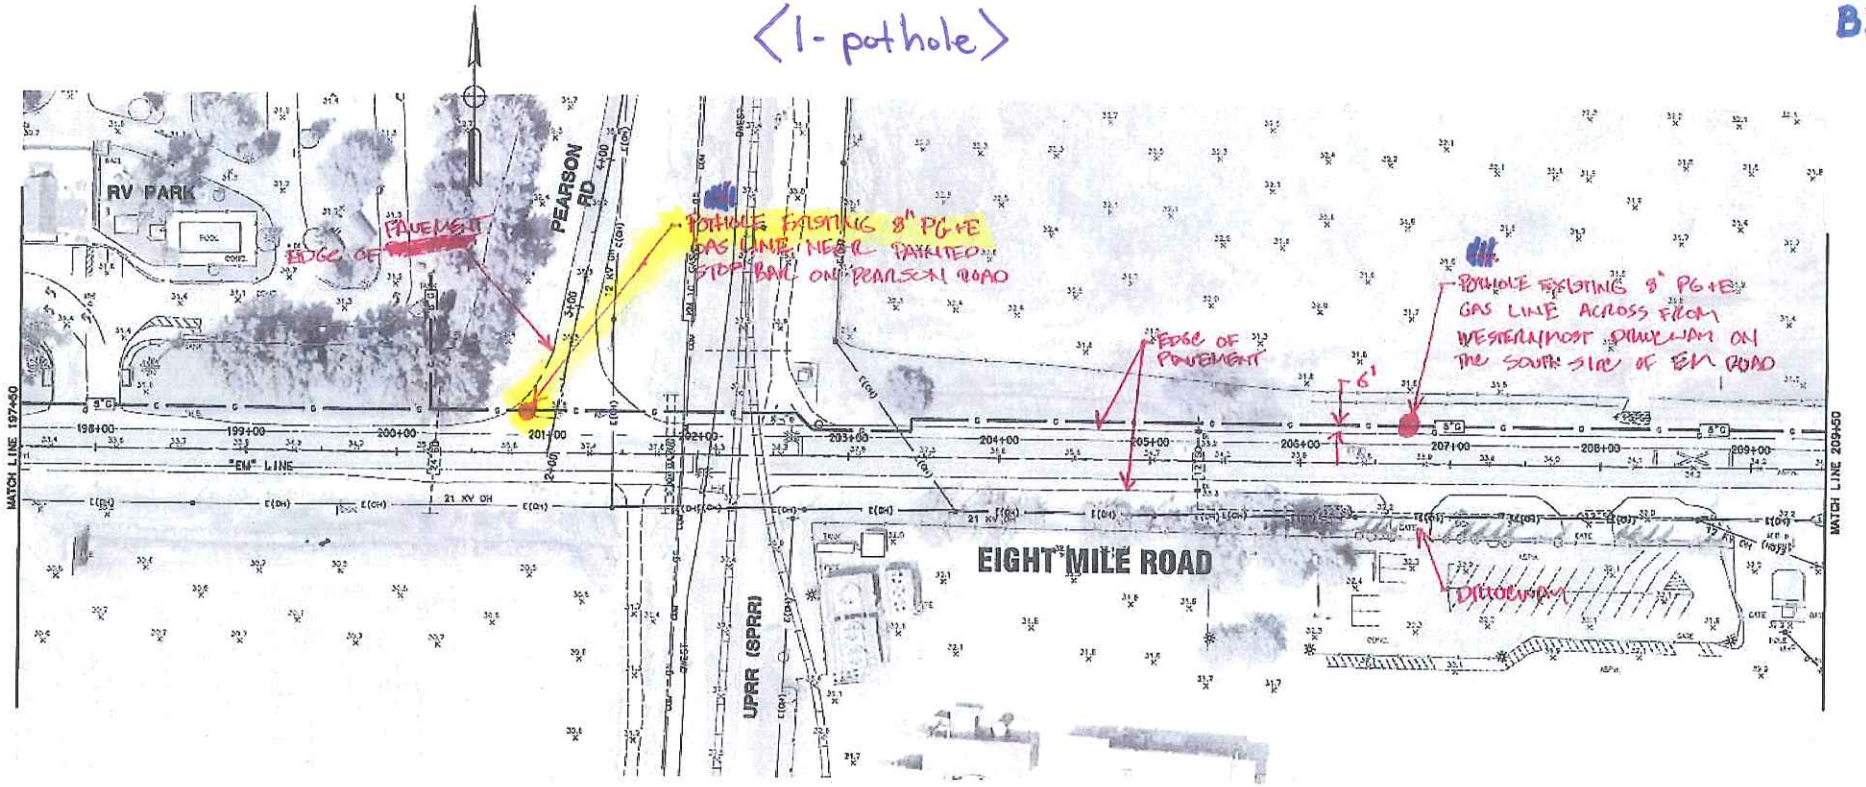


BEFORE EXCAVATING
CALL U.S.A.
UNDERGROUND SERVICE ALERT
800-227-2600
TOLL FREE
2 WORKING DAYS BEFORE ALL
PLANNED WORK OPERATIONS

CALL BEFORE YOU DIG
800-336-3193

ORIGINAL SCALE IN INCHES
FOR REDUCED PLAN
0 1 2 3


MARK THOMAS & COMPANY, INC.
7300 FOLSOM BOULEVARD, SUITE 203
SACRAMENTO, CALIFORNIA 95826
(916) 381-9100 FAX: (916) 381-9180


MTCO JOB NUMBER: 57-0221B

REGISTERED PROFESSIONAL ENGINEER
ROBERT A. HILES
No. 45787
Exp. 12/31/10
CIVIL
STATE OF CALIFORNIA

100% SUBMITTAL

| Revision No. | Description | Date | By | Approd. By |
|---|---|---|---|---|
| | | | | |

EIGHT MILE ROAD/UPRR (SPRR) OVERHEAD

POTHOLE LOCATIONS

CITY OF STOCKTON
PUBLIC WORKS DEPARTMENT

| | |
|---|---|
| SCALE: | 1"=40' |
| DESIGNED BY: | DHW |
| DRAWN BY: | JKM, AMR, RBS |
| CHECKED BY: | MAS |
| RECORD DWG: | |

APPROVED BY: _____ DATE

CITY ENGINEER
STOCKTON, CALIFORNIA

SHEET NO.: 2
OF 11 SHEETS
PROJECT NO. 05-17

C1

~~SHOW POTHOLES~~

<3- potholes>

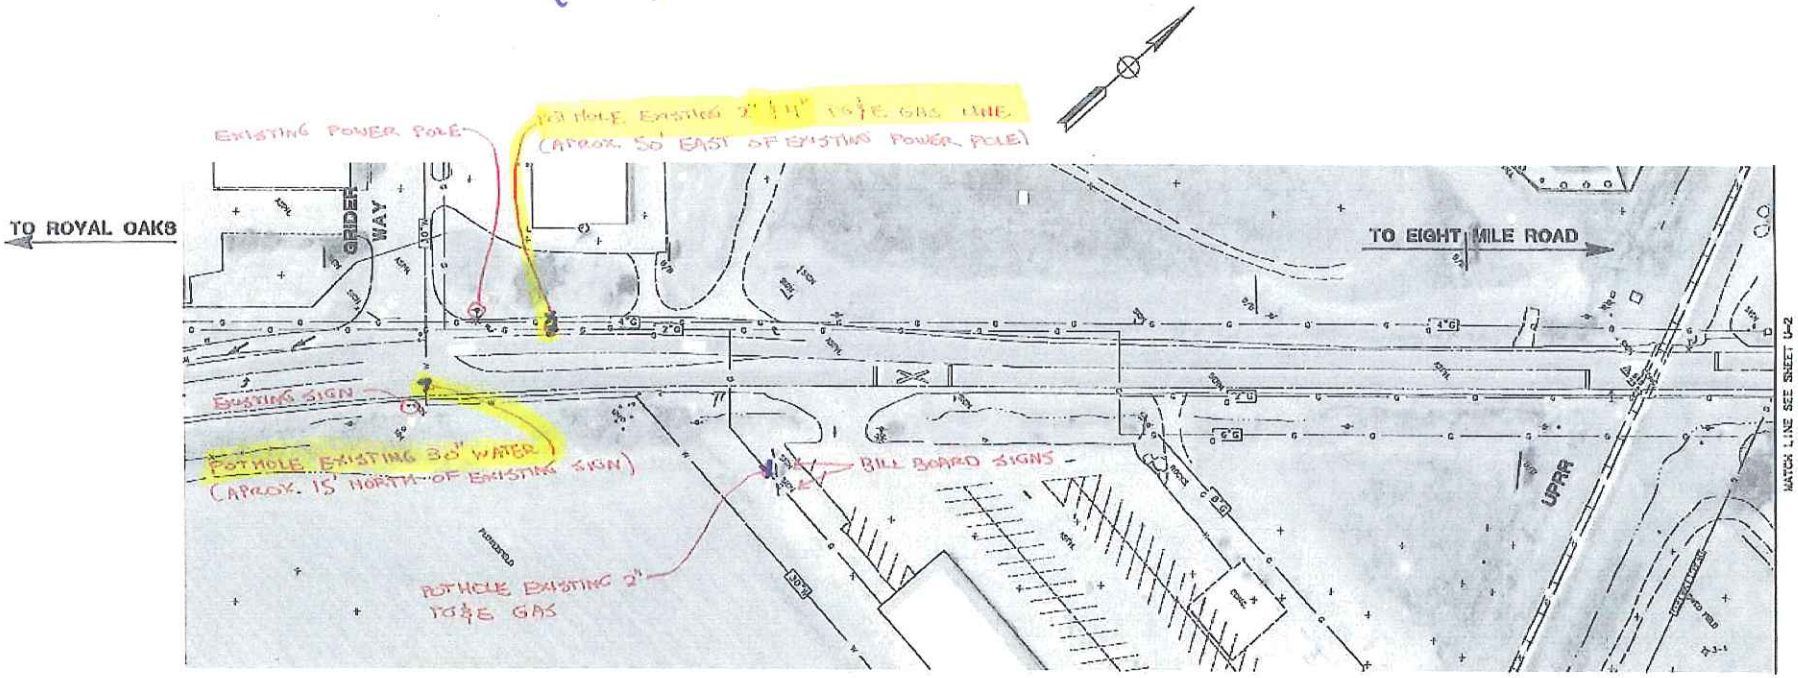


**LOWER SACRAMENTO ROAD**

100% SUBMITTAL

BEFORE EXCAVATING
CALL U.S.A.
UNDERGROUND SERVICE ALERT
800-227-2600
TOLL FREE
2 WORKING DAYS BEFORE ALL
PLANNED WORK OPERATIONS

UNION PACIFIC
CALL BEFORE YOU DIG
800-336-9193

ORIGINAL SCALE IN INCHES
FOR REDUCED PLAN
0 1 2 3

MARK THOMAS & COMPANY, INC.
7300 FOLSOM BOULEVARD, SUITE 203
SACRAMENTO, CALIFORNIA 95826
(916) 361-9100 FAX: (916) 361-9183

UTCD JOB NUMBER: 57-0228B

REGISTERED PROFESSIONAL ENGINEER
ROBERT A. JAMES
No. 45787
Exp. 12/31/10
CIVIL
STATE OF CALIFORNIA

| Revision No. | Description | Date | By | Appvd. By |
|---|---|---|---|---|
| | | | | |

LOWER SACRAMENTO ROAD/UPRR UNDERPASS

UTILITIES

CITY OF STOCKTON
PUBLIC WORKS DEPARTMENT

SCALE: 1"=40'
DESIGNED BY: DWM
DRAWN BY: JKM, JWR, BRS
CHECKED BY: WAS
RECORD DWG:

APPROVED BY: _____ DATE
CITY ENGINEER
STOCKTON, CALIFORNIA

SHEET NO.: U-1
OF 24 SHEETS
PROJECT NO. 05-17

C2

<1-pothole>

UPRR

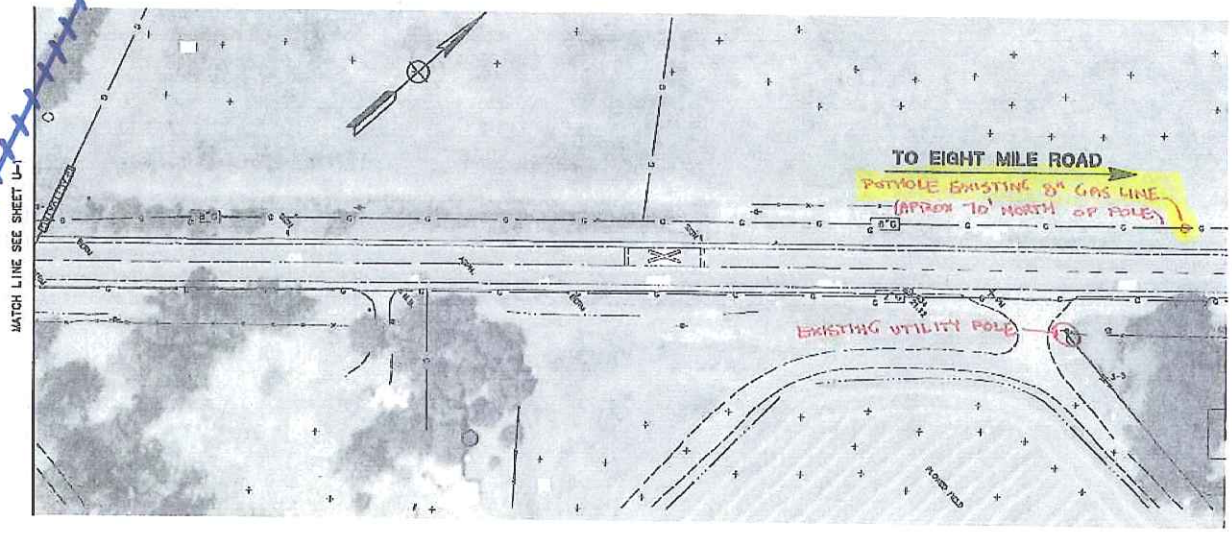


**LOWER SACRAMENTO ROAD**

100% SUBMITTAL

BEFORE EXCAVATING
CALL U.S.A.
UNDERGROUND SERVICE ALERT
800-227-2600
TOLL FREE
2 WORKING DAYS BEFORE ALL
PLANNED WORK OPERATIONS

ORIGINAL SCALE IN INCHES
FOR REDUCED PLAN
0 1 2 3

MARK THOMAS & COMPANY, INC.
7300 FOLSOM BOULEVARD, SUITE 203
SACRAMENTO, CALIFORNIA 95826
(916) 381-9100 FAX: (916) 381-9160

UTCO JOB NUMBER: 57-02210

REGISTERED PROFESSIONAL ENGINEER
ROBERT A. HAMES
No. 45787
Exp. 12/31/00
CIVIL
STATE OF CALIFORNIA

| Revision No. | Description | Date | By | Appvd By |
|---|---|---|---|---|
| | | | | |

LOWER SACRAMENTO ROAD/UPRR UNDERPASS

UTILITIES

CITY OF STOCKTON
PUBLIC WORKS DEPARTMENT

SCALE: 1"=10'
DESIGNED BY: DNM
DRAWN BY: JKM, AKM, DES
CHECKED BY: MAS
RECORD DWG:

APPROVED BY: DATE
CITY ENGINEER
STOCKTON, CALIFORNIA

SHEET NO.: U-2
OF XX SHEETS
PROJECT NO. 05-19