INDEX OF SHEETS

SHEET NO.	TITLE PAGE
" " 2	TYPICAL SECTIONS, CONSTRUCTION NOTES & CONSTRUCTION DETAILS
" " 3-6	EIGHT MILE ROAD PROFILE
" " 1-15	EIGHT MILE ROAD X-SECTIONS

COUNTY OF SAN JOAQUIN

DEPARTMENT OF PUBLIC WORKS

STOCKTON, CALIFORNIA

PLAN AND PROFILE

COUNTY OF SAN JOAQUIN

Submitted Mar. 4 1975

William J. Ward

WILLIAM J. WARD R.E. 9338

Director of Public Works

WALNUT GROVE ROAD & EIGHT MILE ROAD

TO BE SUPPLEMENTED BY STANDARD PLANS DATED JANUARY 1975

AS BUILT

CORRECTIONS BY

NO CHANGES R. Hiab

DATE 6-13-75

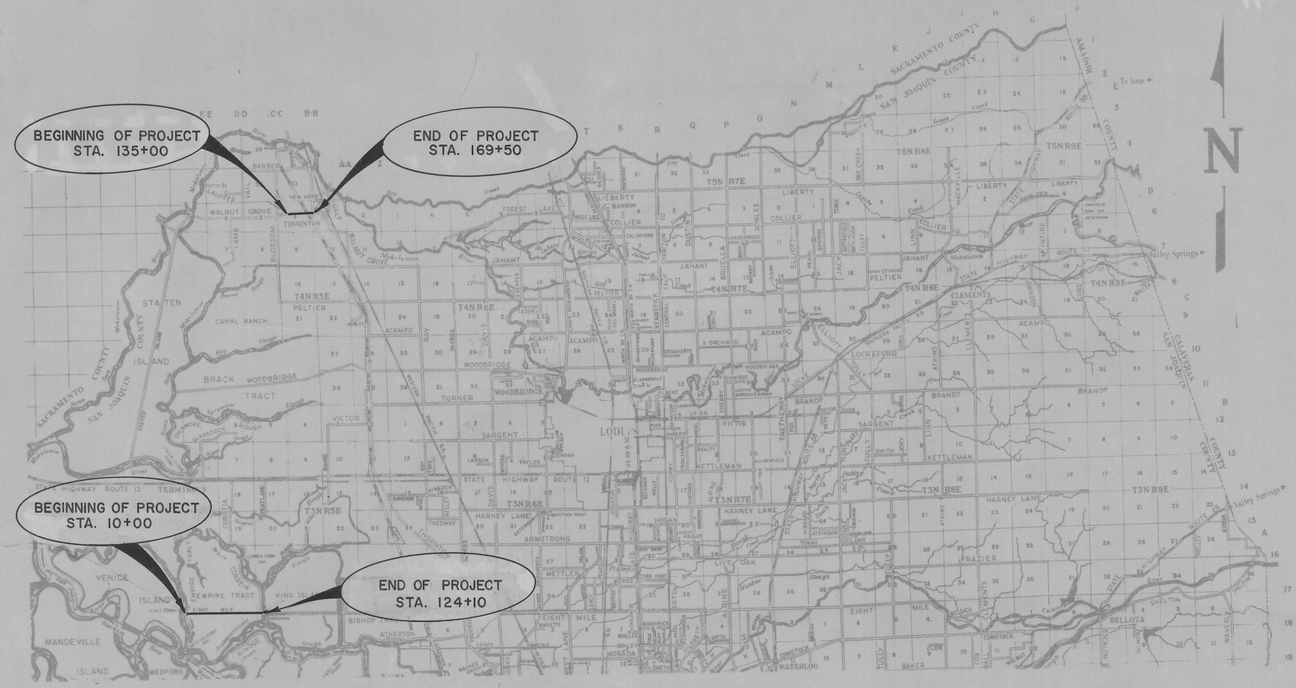

LAYOUT PLAN & PROJECT LOCATION MAP

SCALE: 1" = 2 MILES

— ABBREVIATIONS —

A.B.	=	Aggregate Base
A.C.	=	Asphalt Concrete
A.C.P.	=	Asbestos Cement Pipe
A.S.	=	Aggregate Subbase
Blt. Cd.	=	Bituminous Coated
℄	=	Center Line
C.P.	=	Concrete Pipe
C.S.P.	=	Corrugated Steel Pipe
C.S.P.A.	=	Corrugated Steel Pipe Arch
D.I.	=	Drainage Inlet
Dr.	=	Driveway
E.P.	=	Edge of Pavement
E.S.C.P.	=	Extra Strength Concrete Pipe
℄	=	Flow Line
L.F.	=	Linear Feet
M.H.	=	Manhole
O.G.	=	Original Ground
P.C.C.	=	Portland Cement Concrete
Pen. Tr.	=	Penetration Treatment
℄	=	Property Line
P.M.S.	=	Plant Mixed Surfacing
R.C.P.	=	Reinforced Concrete Pipe
R & D	=	Remove and Dispose
R & S	=	Remove and Salvage
R/W	=	Right of Way
S-Dr.	=	Side Drain
S.P.	=	Standard Plans
X-Dr.	=	Cross Drain

Project Engineer	Date	Associate Engineer	Date	Approval Recommended By	Date
R. S. Baer	1-75	Henry Hirata R.E. 21258		Lyal Swearingen R.E. 16444	3/13/75