ROAD NO.	INDEX	FILE NO.	YEAR	SHEET NO.	TOTAL SHEETS

PROFILE X-SEC | PLOTTED BY Dm | CHECKED BY DON | DATE 10-74

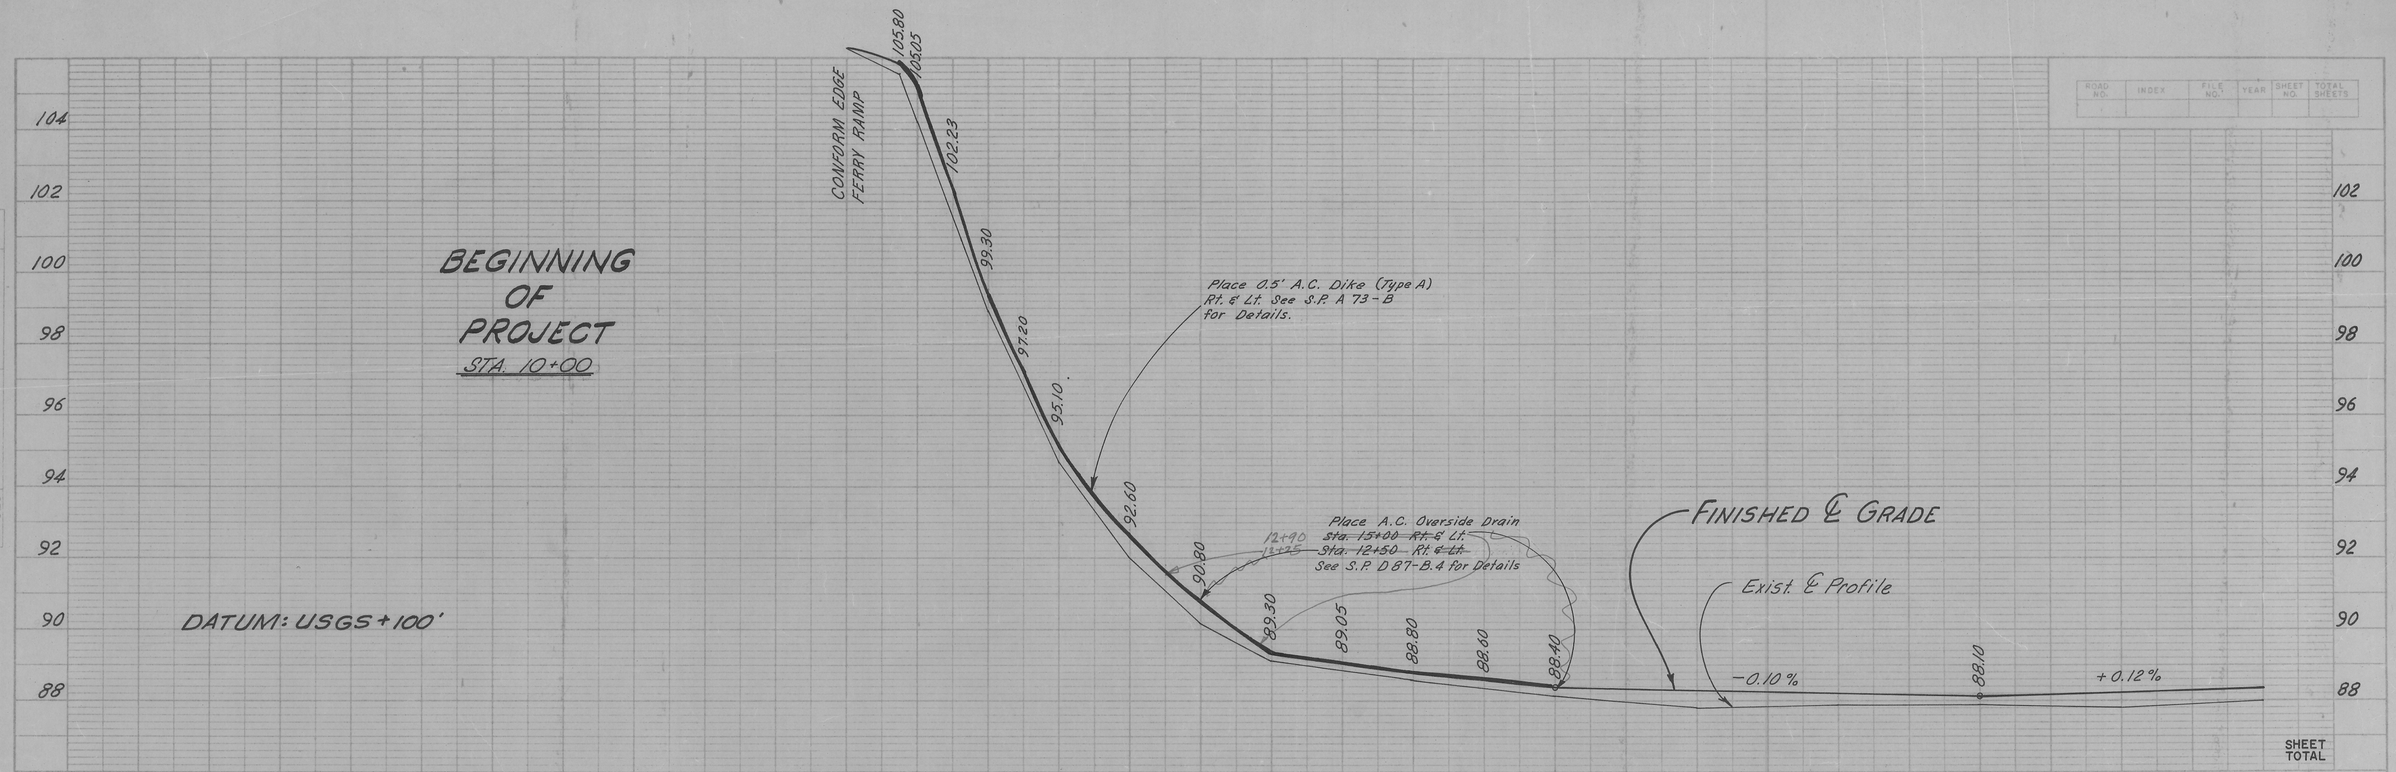

Station	10+00	1	2	3	4	5	6	7	8	9	20+00	SHEET TOTAL
Cu. Yds. Emb. Lt.	6	24	33	25	14	13	27	32	33	40		
Cu. Yds. Emb. Rt.	8	8	0	0	14	28	14	0	0	0		

PROFILE X-SEC | PLOTTED BY | CHECKED BY | DATE

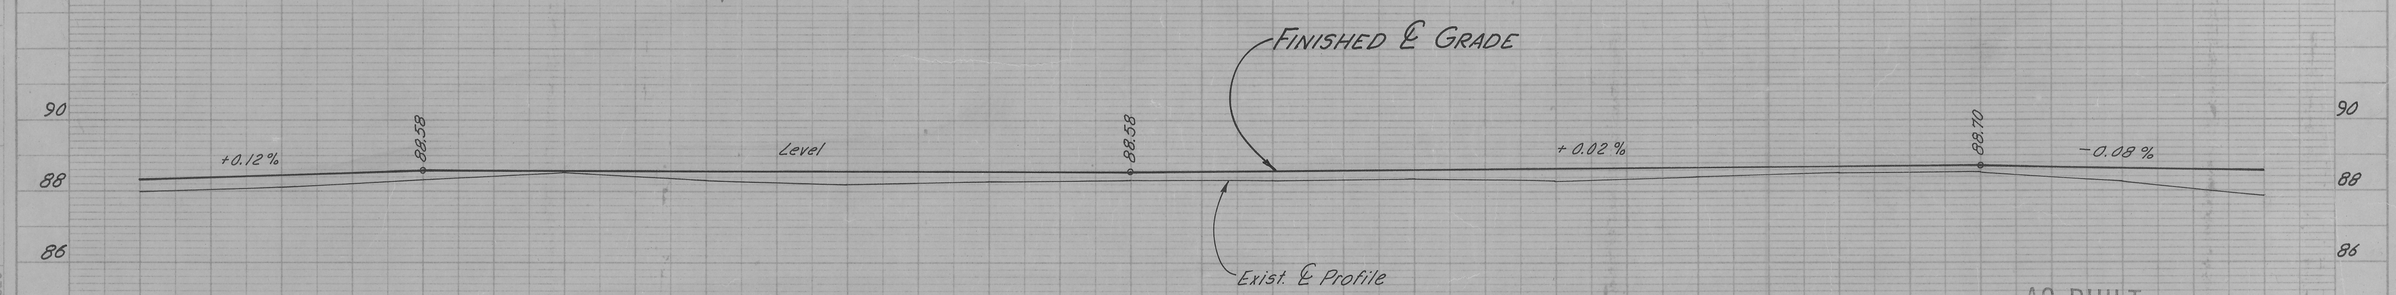

AS BUILT
CORRECTIONS BY R. Hick
NO CHANGES
DATE 6-19-75

Station	20+00	1	2	3	4	5	6	7	8	9	30+00	1	2	3	4	35+00	SHEET TOTAL
Cu. Yds. Emb. Lt.	40	37	32	30	26	25	26	25	22	21	16	12	12	18	28		615
Cu. Yds. Emb. Rt.	1	1	0	5	7	9	6	0	4	9	5	0	0	4	11		134

PROJECT ENGINEER	DATE	CHECKED BY	DATE	SUBMITTED BY	DATE	APPROVAL RECOMMENDED BY	DATE
R. A. Baer	1-75	M. L. Lowe	2-75	Henry Ahrita	3/75	Ford Dwinnigan	3/75

COUNTY OF SAN JOAQUIN

SCALE: HORZ. 1" = 50' VERT. 1" = 2'

PROJECT: EIGHT MILE ROAD

DRAWING NO.

SHEET NO. 3 | TOTAL SHEETS 6

E-394