ROAD NO.	INDEX	FILE NO.	YEAR	SHEET NO.	TOTAL SHEETS

PROFILE X-SEC | PLOTTED BY DM | CHECKED BY DM | DATE 10-74

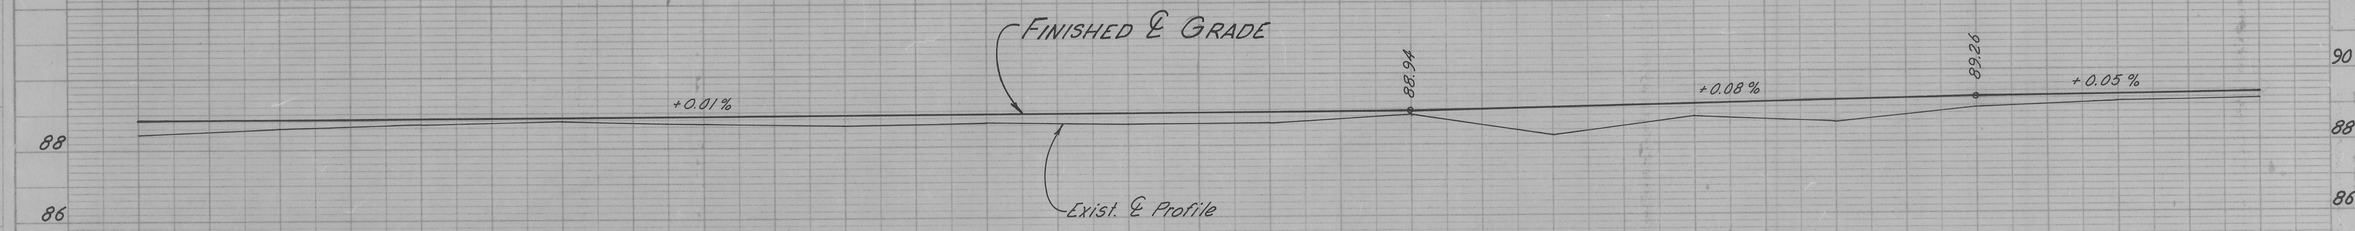

SHEET TOTAL

Station	65+00	6	7	8	9	70+00	1	2	3	4	5	6	7	8	9	80+00
Cu. Yds. Emb. Lt.	14	6	5	14	16	12	16	20	17	19	20	18	18	21	19	
Cu. Yds. Emb. Rt.	14	9	10	15	20	19	25	27	14	13	21	31	36	22	13	

PROFILE X-SEC | PLOTTED BY | CHECKED BY | DATE

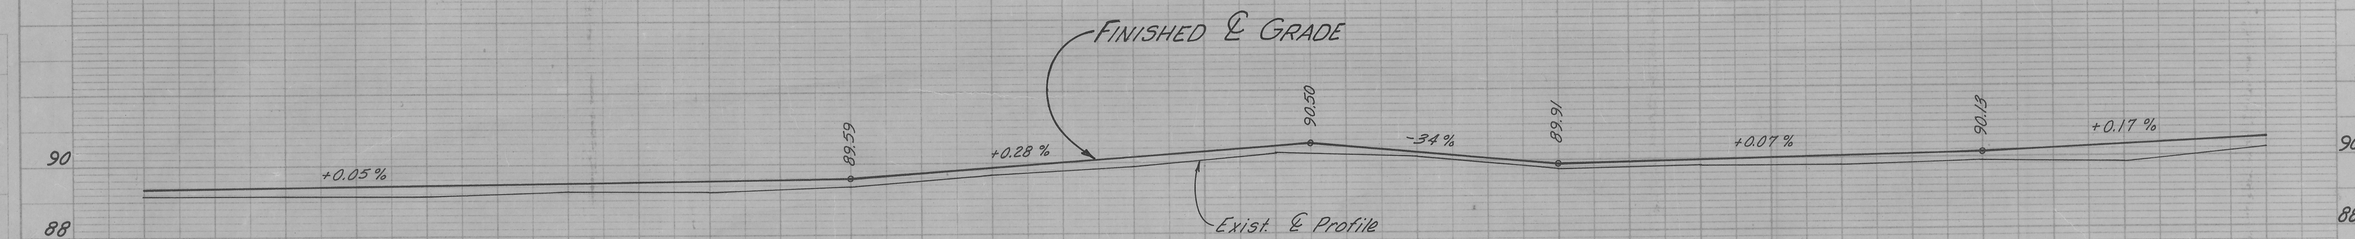

AS BUILT
CORRECTIONS BY
NO CHANGES R. Hick
DATE 6-13-75

SHEET TOTAL

Station	80+00	1	2	3	4	5	6	7	8	9	90+00	1	2	3	4	95+00	
Cu. Yds. Emb. Lt.	14	17	22	24	23	18	12	10	17	25	21	16	16	16	13	499	
Cu. Yds. Emb. Rt.	13	14	18	13	15	19	14	10	10	13	21	28	23	18	17	535	

PROJECT ENGINEER	DATE	CHECKED BY	DATE	SUBMITTED BY	DATE	APPROVAL RECOMMENDED BY	DATE	COUNTY OF SAN JOAQUIN	SCALE: HORZ.- 1" = 50' VERT.- 1" = 2'	PROJECT	EIGHT MILE ROAD	SHEET NO	TOTAL SHEETS
R. A. Baer	1-75	M. L. Lowe	2-75	Henry Ricata	3/75							5	6

E-392