ROAD NO.	INDEX	FILE NO.	YEAR	SHEET NO.	TOTAL SHEETS

PROFILE X-SEC | PLOTTED BY: Om | CHECKED BY: DAR | DATE: 10-74

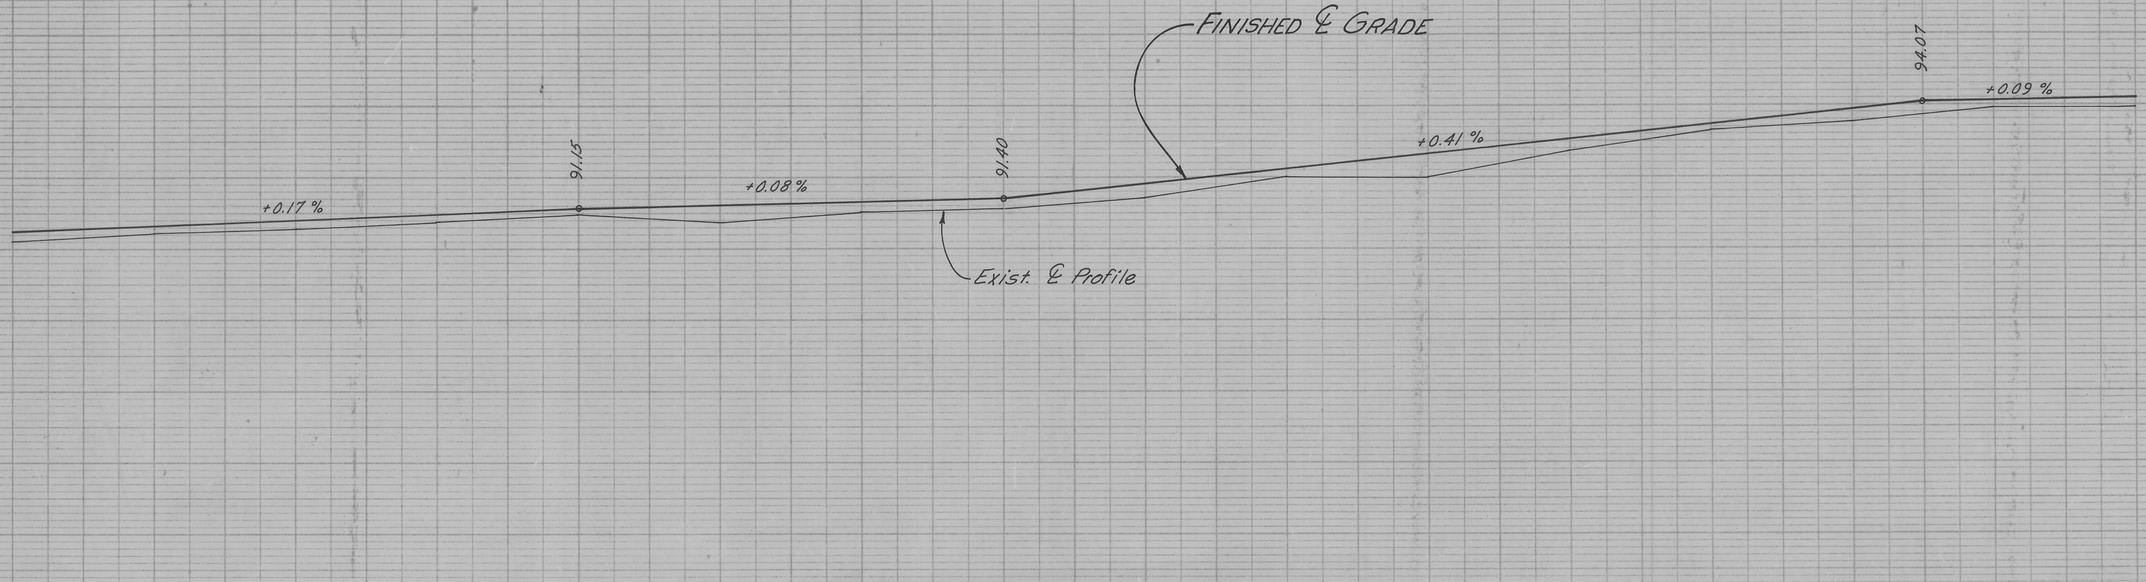

SHEET TOTAL

Station	95+00	6	7	8	9	100+00	1	2	3	4	5	6	7	8	9	110+00
Cu. Yds. Emb. Lt.	11	10	5	0	5	10	6	8	11	7	8	7	7	10	11	
Cu. Yds. Emb. Rt.	14	17	13	13	16	13	8	14	21	13	16	13	0	0	6	

PROFILE X-SEC | PLOTTED BY: | CHECKED BY: | DATE:

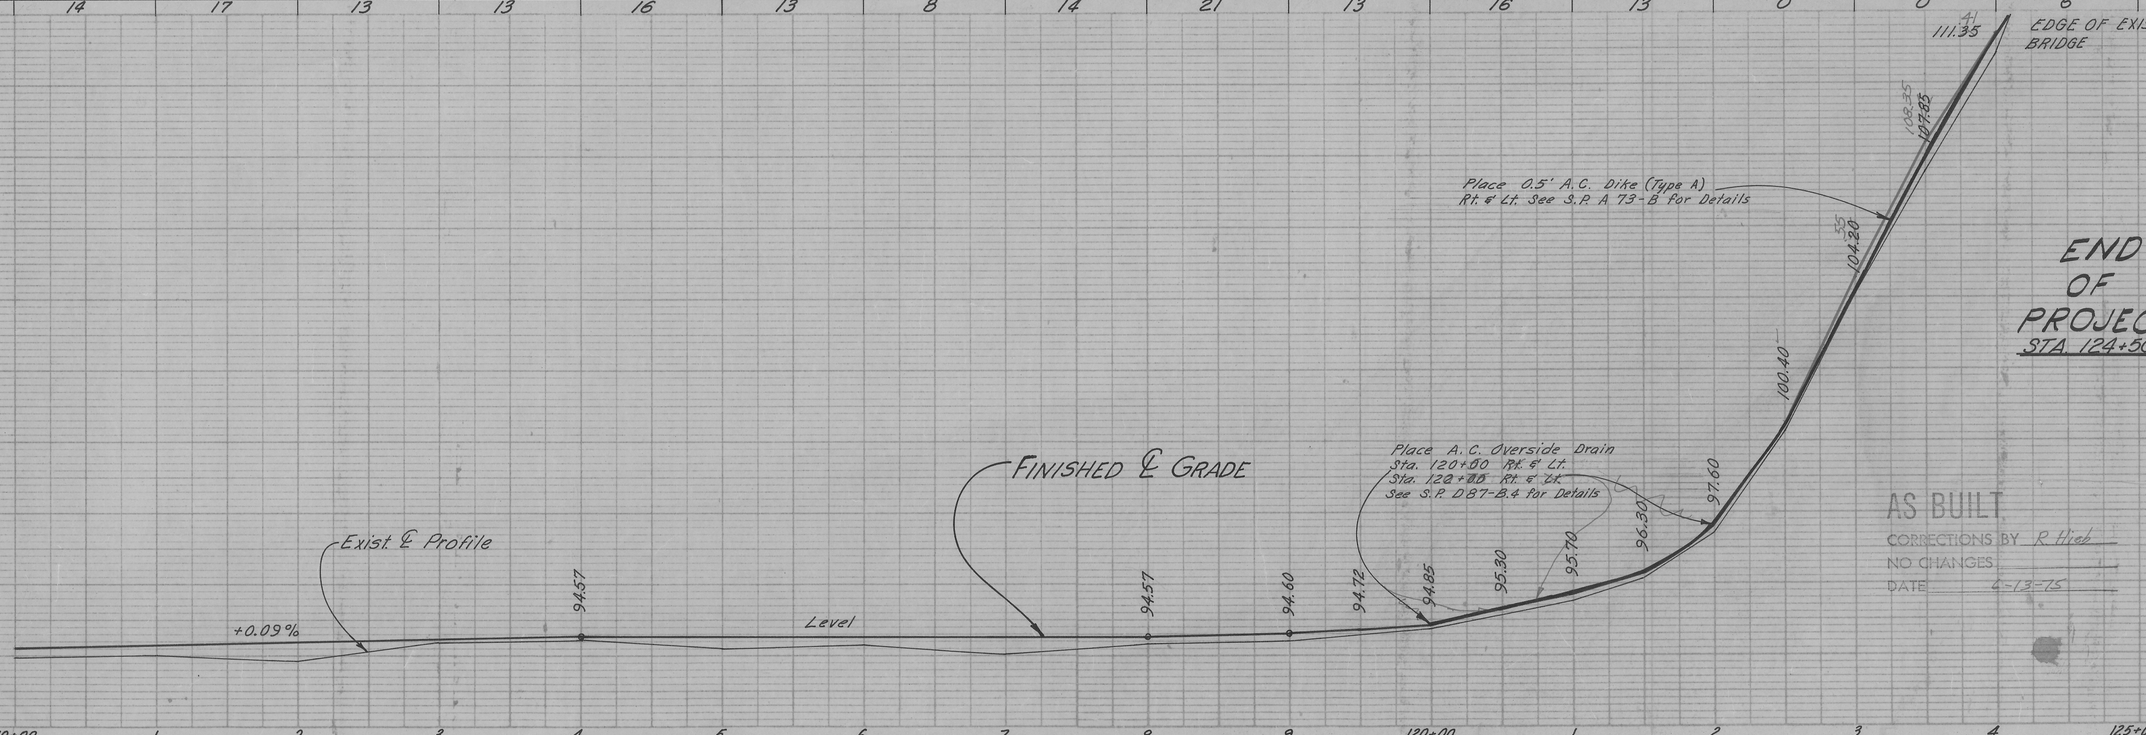

AS BUILT
CORRECTIONS BY R Hieb
NO CHANGES
DATE 4-13-75

SHEET TOTAL | GRAND TOTAL

Station	110+00	1	2	3	4	5	6	7	8	9	120+00	1	2	3	4	125+00		
Cu. Yds. Emb. Lt.	8	11	13	5	5	5	5	11	7	1	1	8	16	18	1	231	1806	
Cu. Yds. Emb. Rt.	8	9	6	0	3	10	14	6	0	0	3	13	25	21	2	297	1285	

PROJECT ENGINEER	DATE	CHECKED BY	DATE	SUBMITTED BY	DATE	APPROVAL RECOMMENDED BY	DATE	COUNTY OF SAN JOAQUIN	SCALE: HORZ. 1"= 50' VERT. 1"= 2'	PROJECT	EIGHT MILE ROAD	SHEET NO.	TOTAL SHEETS
R. S. Carr	1-75	M. L. Lowe 2-75	2-76	Kenneth Kurata	3/75	Tom Dunnigan	3/75					6	6

E-391