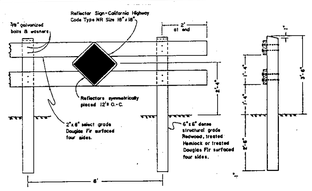

TYPE "A"

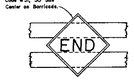

CENTER REFLECTOR
FOR TYPE "A" BARRICADE

NOTES:
1. Barricades to be as wide as street R/W
2. Barricades to be painted white using 2 coats of "Exterior Alkyd Resin Hi-Gloss Enamel" over a compatible primer.

BARRICADES FOR TERMINATING STREETS

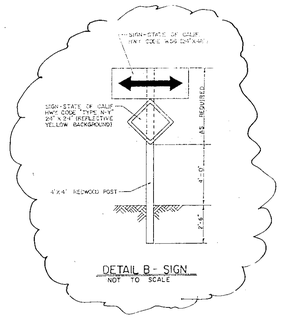

DETAIL B- SIGN
NOT TO SCALE

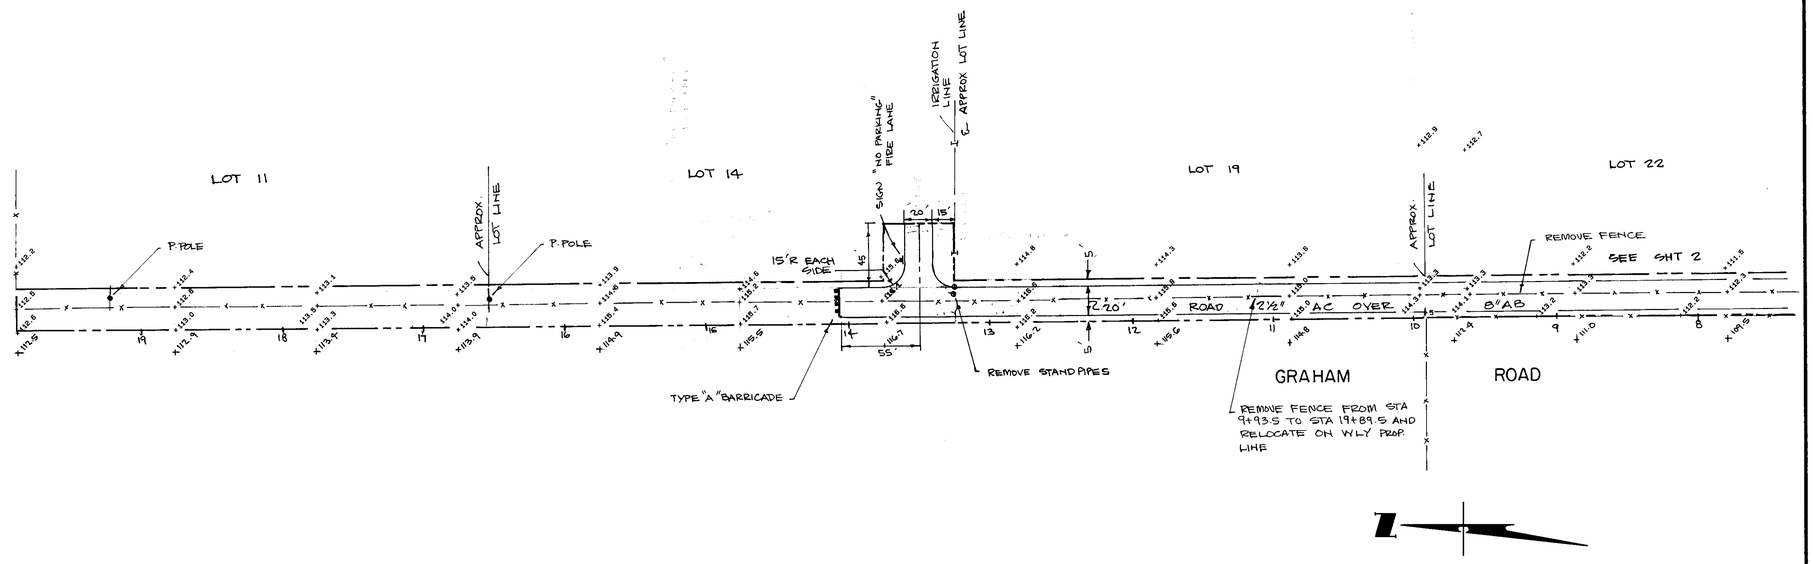

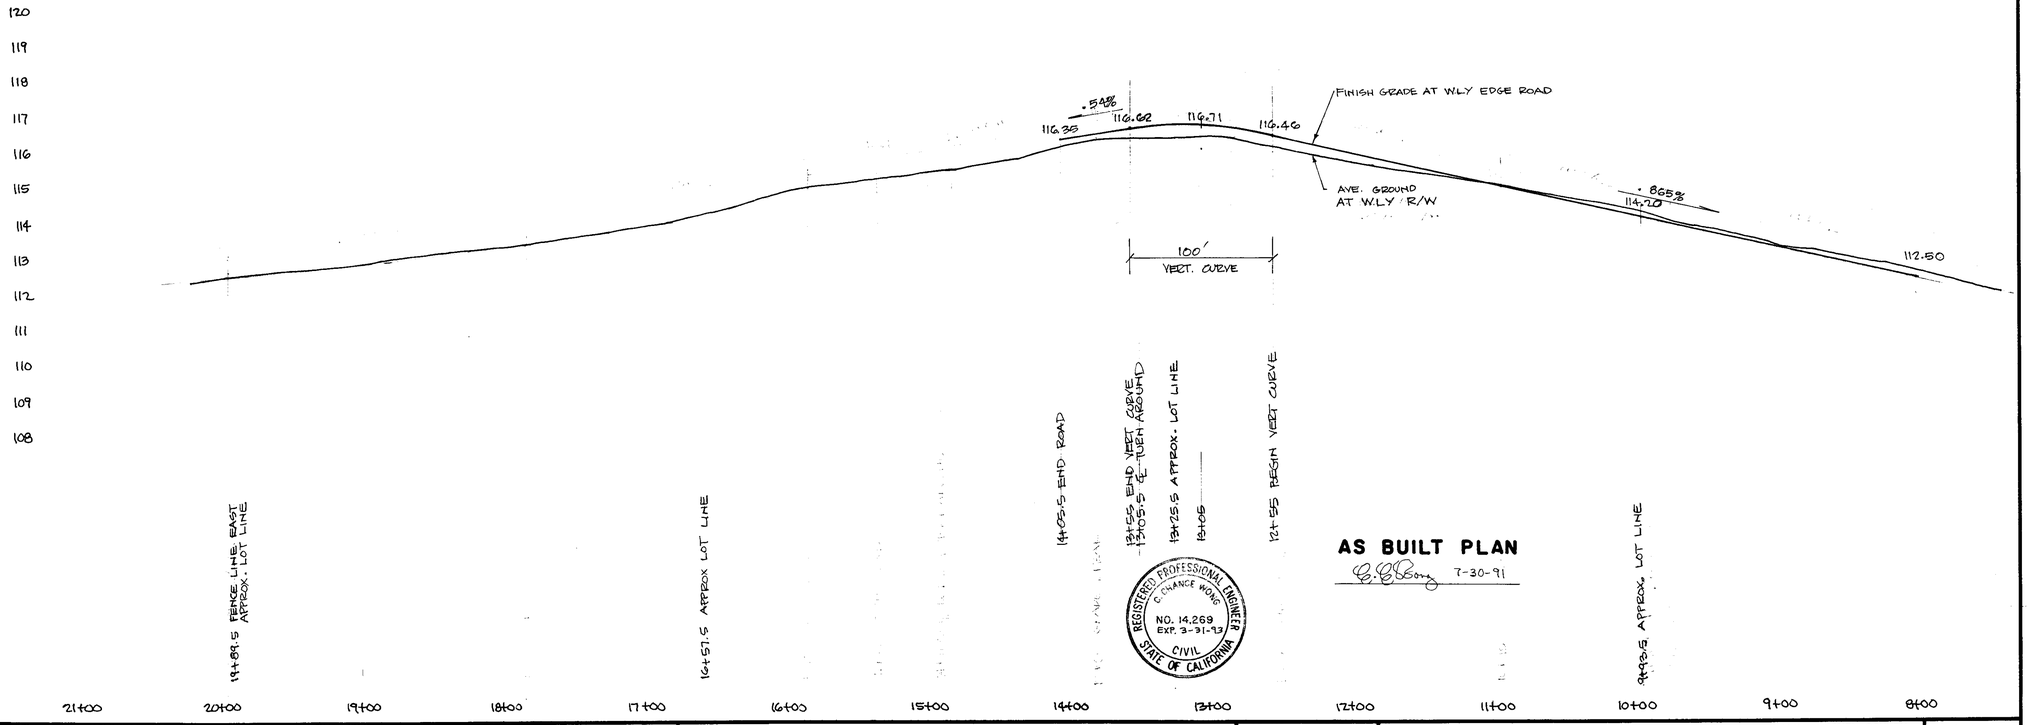

AS BUILT PLAN
C. Chance Wong 7-30-91

REGISTERED PROFESSIONAL ENGINEER
C. CHANCE WONG
NO. 14,269
EXP. 3-31-93
CIVIL
STATE OF CALIFORNIA

APPROVED May 14 1990
Stanley A. Seifert Chief.

APPROVED _____ 19____

HENRY M. HIRATA, DIRECTOR OF PUBLIC WORKS
SAN JOAQUIN COUNTY R.C.E. 21258

REVISIONS			
NO.	DESCRIPTION	DATE	BY
1	RELOCATED ROAD	8-19-91	CW

WONG ENGINEERS, INC.
PLANNING • ENGINEERING • SURVEYING
STOCKTON, CALIFORNIA
C. Chance Wong R.C.E. NO. 14269

JOB. NO.	2695
DATE	DEC. 1989
SCALE HORIZ	1"=50'
SCALE VERT	1"=2'
DRAWN	HAL
DESIGN	WE
CHECK	

LOGAN DEVELOPMENT CO.
SAN JOAQUIN COUNTY, CALIFORNIA

ROAD IMPROVEMENT PLANS
GRAHAM ROAD

SHEET 3 OF 3
FILE

PRINTED ON DIEPO NO. 1000H CLEARPRINT

SJ 2445

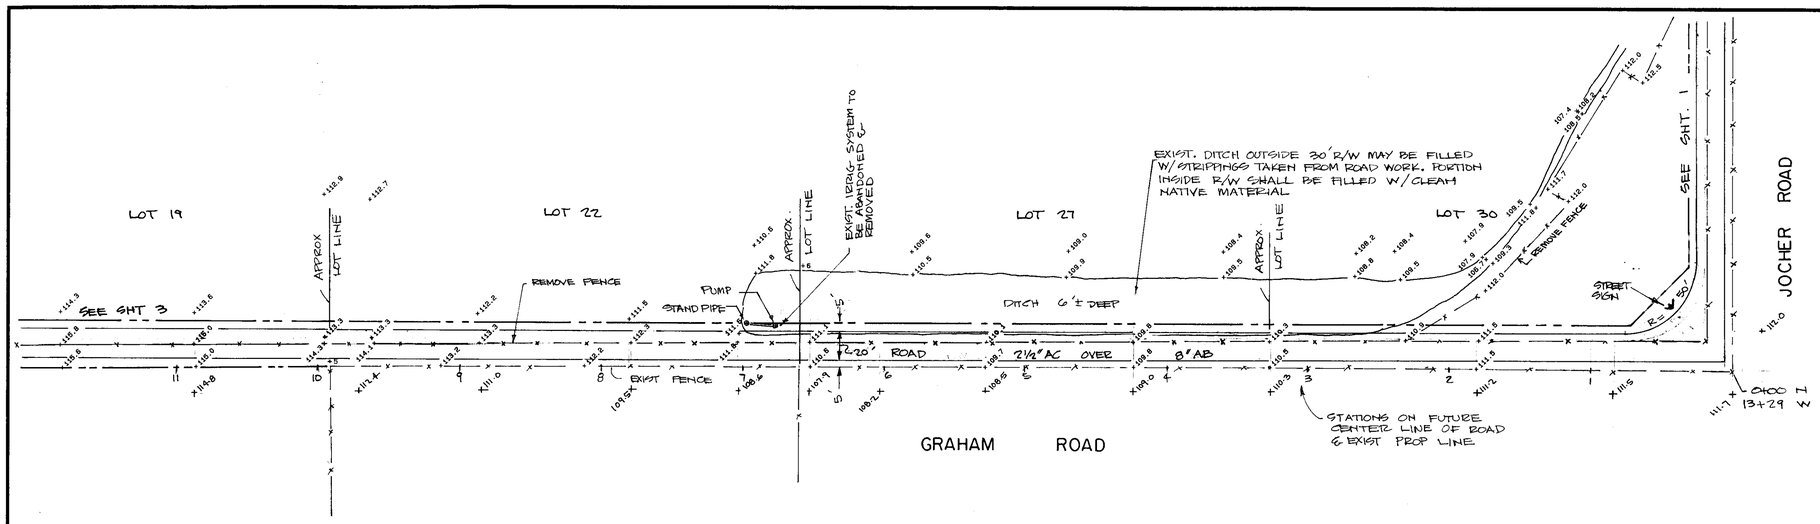

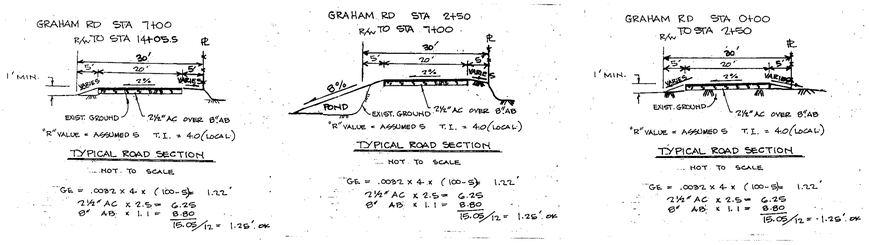

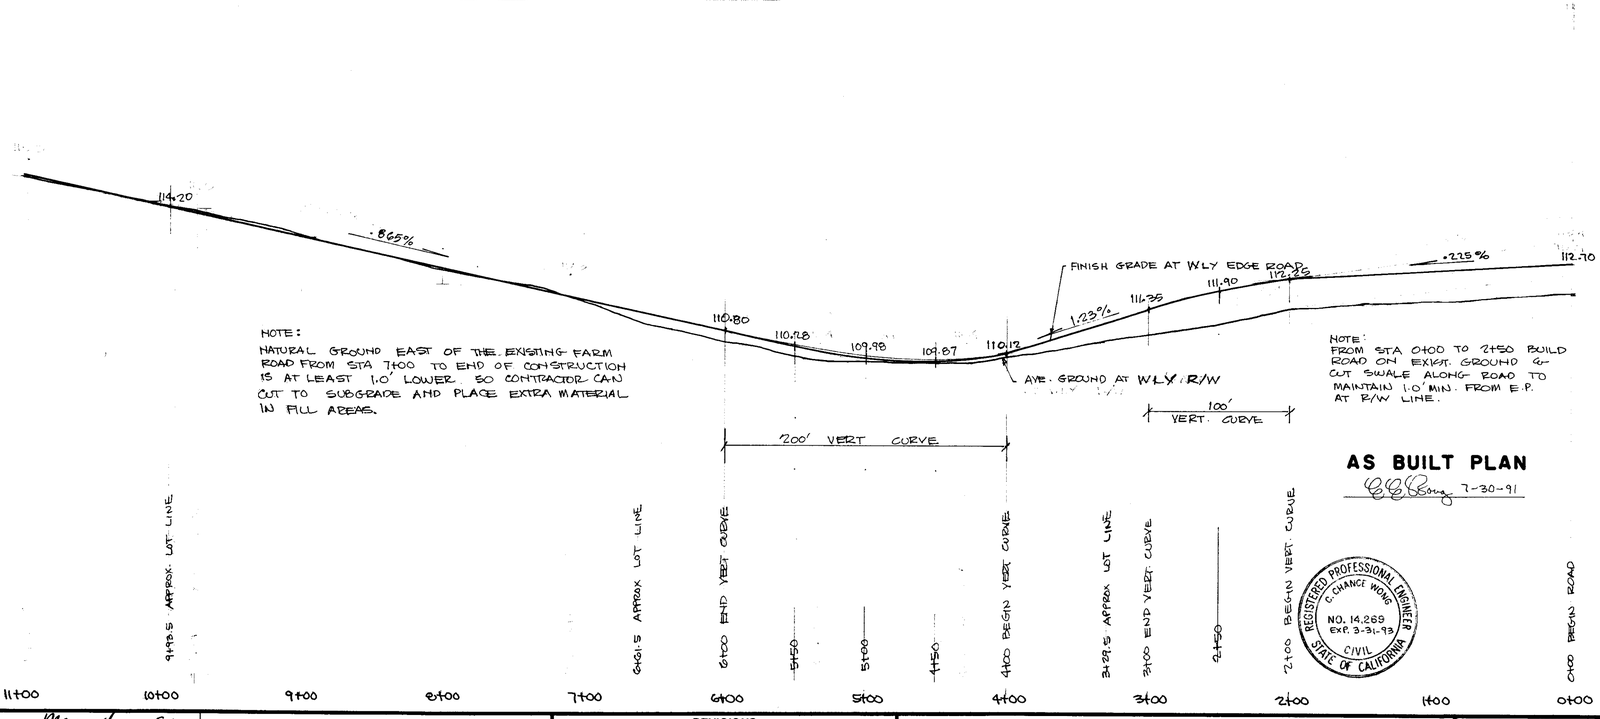

AS BUILT PLAN

C. C. Wong 7-30-91

REGISTERED PROFESSIONAL ENGINEER C. CHANCE WONG NO. 14,269 EXP. 3-31-93 CIVIL STATE OF CALIFORNIA

SU 24446

APPROVED May 14 1990
Stanley D. Sujert, Chief.

APPROVED _____ 19____

HENRY M. HIRATA, DIRECTOR OF PUBLIC WORKS
SAN JOAQUIN COUNTY R.C.E. 21258

REVISIONS			
NO.	DESCRIPTION	DATE	BY
1	RELOCATED ROAD	3-19-91	RP

WONG ENGINEERS, INC.
PLANNING • ENGINEERING • SURVEYING
STOCKTON, CALIFORNIA
C. Chance Wong R.C.E. NO. 14269

JOB. NO.	2695
DATE	DEC. 1989
SCALE HORIZ	1"=50'
SCALE VERT	1"=2'
DRAWN	HAL
DESIGN	WE
CHECK	

LOGAN DEVELOPMENT CO.

SAN JOAQUIN COUNTY, CALIFORNIA

ROAD IMPROVEMENT PLANS
GRAHAM ROAD

SHEET 2 OF 3

FILE

PRINTED ON DIEPO NO. 1000H CLEARPRINT

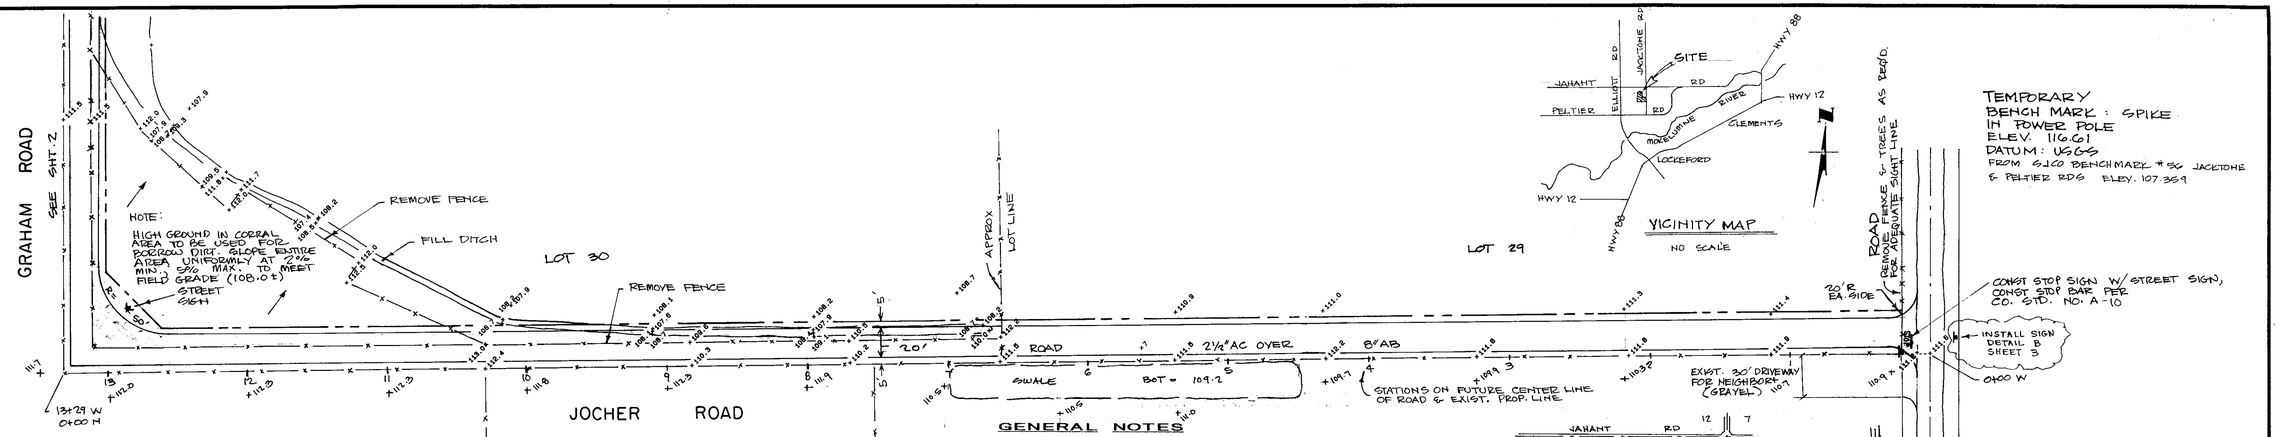

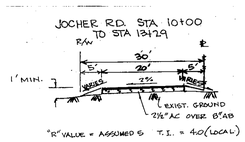

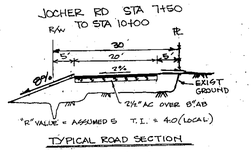

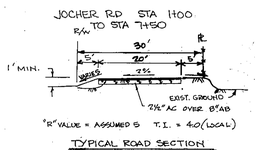

GENERAL NOTES

1. CONTRACTOR SHALL ASSUME SOLE AND COMPLETE RESPONSIBILITY FOR JOB SITE CONDITIONS DURING THE COURSE OF CONSTRUCTION OF THIS PROJECT, INCLUDING SAFETY FOR ALL PERSONS AND PROPERTY; THAT THIS REQUIREMENT SHALL APPLY CONTINUOUSLY AND NOT BE LIMITED TO NORMAL WORKING HOURS AND THAT CONTRACTOR SHALL DEFEND, INDEMNIFY, AND HOLD THE OWNER, SAN JOAQUIN COUNTY AND ENGINEER HARMLESS FROM ANY AND ALL LIABILITY, REAL OR ALLEGED, IN CONNECTION WITH THE PERFORMANCE OF WORK ON THIS PROJECT.
2. PRIOR TO PERFORMING ANY WORK WITHIN THE ROAD RIGHT-OF-WAY, THE CONTRACTOR SHALL OBTAIN A ENCROACHMENT PERMIT FROM THE SAN JOAQUIN COUNTY DEPARTMENT OF PUBLIC WORKS.
3. CONTRACTOR SHALL OBTAIN A GRADING PERMIT FROM THE SAN JOAQUIN COUNTY BUILDING DIVISION.
4. ALL TRAFFIC SIGNS AND MARKINGS SHALL CONFORM TO THE "MANUAL OF UNIFORM TRAFFIC CONTROL DEVICES AND SAN JOAQUIN CO. STANDARDS.
5. ALL COMPACTION TESTS, AND MATERIAL SAMPLING AND TESTING SHALL BE THE RESPONSIBILITY OF THE DEVELOPER.
6. ANY CHANGES ON THE APPROVED IMPROVEMENT PLANS AND SPECIFICATIONS MUST BE PREPARED AND CERTIFIED BY THE "CIVIL ENGINEER", AND SHALL BE SUBMITTED TO THE DIRECTOR OF PUBLIC WORKS FOR APPROVAL PRIOR TO IMPLEMENTATION.
7. NO SERVICES ARE REQUIRED FOR THESE ROAD IMPROVEMENTS.
8. ALL DRIVEWAYS OVER 150 FEET LONG SHALL BE 20 FEET WIDE, ALL WEATHER, WITH ADEQUATE TURN AROUND.
9. CONTRACTOR AGREES THAT HE SHALL ASSUME SOLE AND COMPLETE RESPONSIBILITY FOR JOB SITE CONDITIONS DURING THE COURSE OF CONSTRUCTION OF THIS PROJECT, INCLUDING SAFETY OF ALL PERSONS AND PROPERTY; THAT THIS REQUIREMENT SHALL APPLY CONTINUOUSLY AND NOT BE LIMITED TO NORMAL WORKING HOURS; AND THAT THE CONTRACTOR SHALL DEFEND, INDEMNIFY AND HOLD HARMLESS, THE COUNTY OF SAN JOAQUIN, ITS ELECTED OFFICIALS, OFFICERS, EMPLOYEES, AND AGENTS FROM ANY AND ALL CLAIMS, COSTS OF LITIGATION, DAMAGES AND ATTORNEY'S FEES, WHICH ARE CLAIMED TO HAVE OCCURRED DURING THE TERM OF THIS PROJECT.

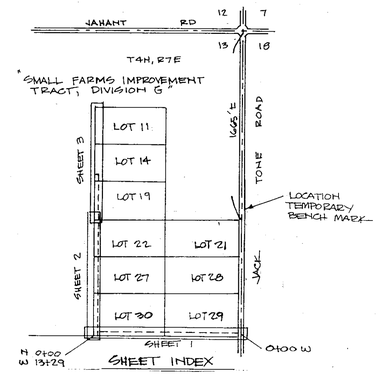

NOTE: JOCHER ROAD AND GRAHAM ROAD ARE NOT TO BE ACCEPTED FOR MAINTENANCE UNTIL THEY ARE WIDENED TO MEET THE MINIMUM SAN JOAQUIN COUNTY STANDARDS FOR FARM OR ESTATE TYPE STREETS.

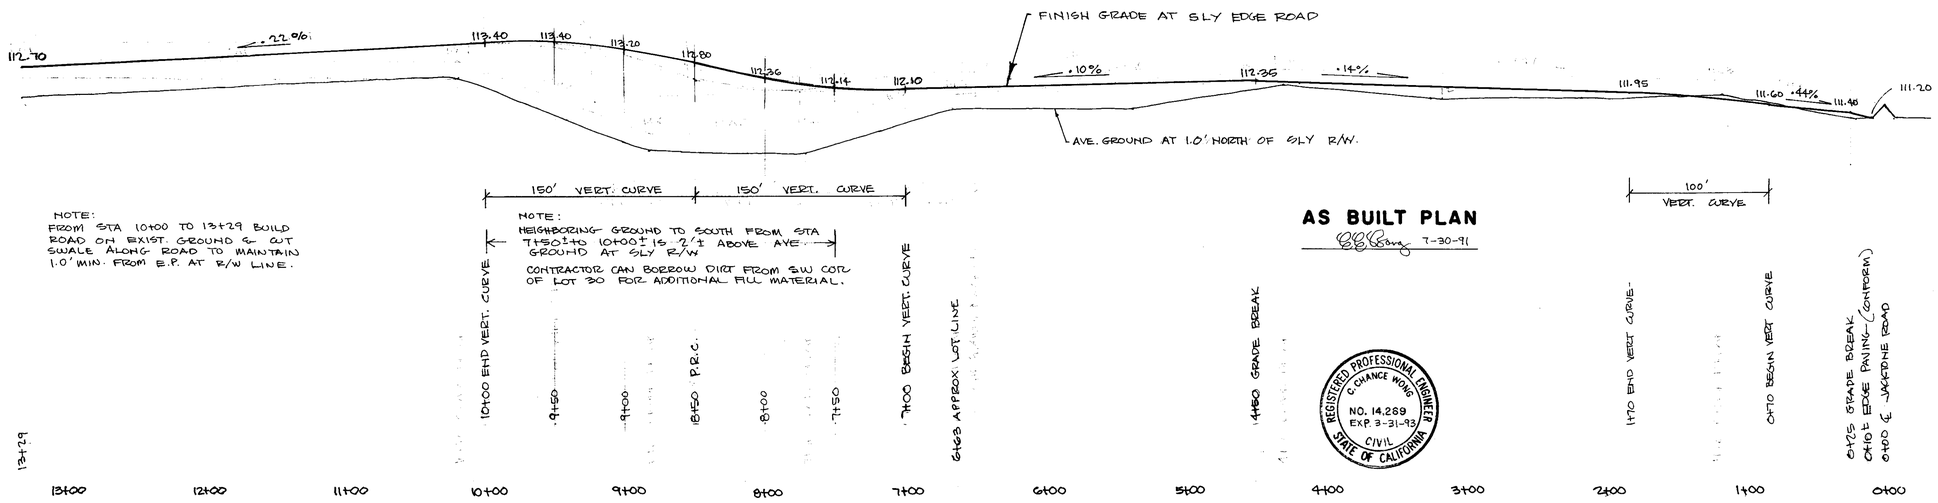

AS BUILT PLAN
C. Chance Wong 7-30-91

REGISTERED PROFESSIONAL ENGINEER C. CHANCE WONG NO. 14,269 EXP. 3-31-93 CIVIL STATE OF CALIFORNIA

APPROVED May 14 1990	APPROVED April 12 1991	REVISIONS			
Stanley D. Siegert Chief	for HENRY M. HIRATA, DIRECTOR OF PUBLIC WORKS	NO.	DESCRIPTION	DATE	BY
LIBERTY FIRE DISTRICT	SAN JOAQUIN COUNTY R.C.E. 21258	1	RELOCATED ROAD	3-19-91	RD

WONG ENGINEERS, INC.
PLANNING • ENGINEERING • SURVEYING
STOCKTON, CALIFORNIA
C. Chance Wong R.C.E. NO. 14269

JOB. NO.	2695
DATE	APR. 1990
SCALE HORIZ	1"=50'
SCALE VERT	1"=2'
DRAWN	HAL
DESIGN	WE
CHECK	

LOGAN DEVELOPMENT CO.
SAN JOAQUIN COUNTY, CALIFORNIA
ROAD IMPROVEMENT PLANS
JOCHER ROAD

SHEET 1 OF 3
FILE

SU 2447

PRINTED ON DIEPO NO. 1000H CLEARPRINT